

WOOD GUIDE POSTS REQUIRED

Sta	Lt	Rt
76+61	1	1

CABLE GUARD RAIL REQUIRED

Sta	Sta	Lt	Long	Cont	Pay Long
66+76	68+74	L	48	40	88
68+26	68+74	R	48	40	88



REINFORCED CONCRETE PIPE CULVERTS REQUIRED

Sta	Diam	Leag	Cont H	C.R.M.	Steel
76+69	18"	44'		3.5%	

STD UNDERDRAIN WITH 6" PERFORATED C.G.M. PIPE (COATED)

Sta	To Sta	R.Lt	Length	C.R.M.
66+0	68+0	E	200'	
70+0	74+25	E	425'	

134-L-1932-9-90

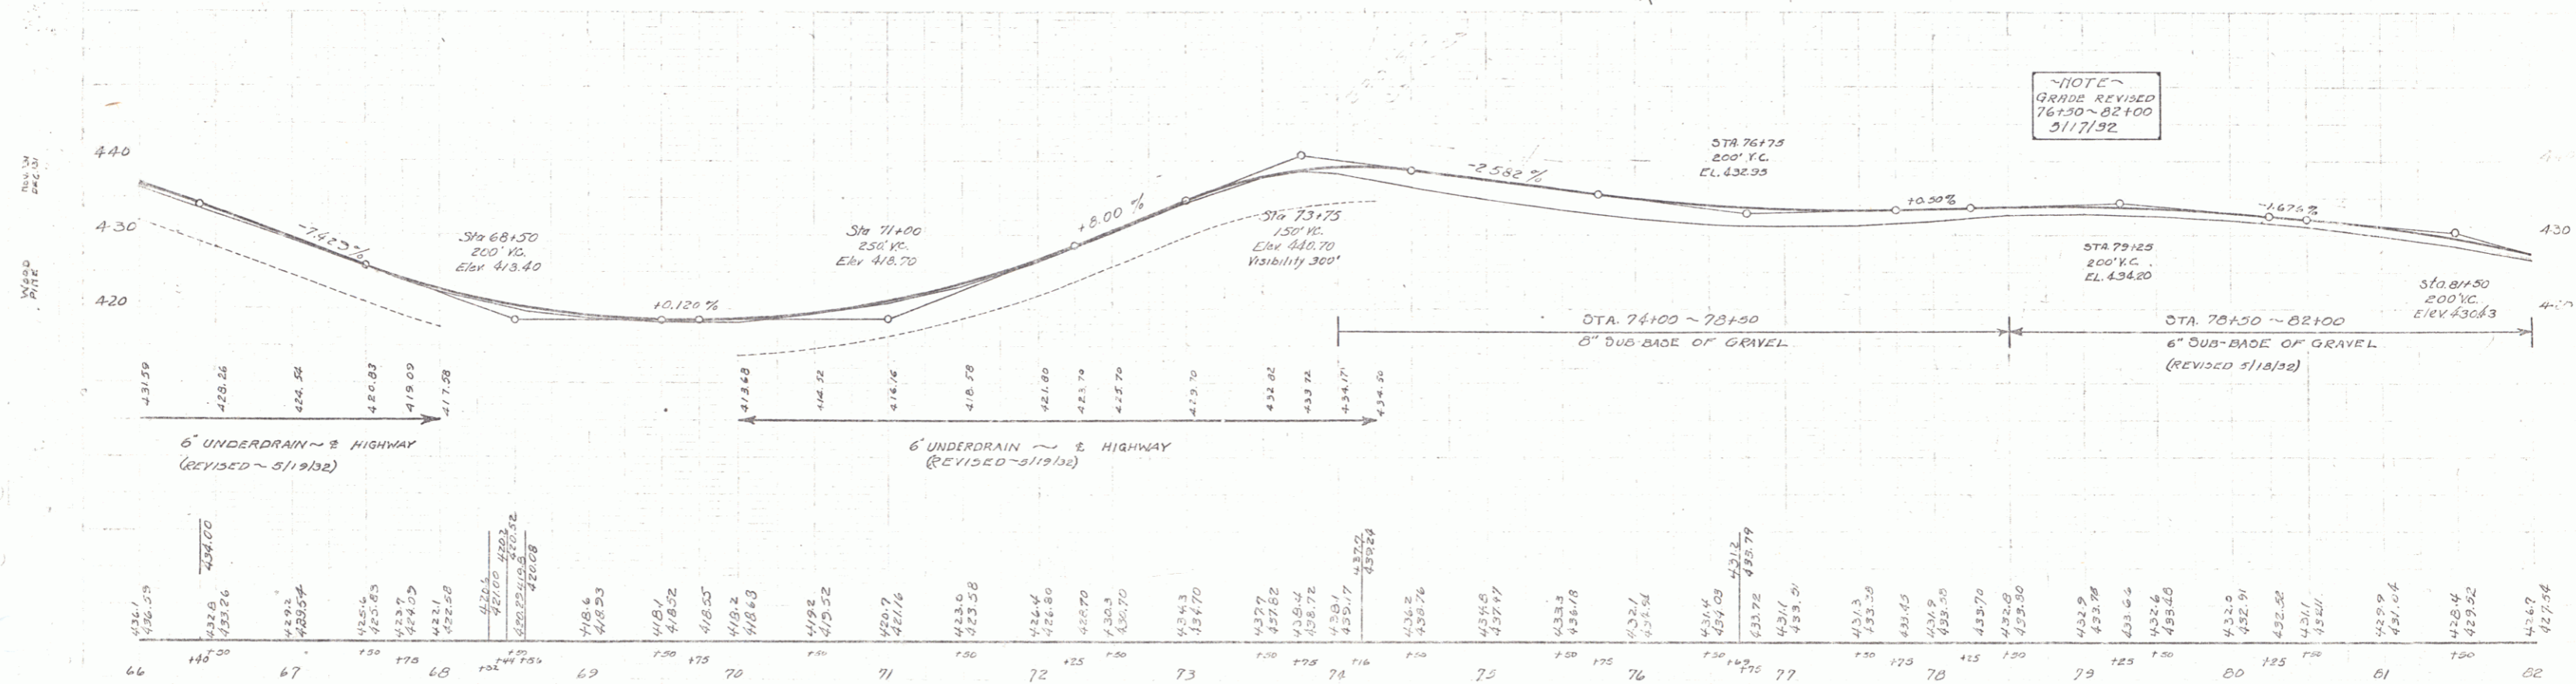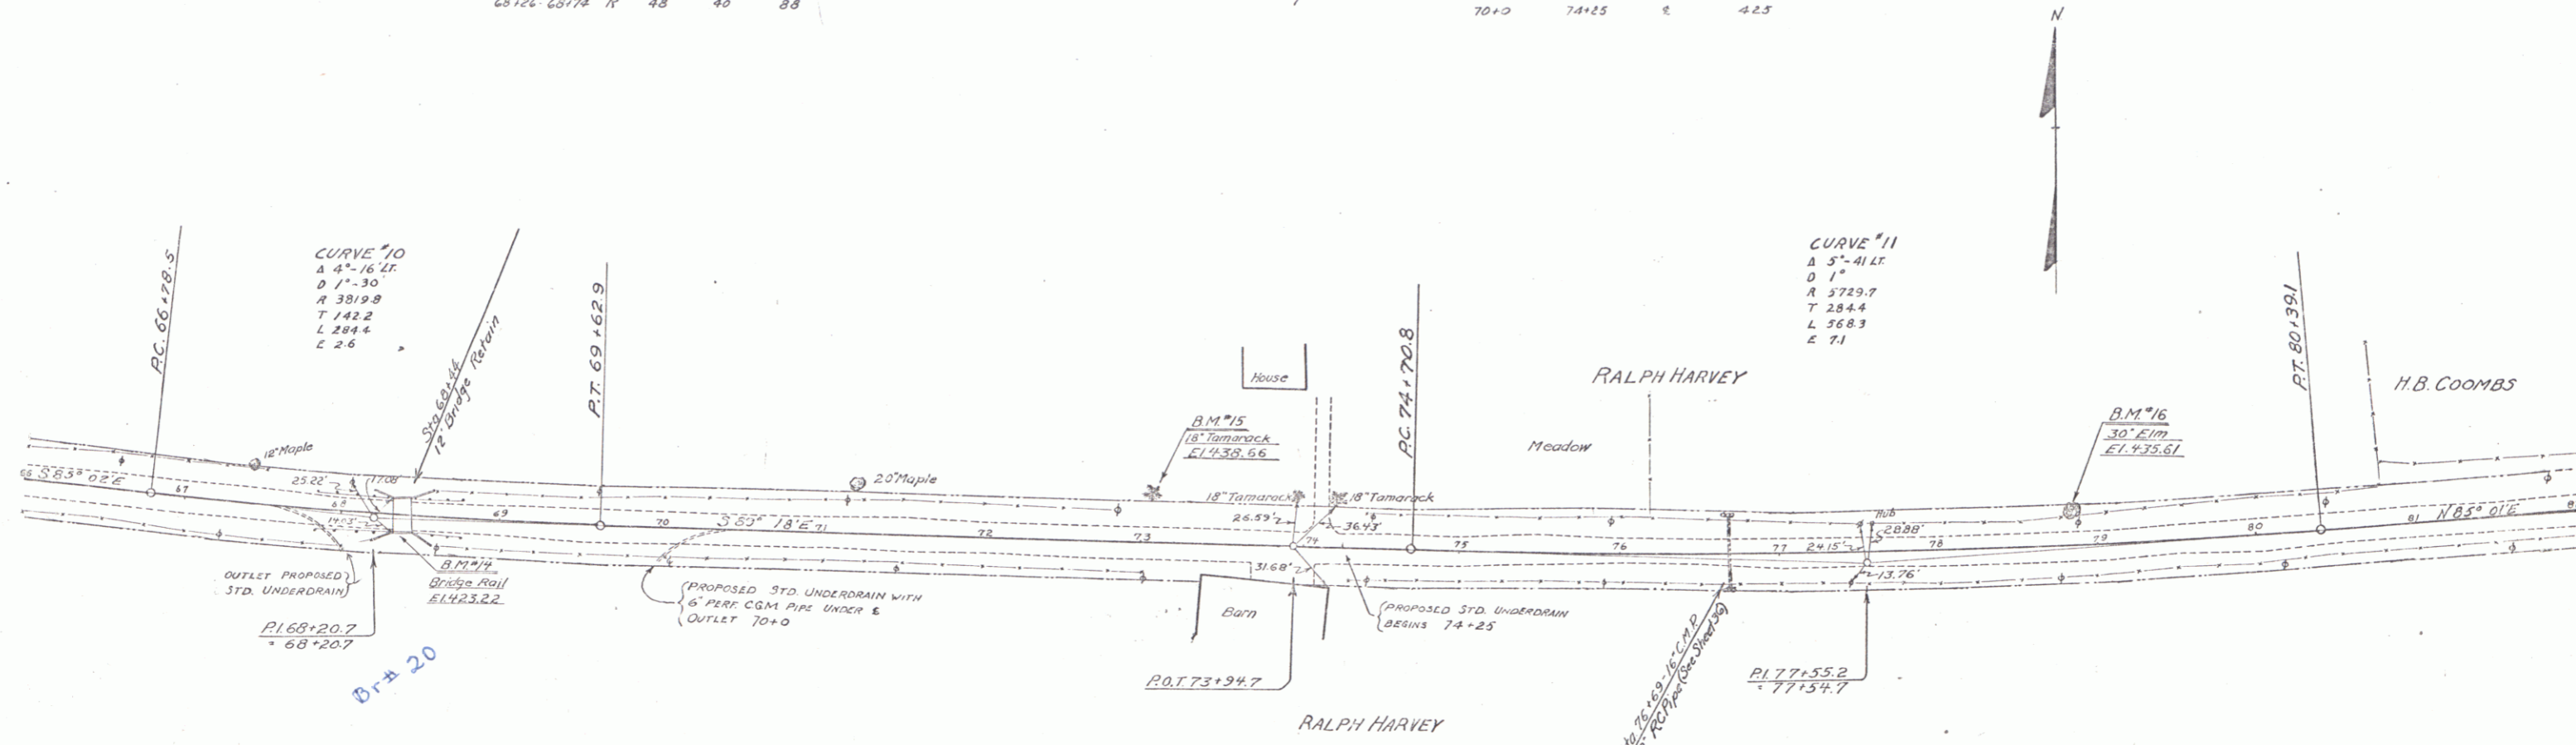

B.M. 14 Point Spot on Conc. Bridge Rail 11.5' Ft. Sta. 68+74 Elev. 423.22
 B.M. 15 Spike in Root of Tamarack 29' Lt. Sta. 73+07 Elev. 438.66
 B.M. 16 " " " 30' Elm 18.5' Lt. Sta. 75+84 Elev. 435.61

SERIES F No. 134-L
 SHEET 9 OF 70