



GUIDE POSTS OF WOOD REQUIRED		
SECTION	LEFT	RIGHT
110+83	1	1

GABLE GUARD RAIL REQUIRED				
STA. TO STA.	LOAR	LENG	CONST	PILENG
102+23-102+77	RT	48	40	88
102+23-102+77	RT	48	40	88

REINFORCED CONCRETE PIPE CULVERTS			
STATION	SIZE	LENG	CONCR
102+03	14"	41'	27'

CULVERT REPAIRS			
STATION	TYPE	EXTENS	REINFORC
110+83	12" RC	20'	3" RT

134-L 1932 11 90

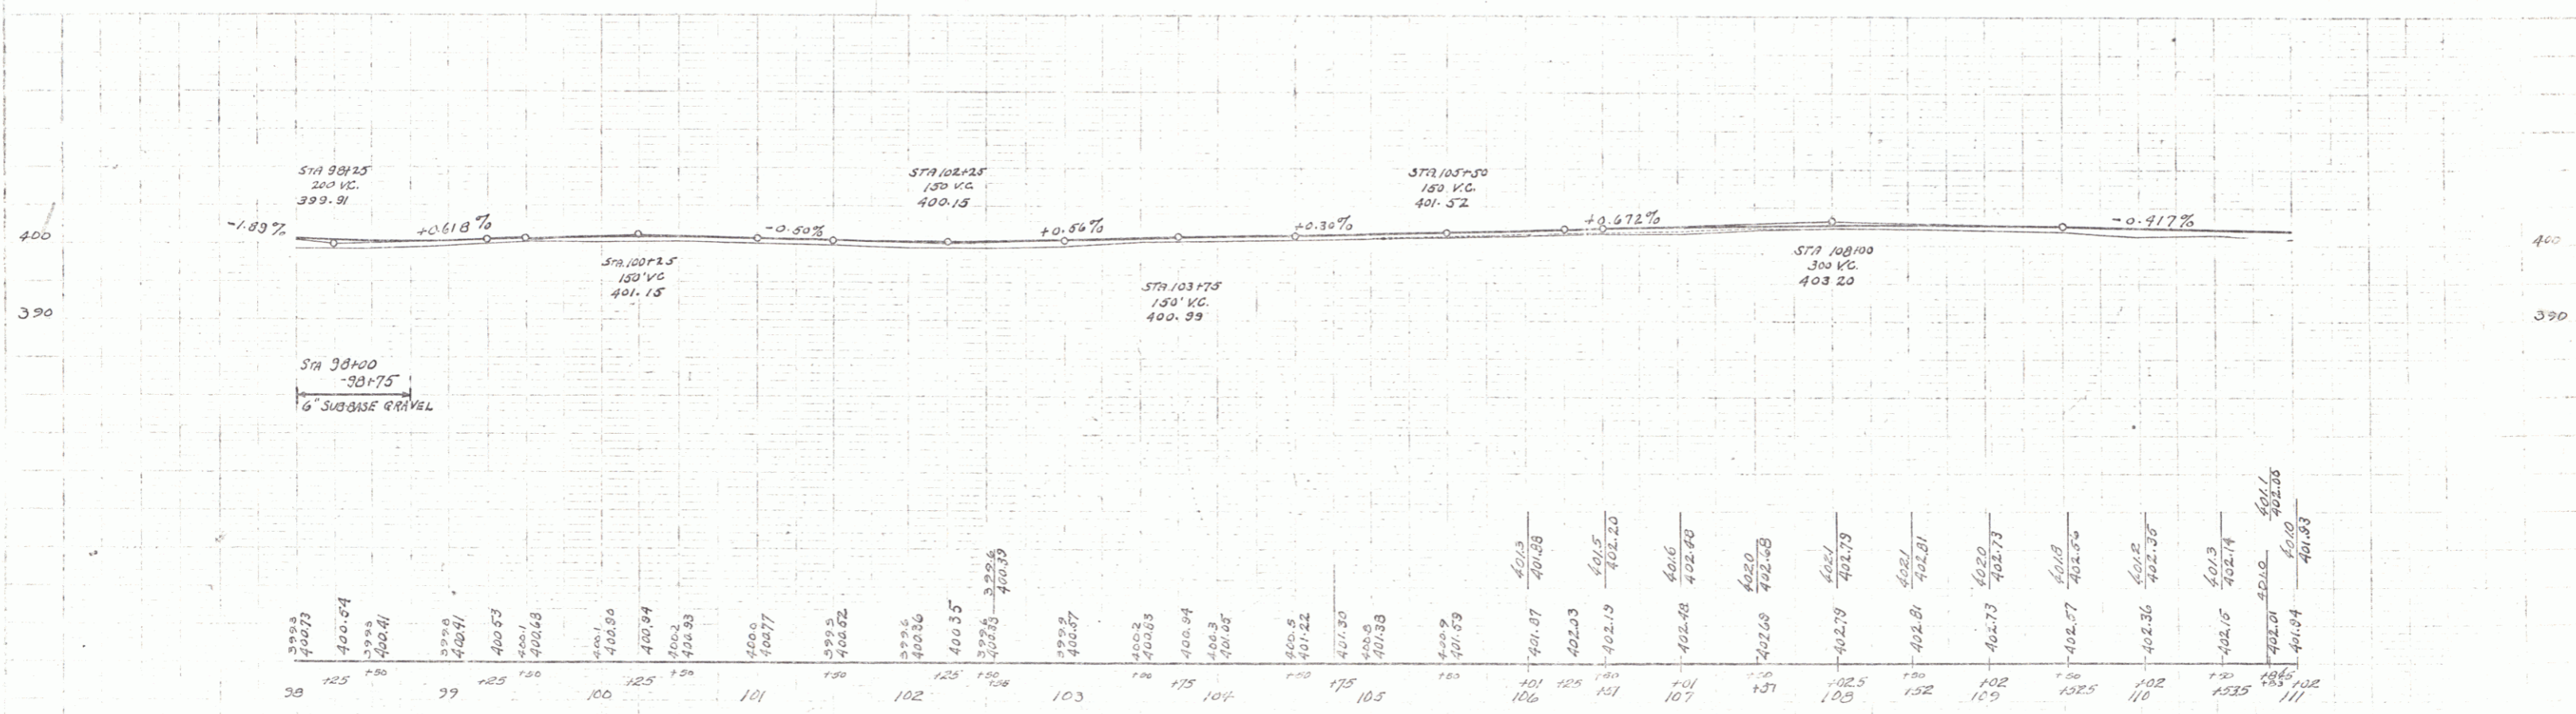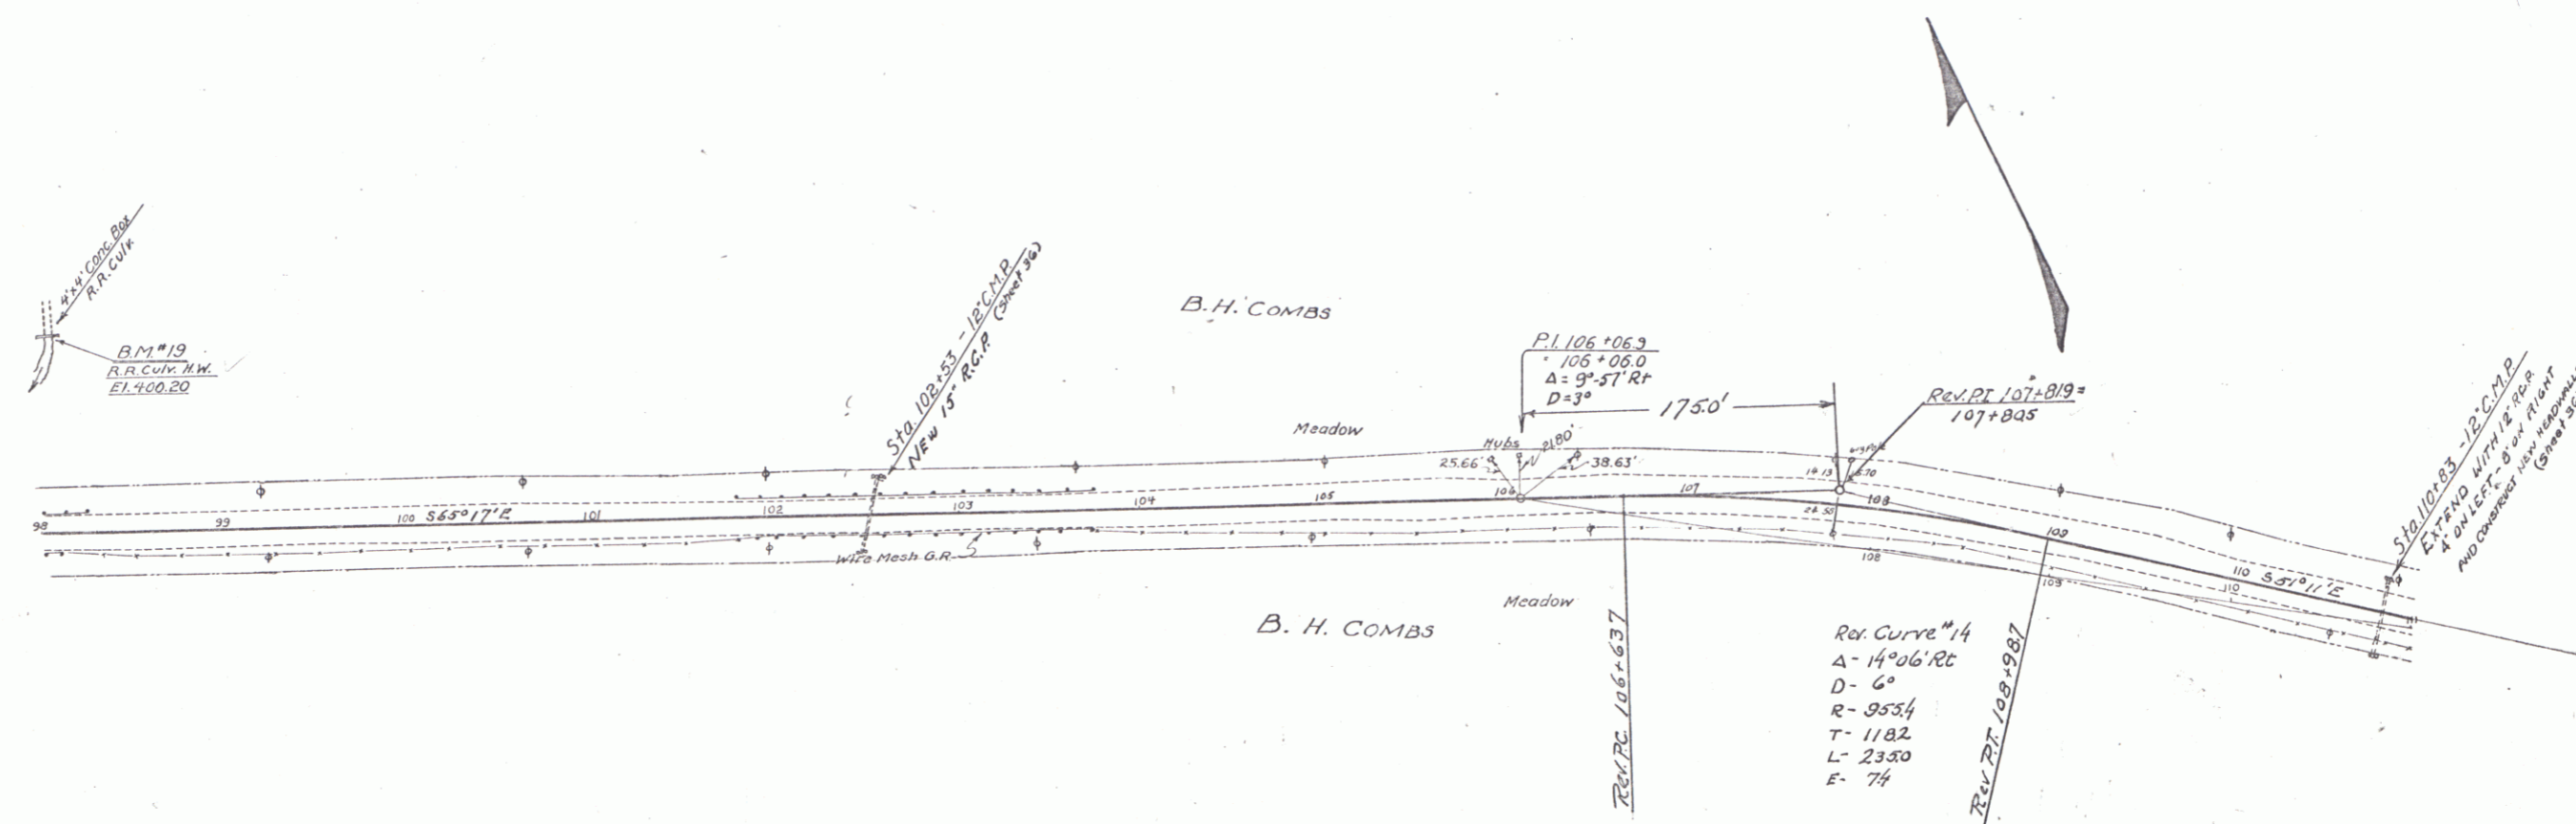

B.M. #19 Point Spot on R.R. culv. Headwall 103' Lt. Sta. 98+10 El. 400.20

SERIES F 16134-1  
SHEET 11 OF 20