
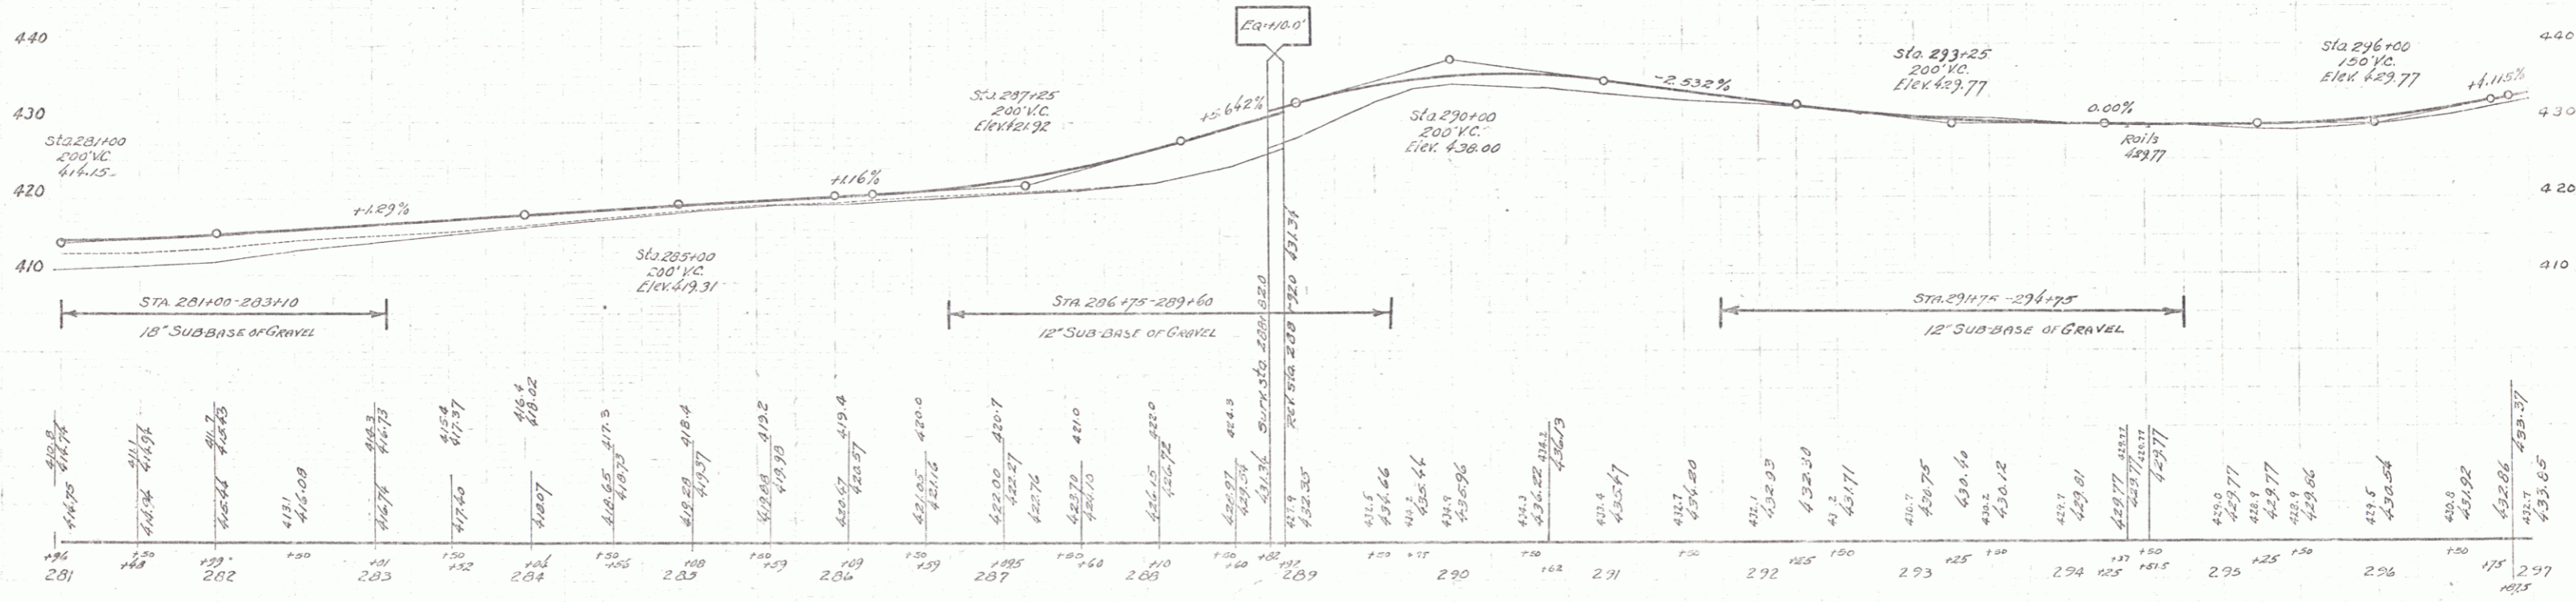


Parcel	Kind of Instrument	Date of Grant	Grantor	Grantee	Recorded Book Page	Remarks
D	Q.C.D.	7-13-32	H.A. Pond	St. of W.	33 113	8-19-32

CULVERT REPAIRS			
STATION	TYPE	REPAIRS CONC. R.	SLINE STEEL
295+27	J-31	CONC. RISE DATE 2.0 CX	100"
		SEE HEADWALLS	

134-L 1932 23 90

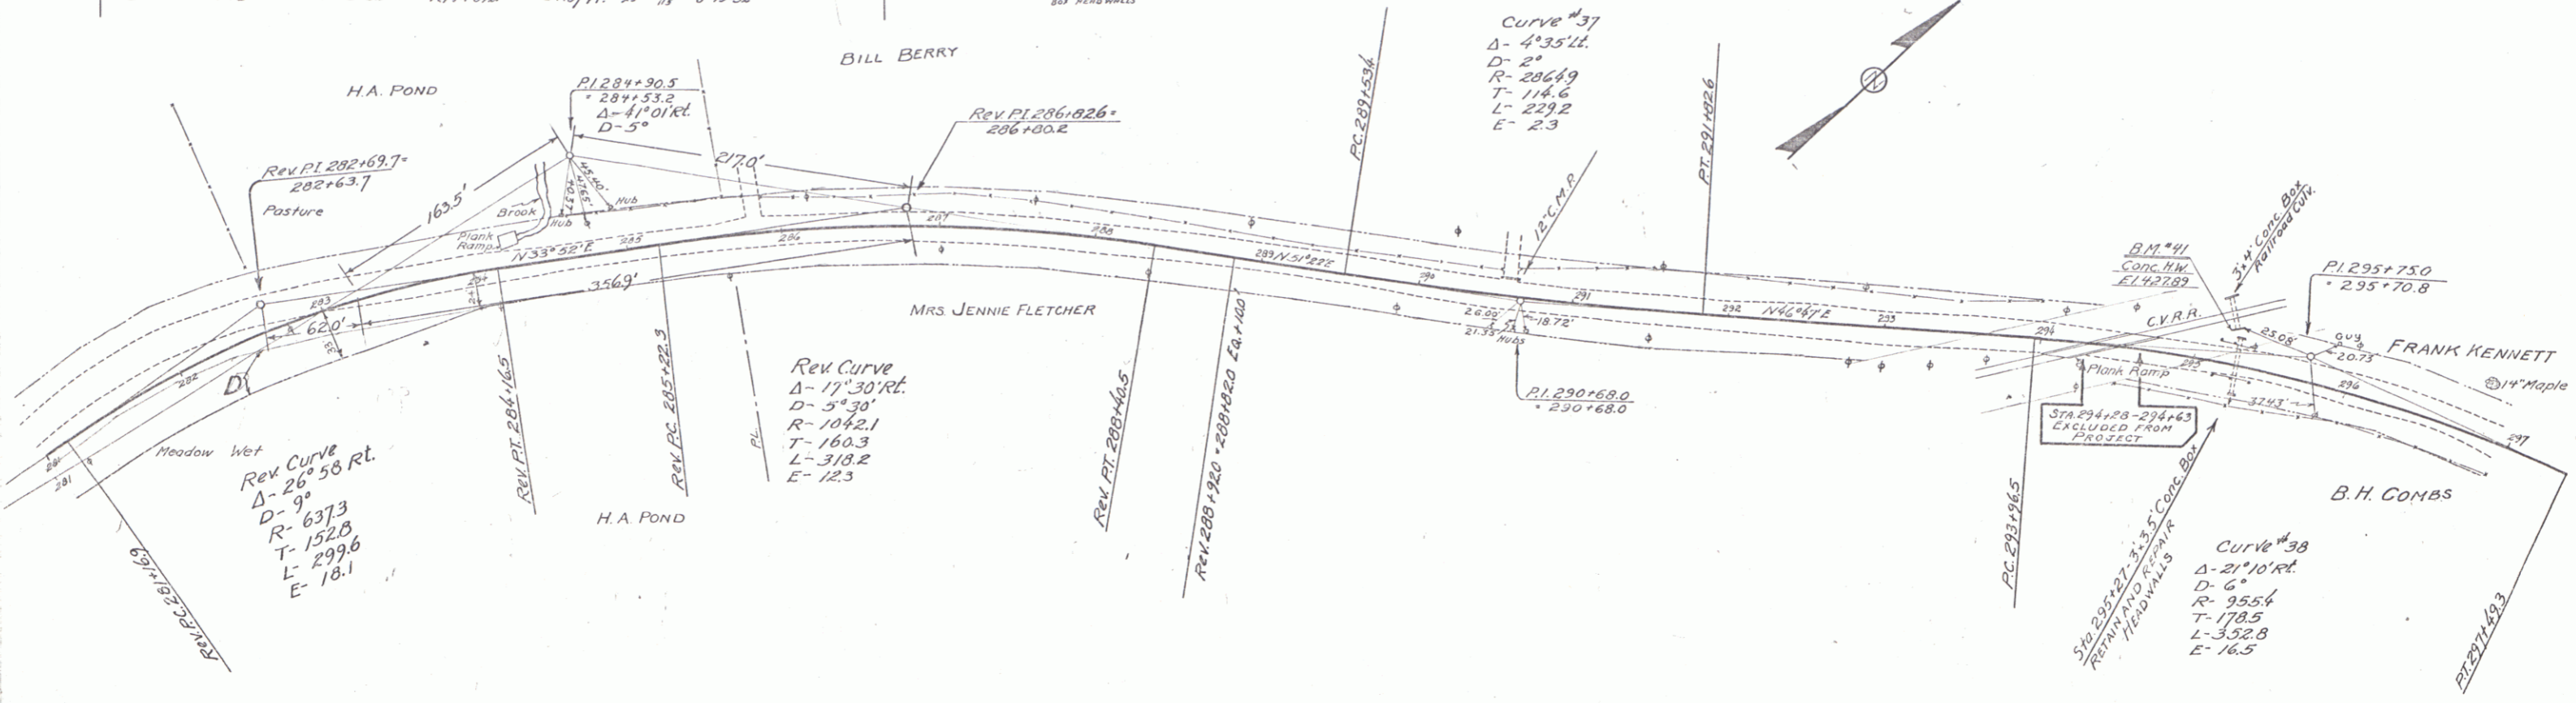

B.M. #41 PAINT SPOT ON CONC. HEADWALL OF A.R. CULV. 41 FT. LT. STA. 295+20 ELEV. 427.89

Series F No. 134-L
 Sheet 23 of 90
 see Berkshire
 F-Fl 04-1 (U)
 21