

GUIDE POSTS OF WOOD

STATION	LEFT	RIGHT
388+79	1	1



CABLE GUARD RAIL

STA. TO STA.	LEN	CONST	AV. LEN
384+62-385+10	48'	40'	58'
384+50-384+38	12'	40'	58'

REINFORCED CONCRETE PIPE CULVERTS

STATION	SIZE	LENS	CONC. CR.	MIN. STRENGTH
384+79	24"	48"	54"	54"

134-L 1932 23

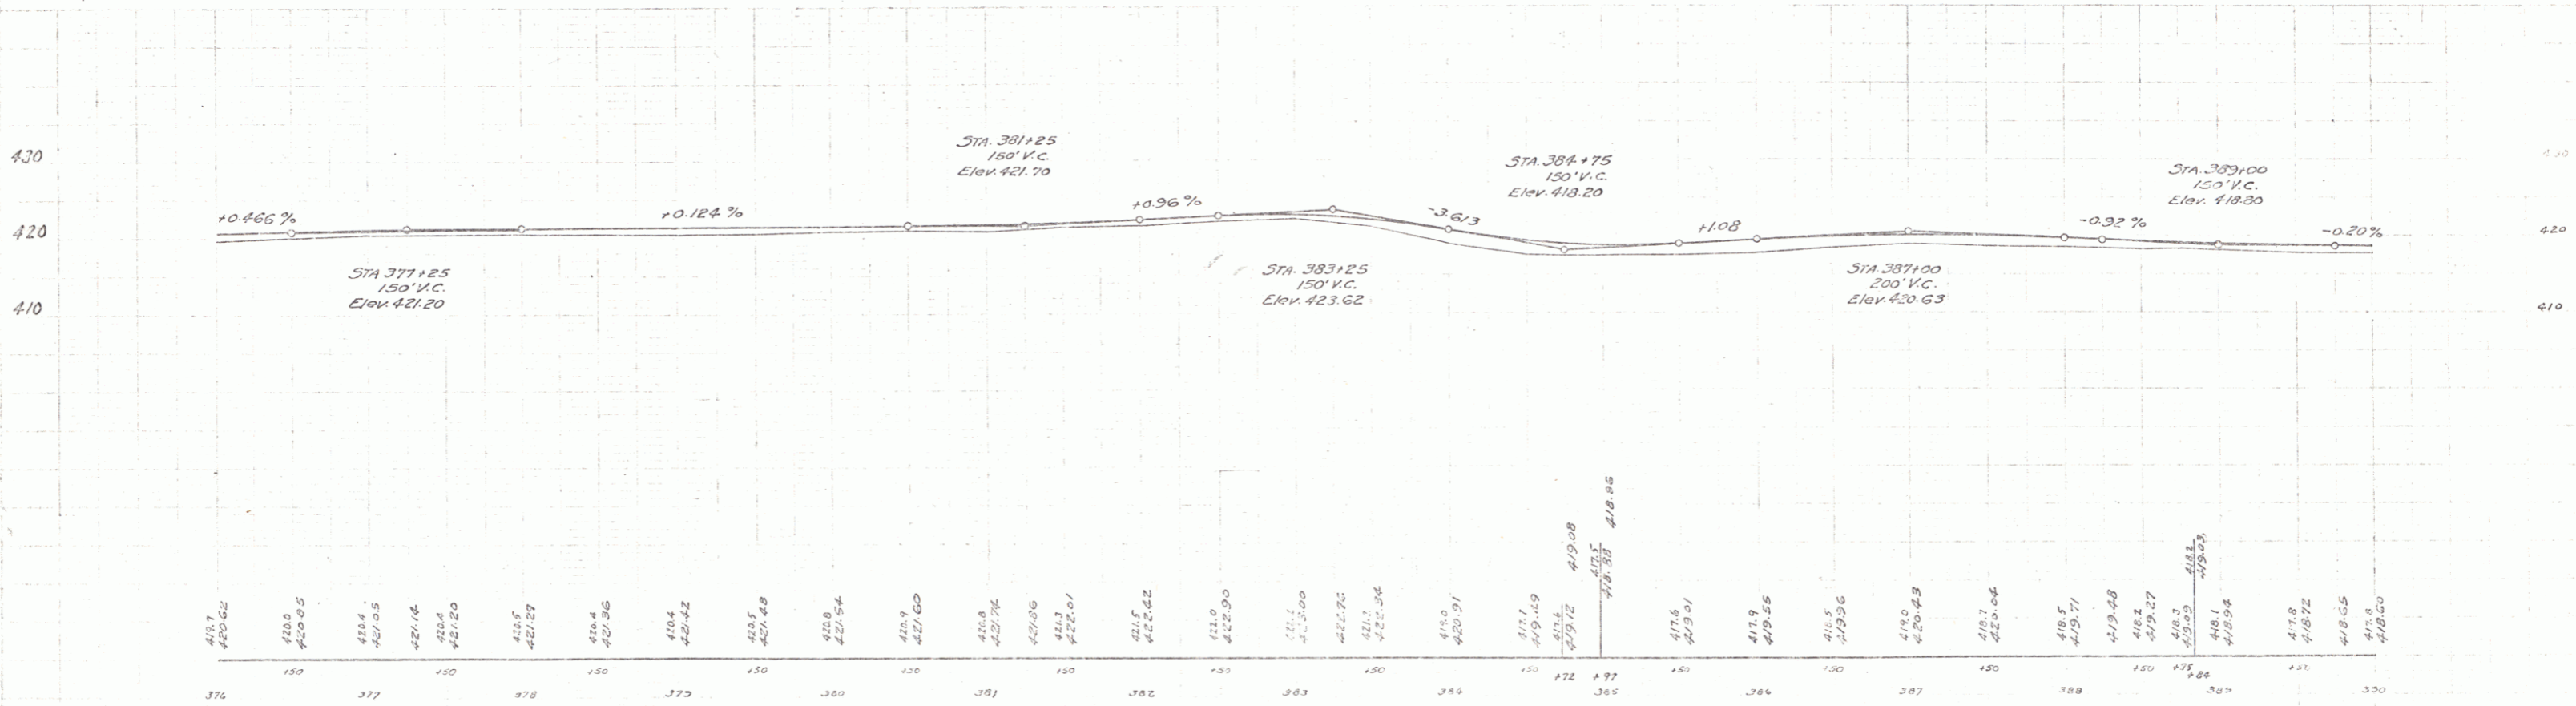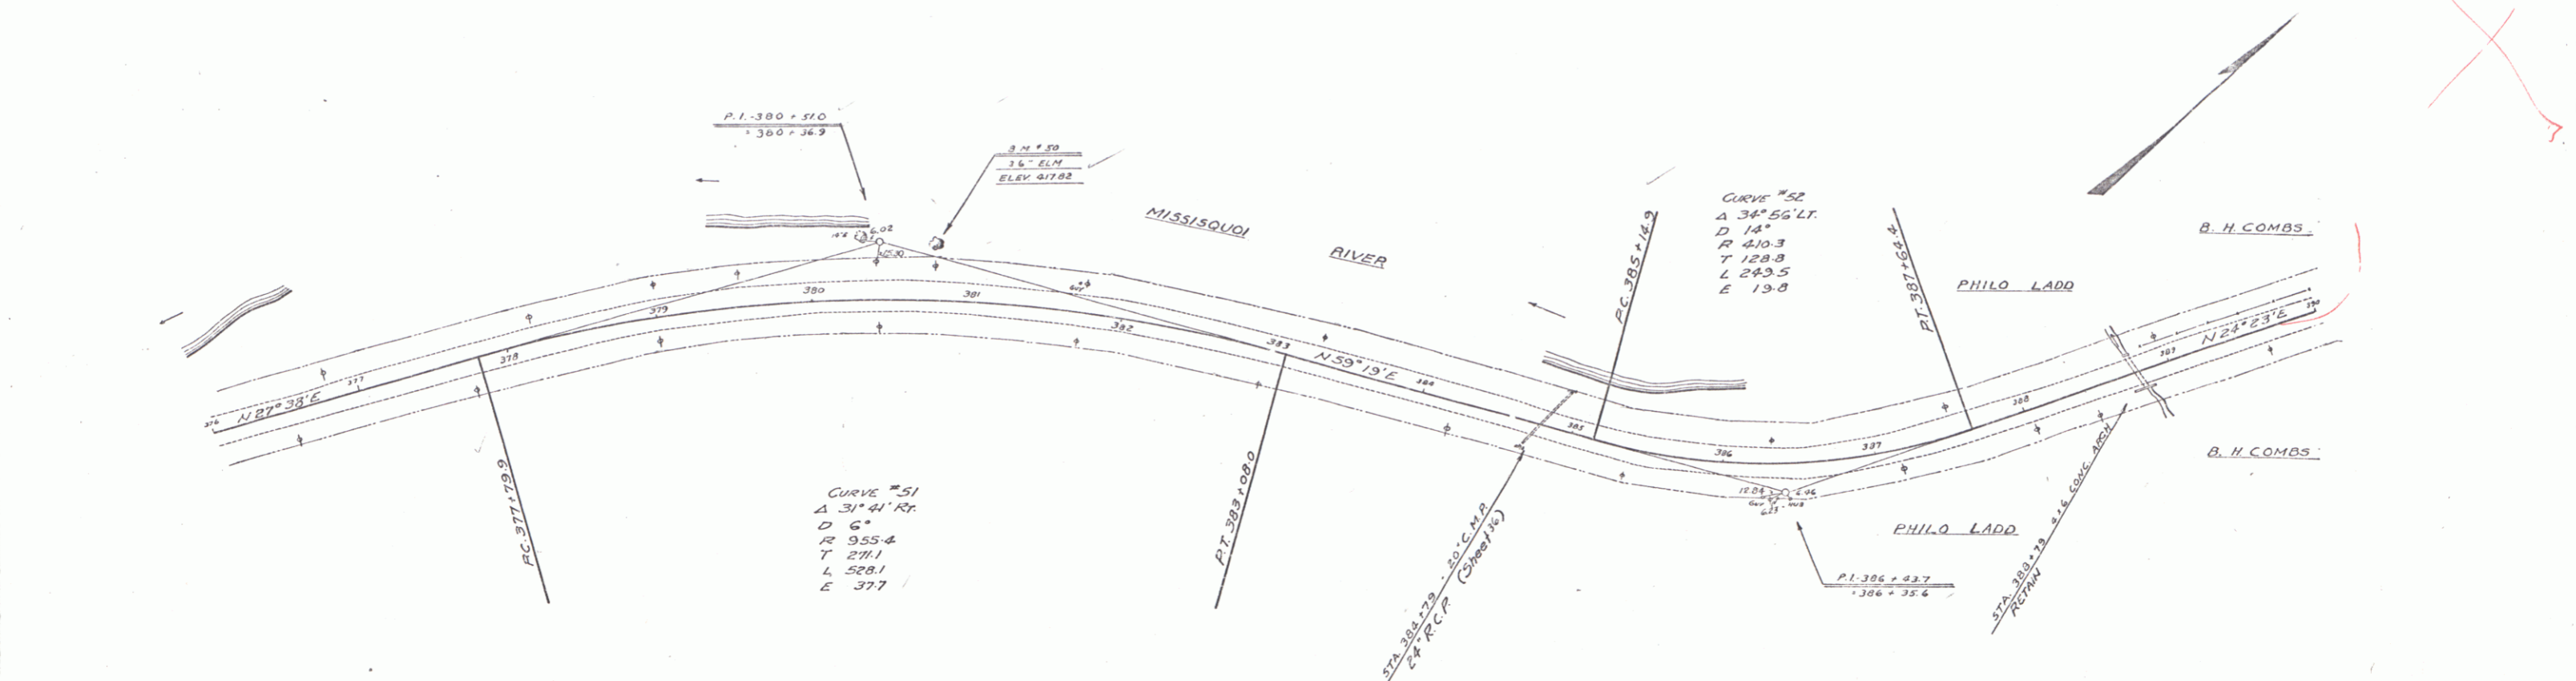

B.M. #30 SPINE IN ROOT 36" ELM 33 FT STA 380+79 ELEV 417.92

SERIES F No 134-L
 SHEET 29 OF 73
 See Berkshire
 F-PL 034-1 (1)
 27