



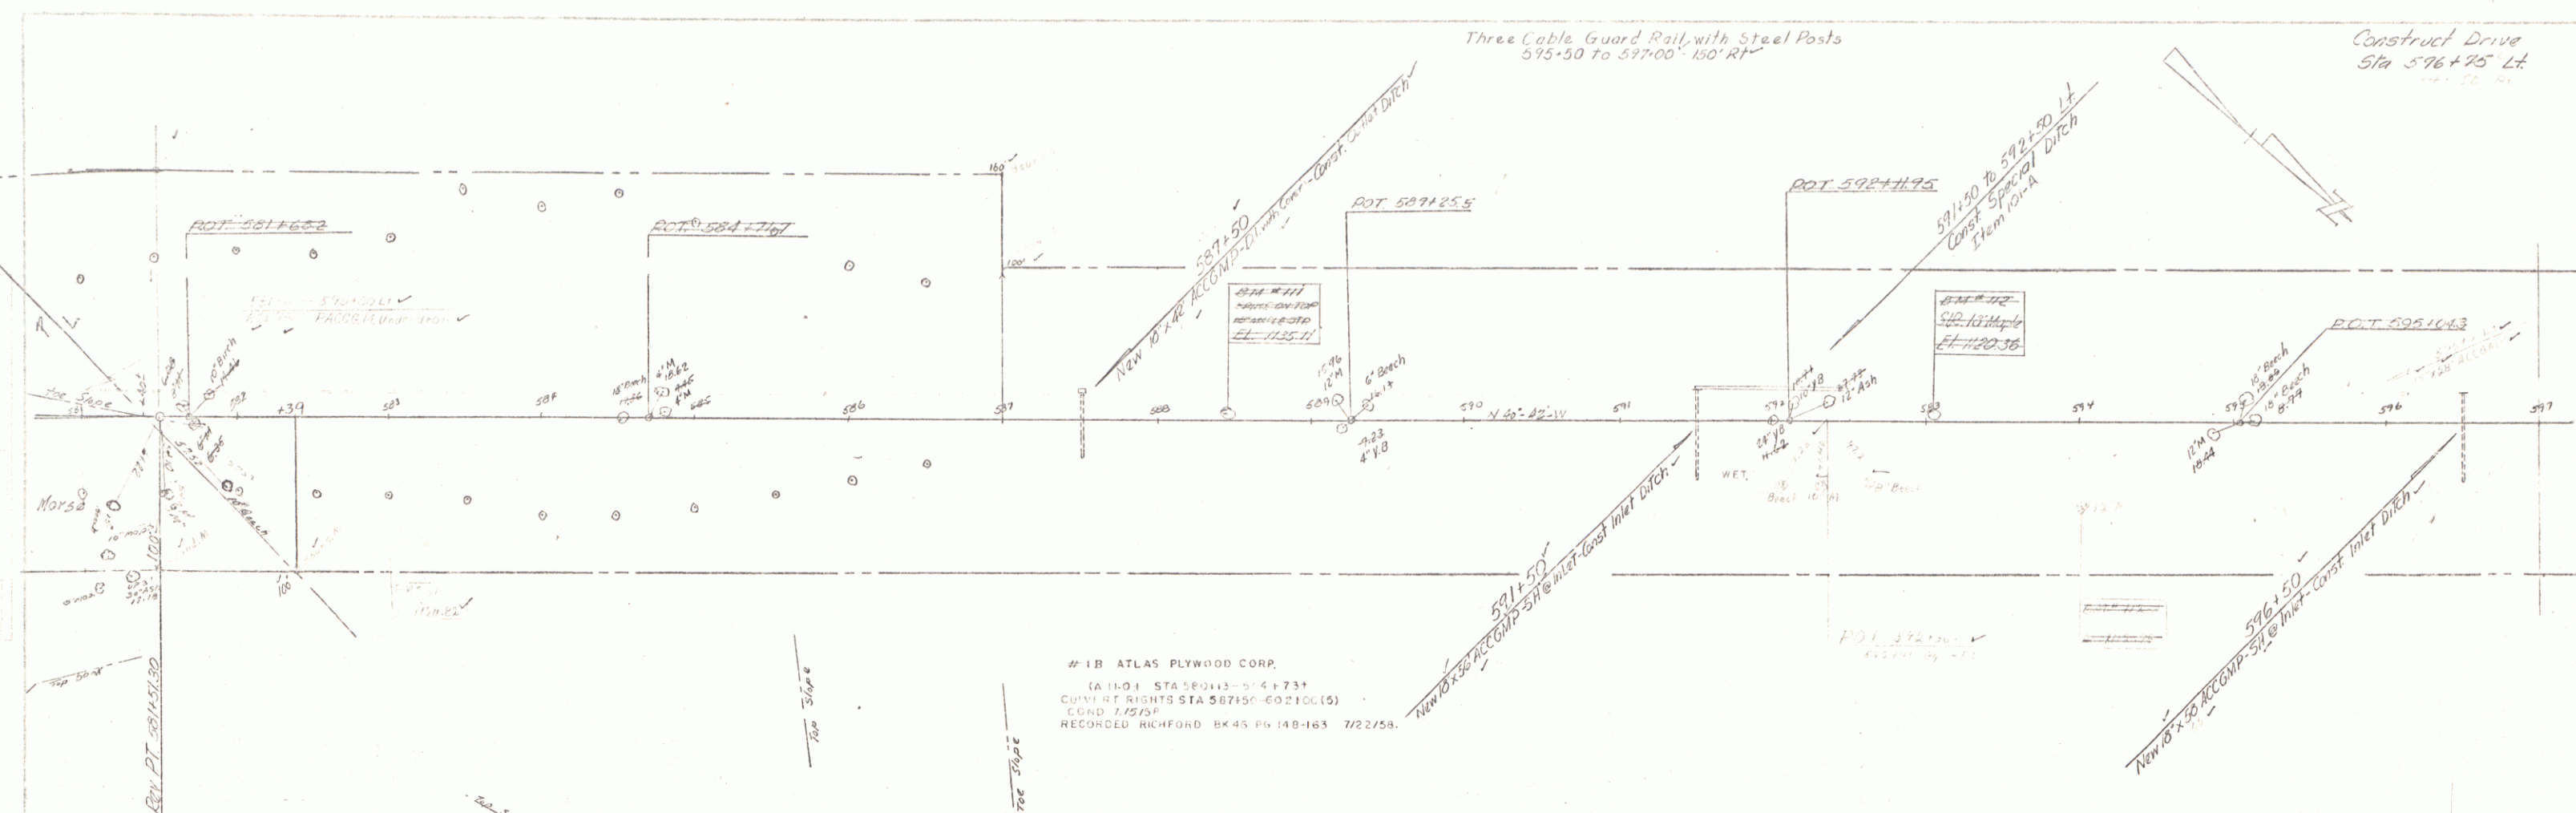

W B ATLAS PLYWOOD CORP.
(A 110-1 STA 580+13-5+4+73+)
CUT & FILL RIGHTS STA 587+50-60+100 (S)
COND. 1/15/75
RECORDED RICHMOND BK 45 PG 148-163 7/22/58.

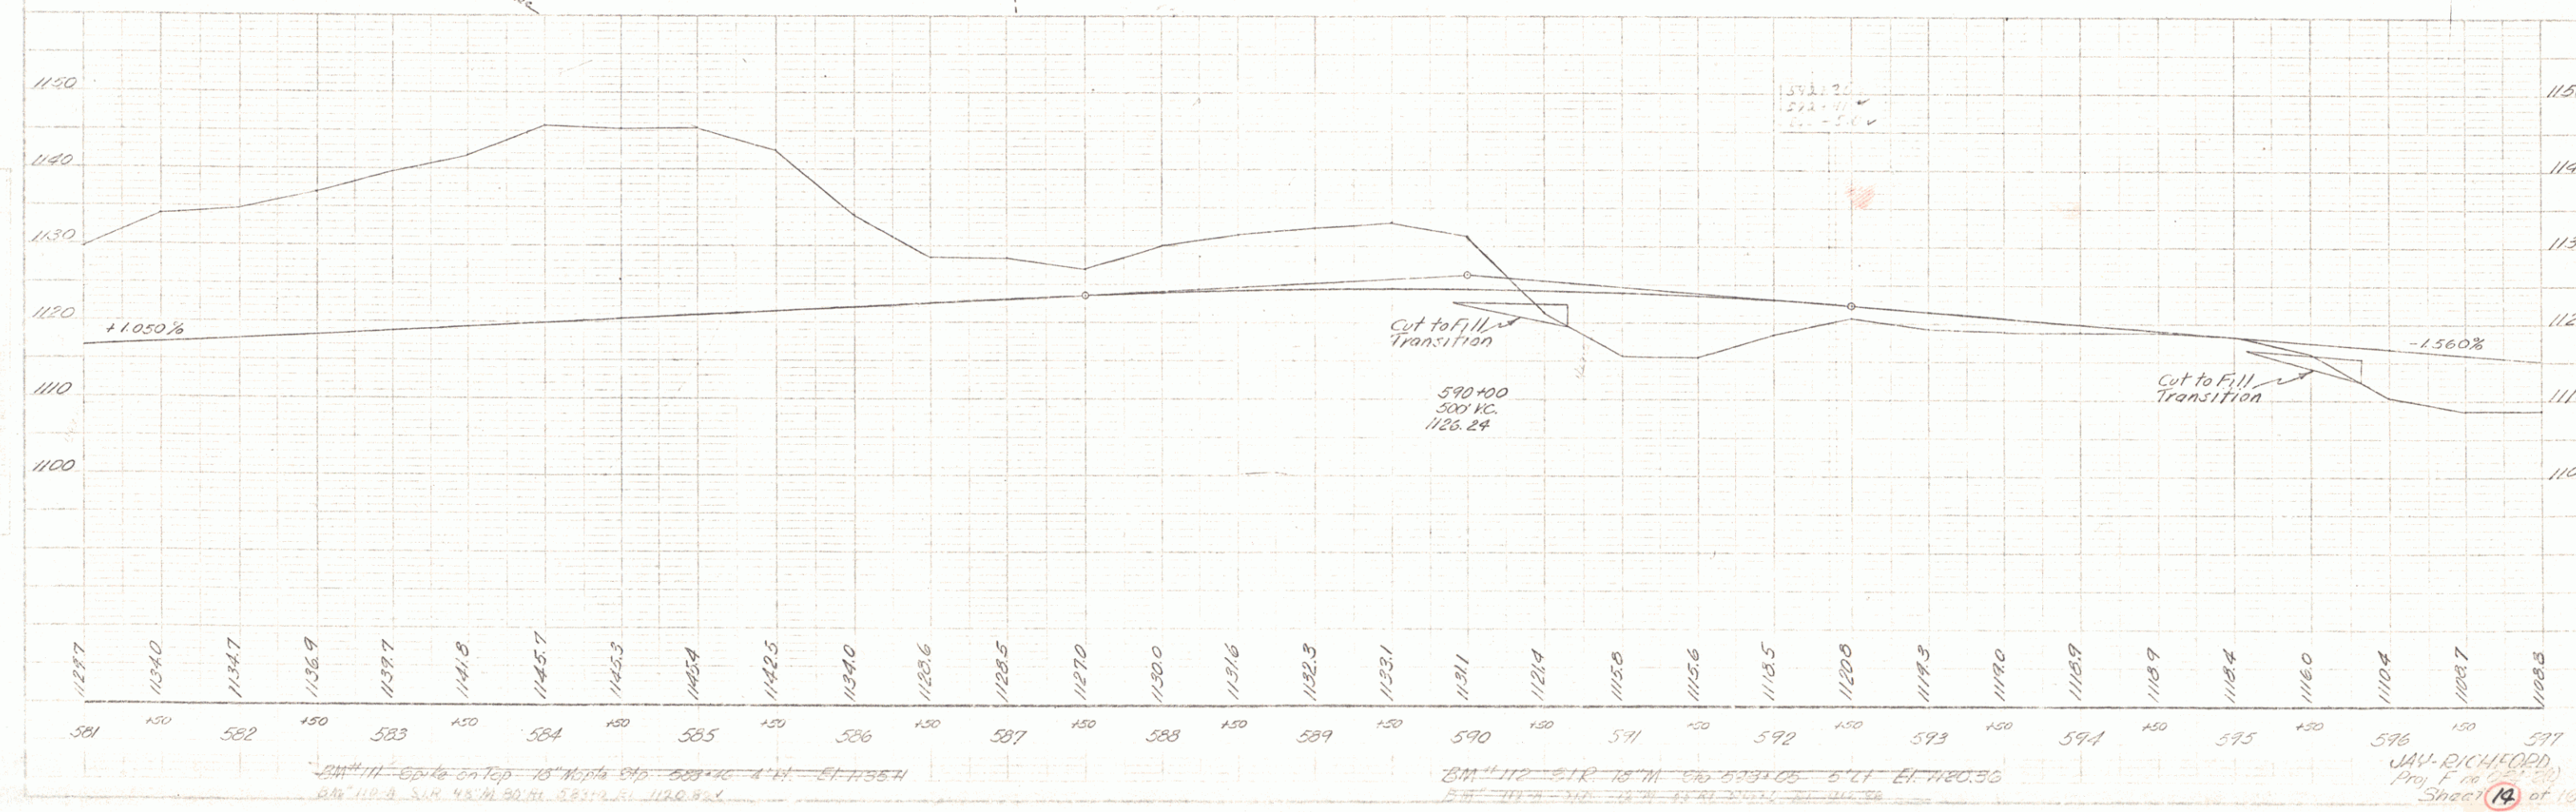

JAY RICHMOND
Proj. Engr. (No. 100-100)
Sheet 14 of 100