



1957
 A. A. J. 1957

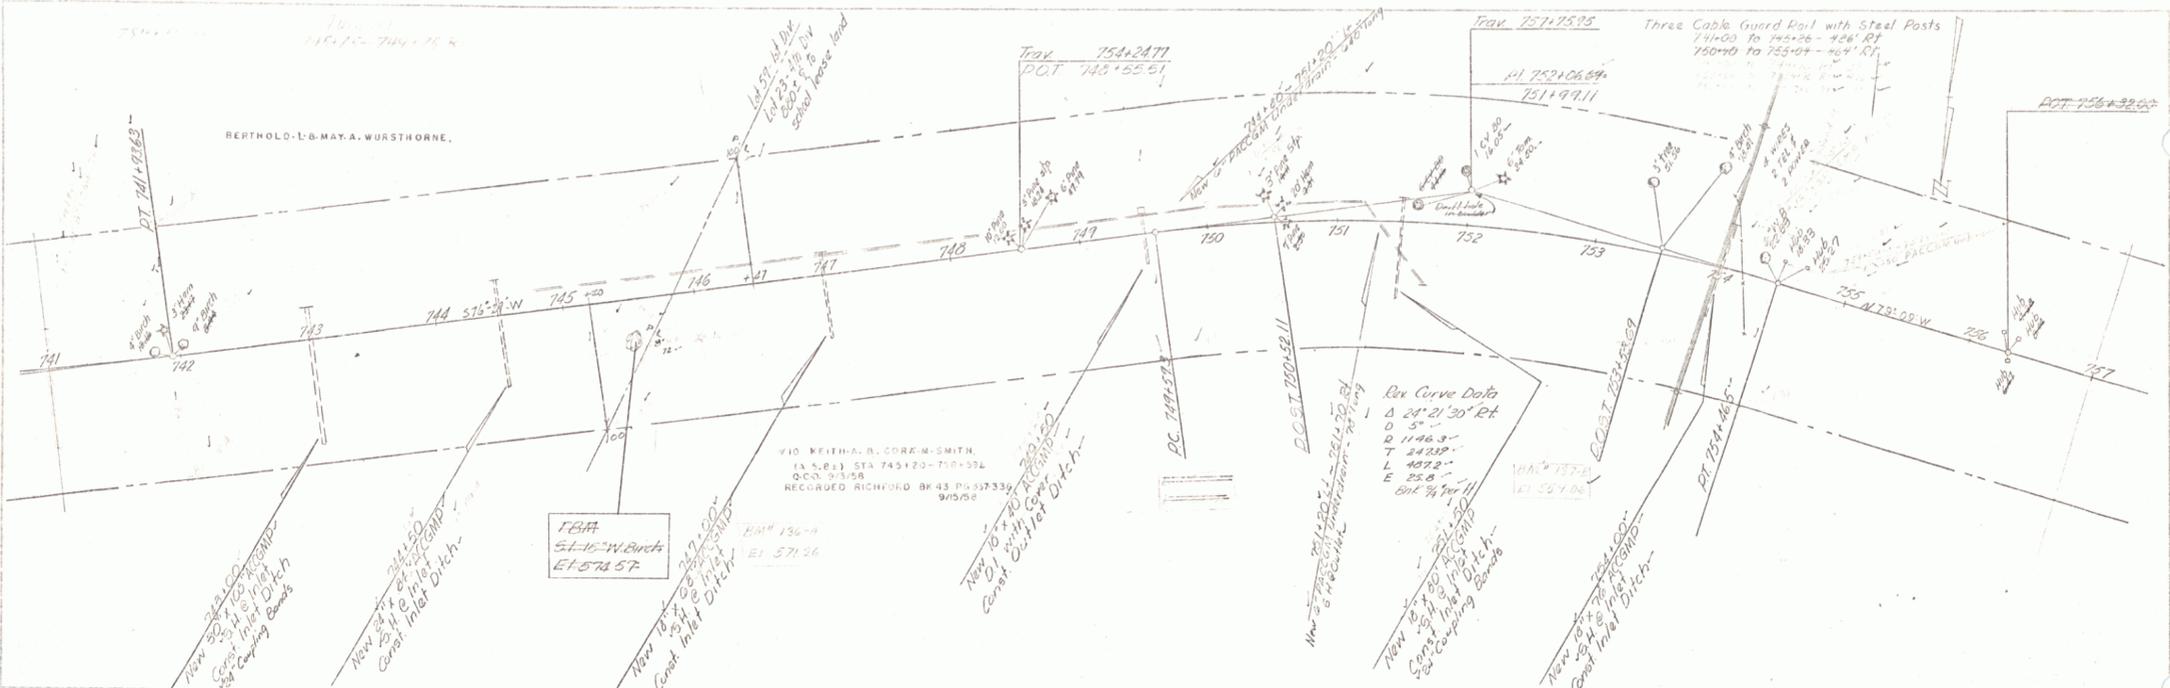

S. Cummings 1957

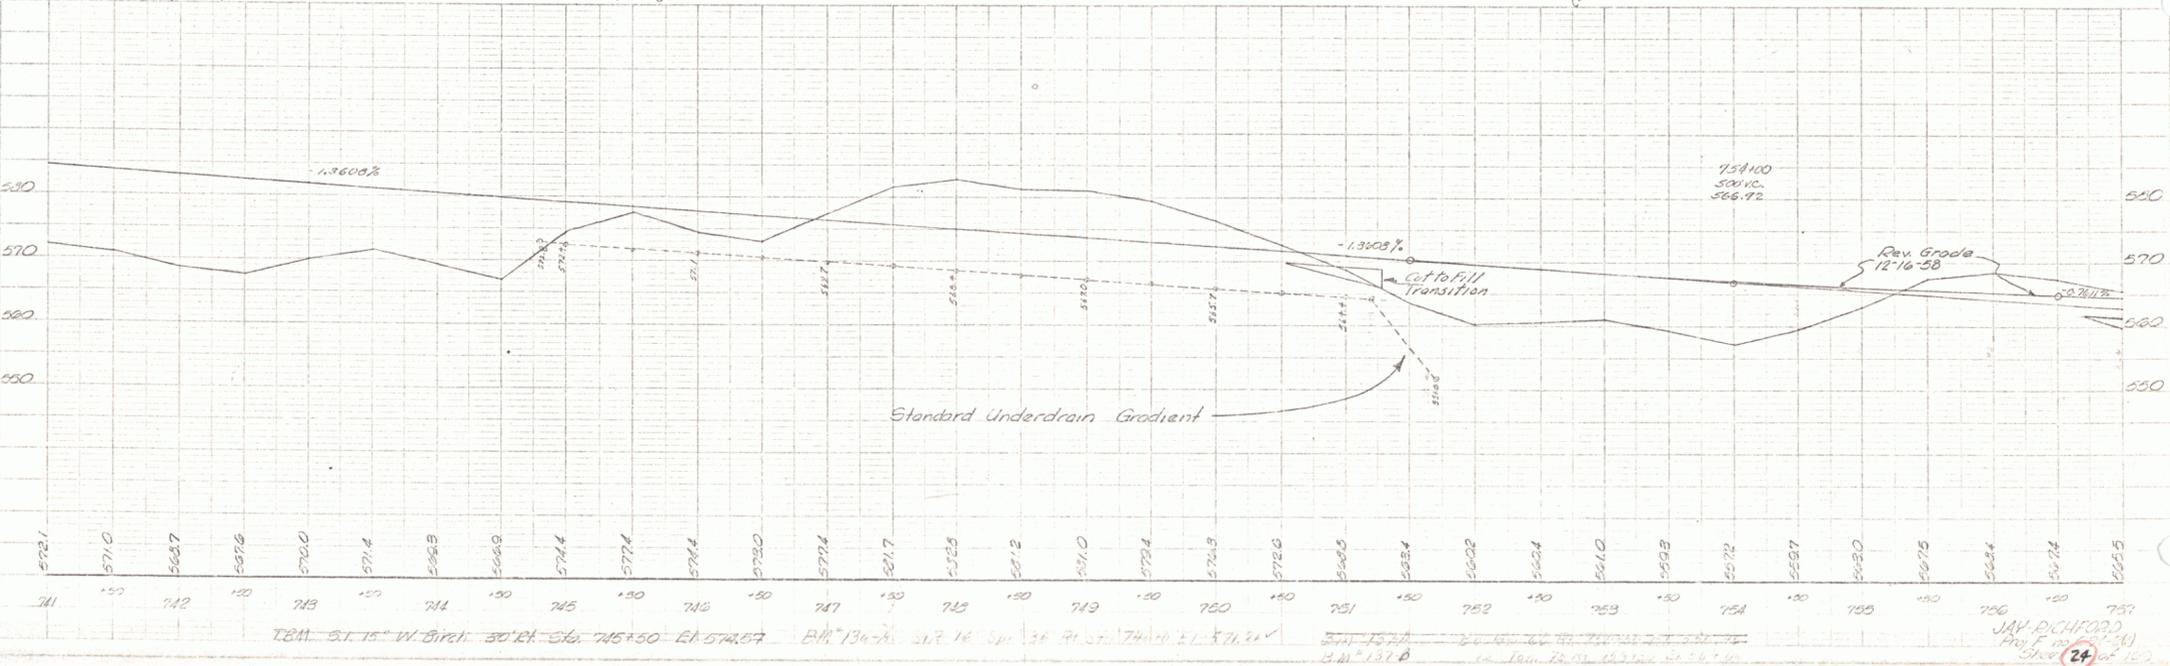

JAY RICHFORD
 Proj. F. 100-100-50
 Sheet 24 of 100