



PLAN	DATE	BY
REVISION		
NO. 1	10/13/53	JAY
NO. 2		
NO. 3		
NO. 4		
NO. 5		

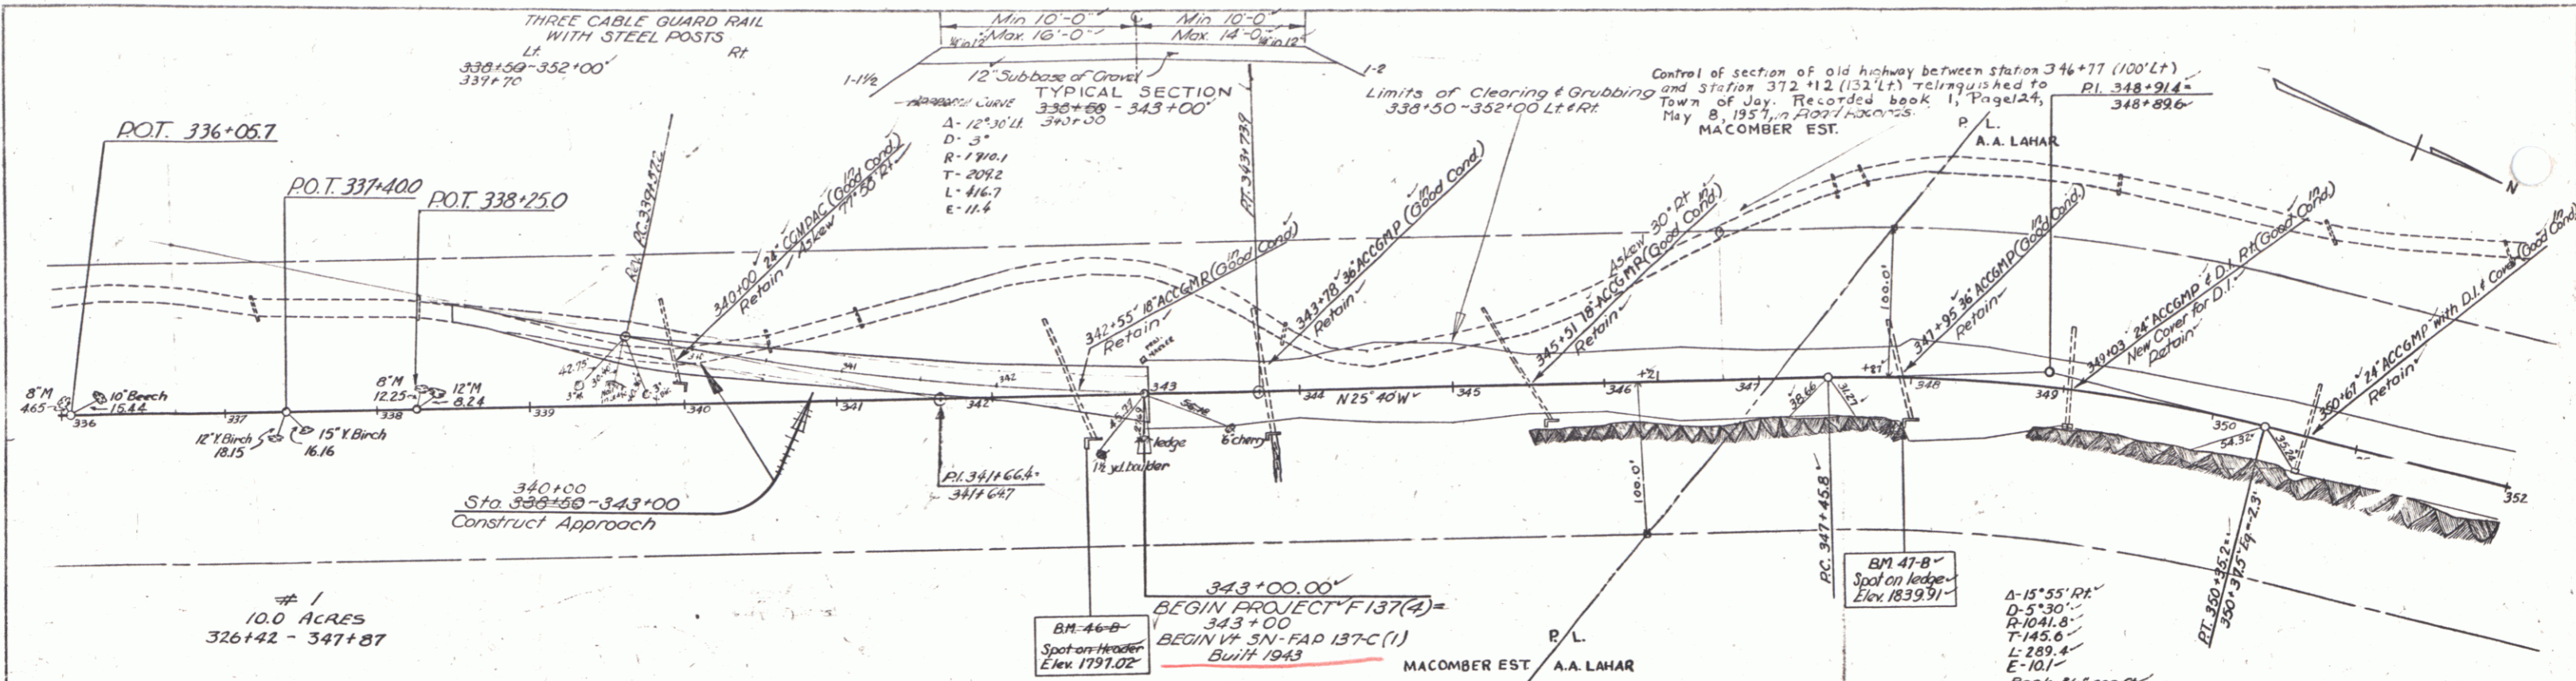

PARCEL	INSTRUMENT	DATE	GRANTOR	GRANTEE	RECORDED	BOOK	PAGE	DATE	REMARKS
#1	ADNR W.D.O.E.	9-3-41	A.A. MACOMBER EST.	St of VT	JAY	13	262-3	10-24-41	See 5N-FAP 137C (1) 1942
	Corp QCDDE	10-13-53	UNIVERSITY OF VT.	ST of VT	JAY	13	320-322	11-7	RELEASE OF RIGHTS ON PARCELS 1, 2A, 2B, #3 & 4E PART OF ADBAF LEASED LAND SEE ALSO SHEETS 9, 11, 13, 21, 26A

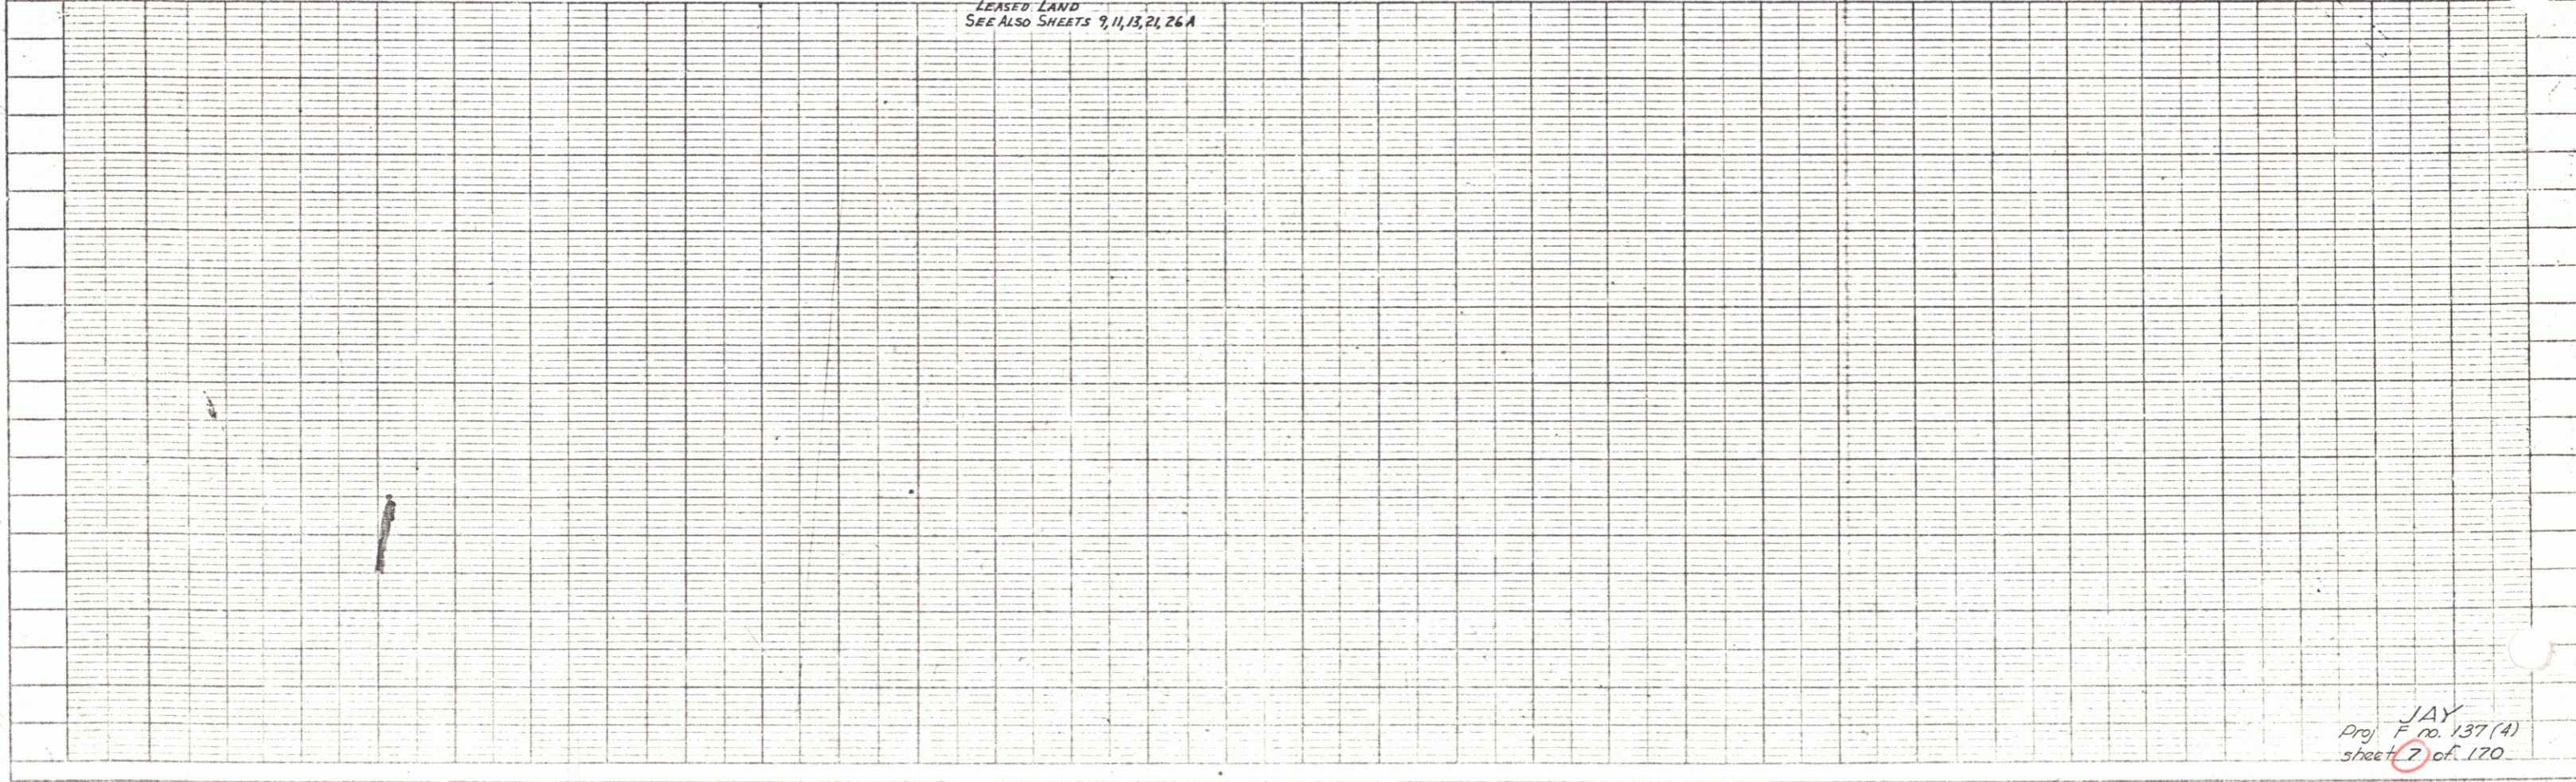

JAY
 Proj F. 10. 137(4)
 sheet 2 of 170