


PLAN
 SHEET NO. 17
 DATE 1/17/53
 DRAWN BY G. Spaulding
 CHECKED BY G. Spaulding

PROFILE
 SHEET NO. 17
 DATE 1/17/53
 DRAWN BY G. Spaulding
 CHECKED BY G. Spaulding

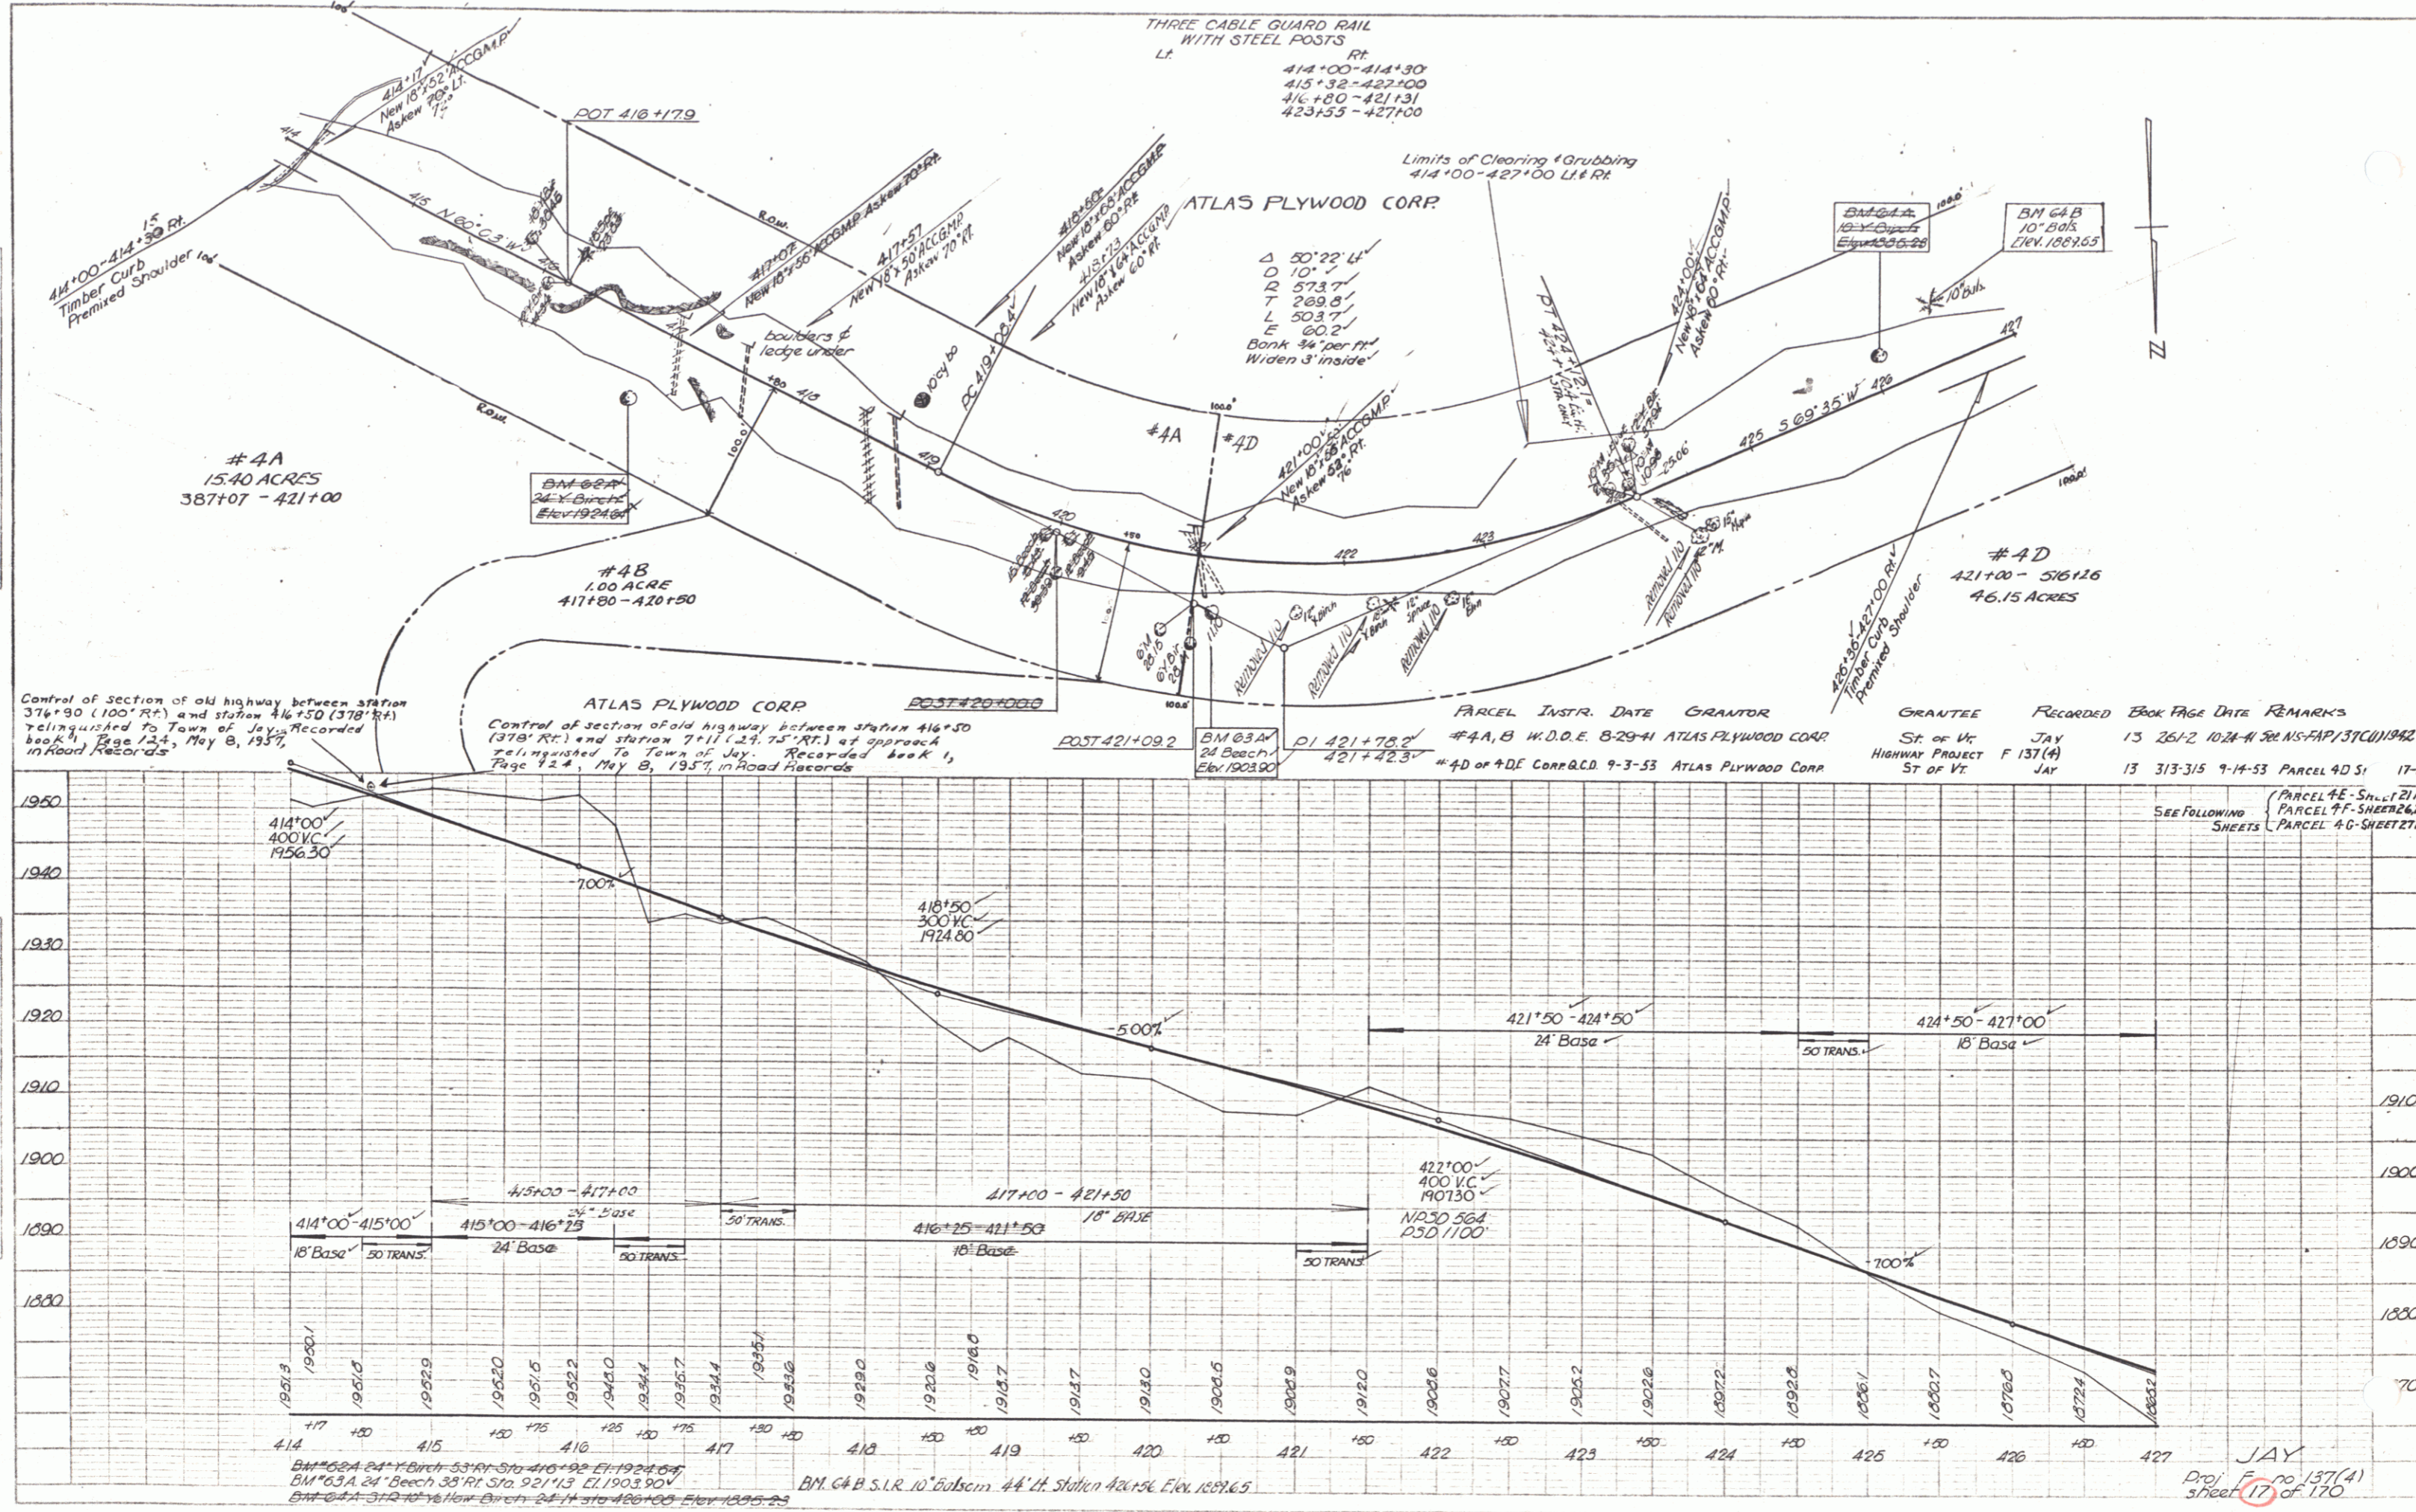

JAY
 Proj. No. 137(4)
 Sheet 17 of 170