



PLAN  
 DRAWN BY  
 J. Palmer  
 CHECKED BY  
 J. Palmer  
 DATE  
 5-24

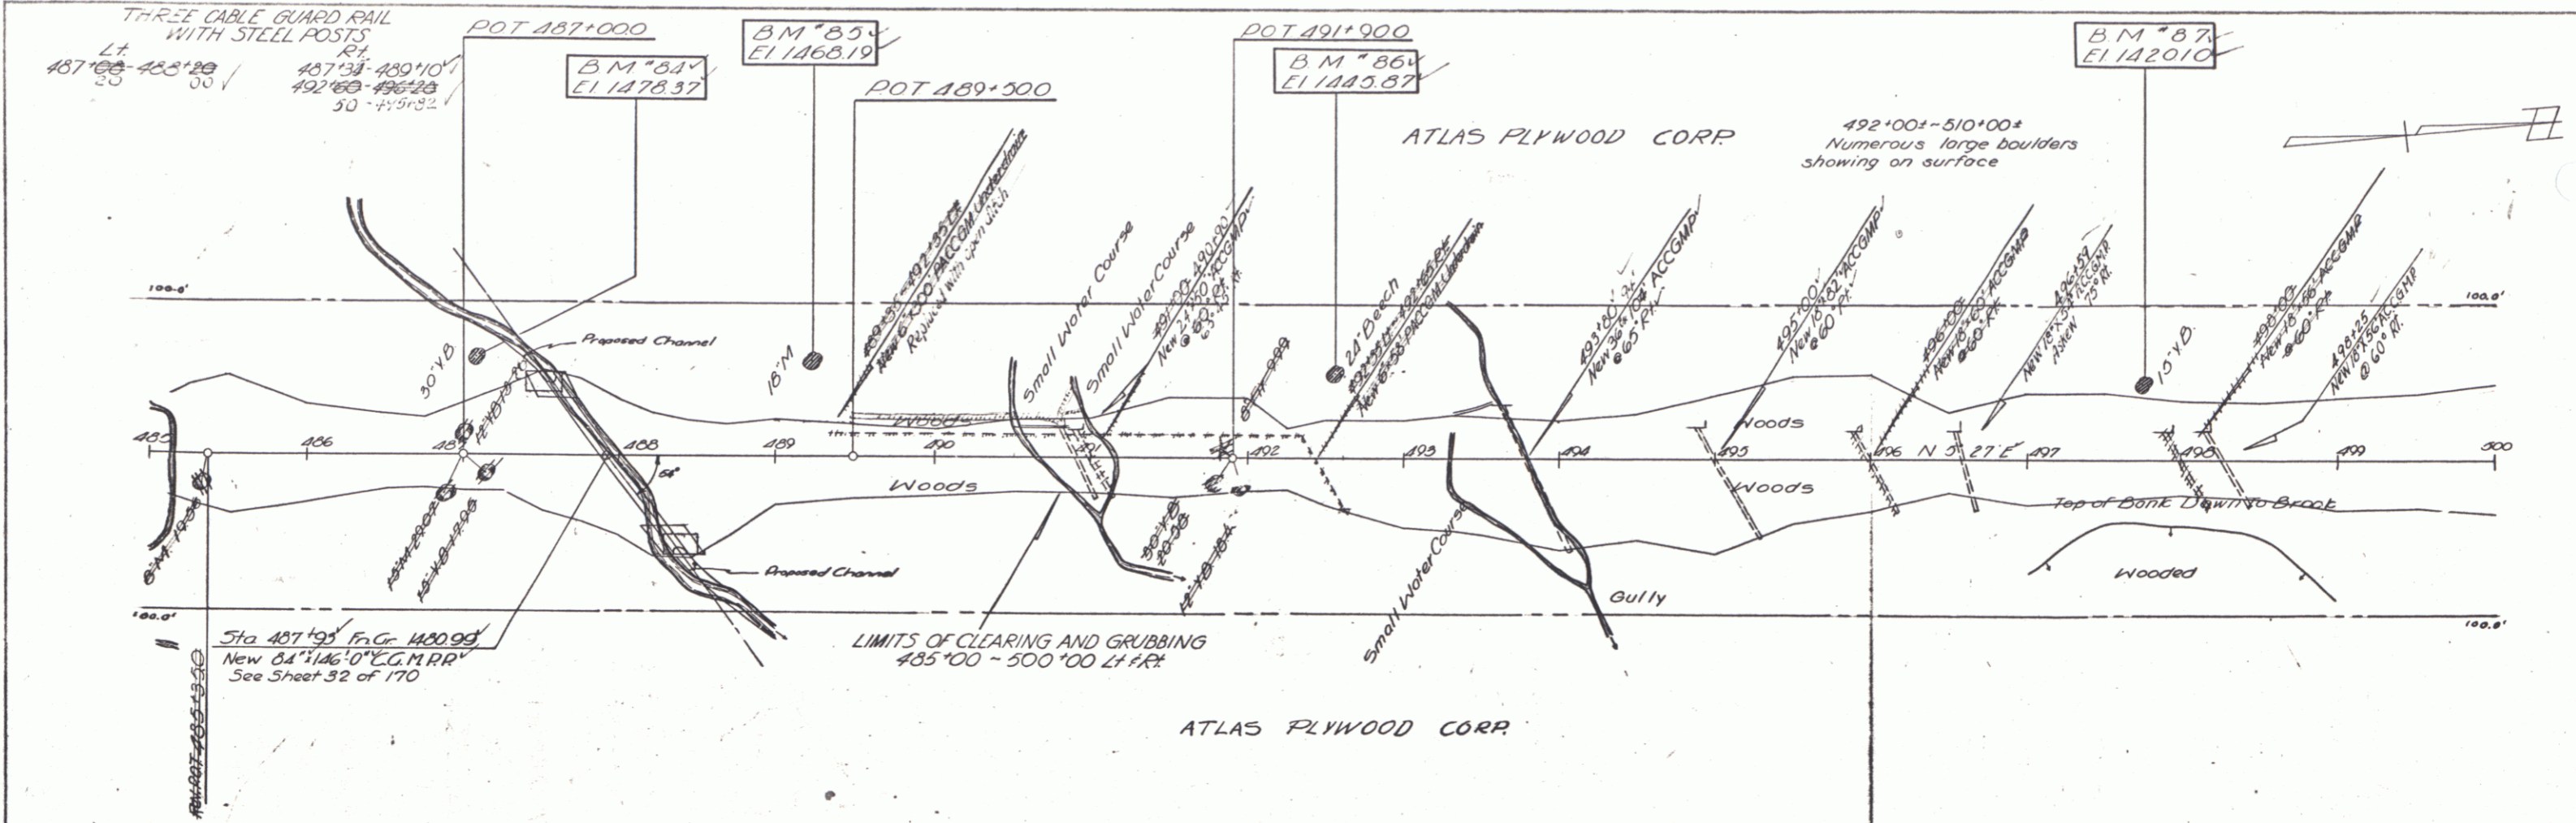

PROFILE  
 DRAWN BY  
 J. Palmer  
 CHECKED BY  
 J. Palmer  
 DATE  
 5-24

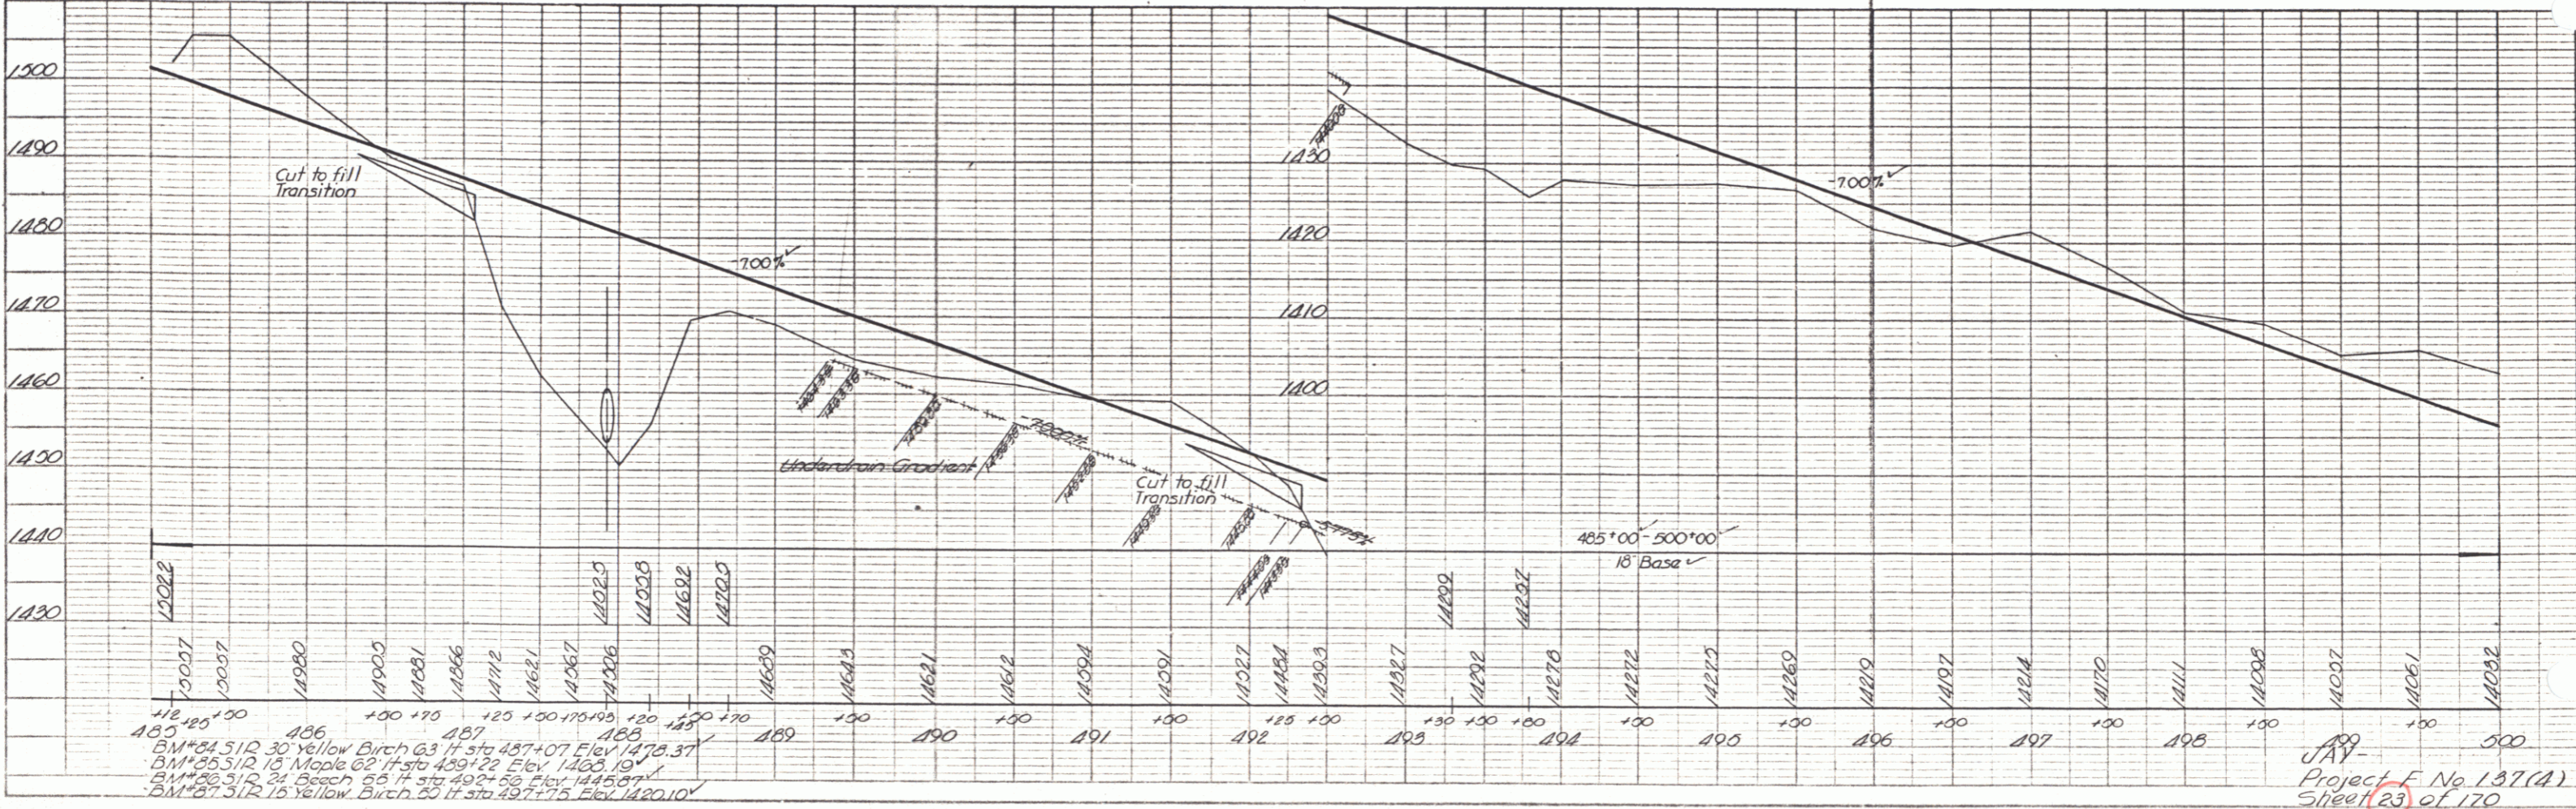

1500  
1490  
1480  
1470  
1460  
1450  
1440  
1430

485+00 486+00 487+00 488+00 489+00 490+00 491+00 492+00 493+00 494+00 495+00 496+00 497+00 498+00 499+00 500+00

BM 85 512 30 Yellow Birch G3 14 ft sta 487+07 Elev 1478.37  
 BM 86 512 18 Maple G2 14 ft sta 489+22 Elev 1483.19  
 BM 87 512 24 Birch G3 14 ft sta 492+59 Elev 1458.71  
 BM 88 512 16 Yellow Birch G3 14 ft sta 497+75 Elev 1480.10

PLATE 1 - PLAN - PROFILE  
 ADRIAN & KERR CO. NEW YORK  
 MADE IN U.S.A.

JAY  
 Project F No 137(A)  
 Sheet 23 of 120