

PLAN
 DATE 9-2-54
 DRAWN BY J. J. [unclear]
 CHECKED BY [unclear]
 IN CHARGE [unclear]

PROFILE
 DATE 9-2-54
 DRAWN BY J. J. [unclear]
 CHECKED BY [unclear]
 IN CHARGE [unclear]

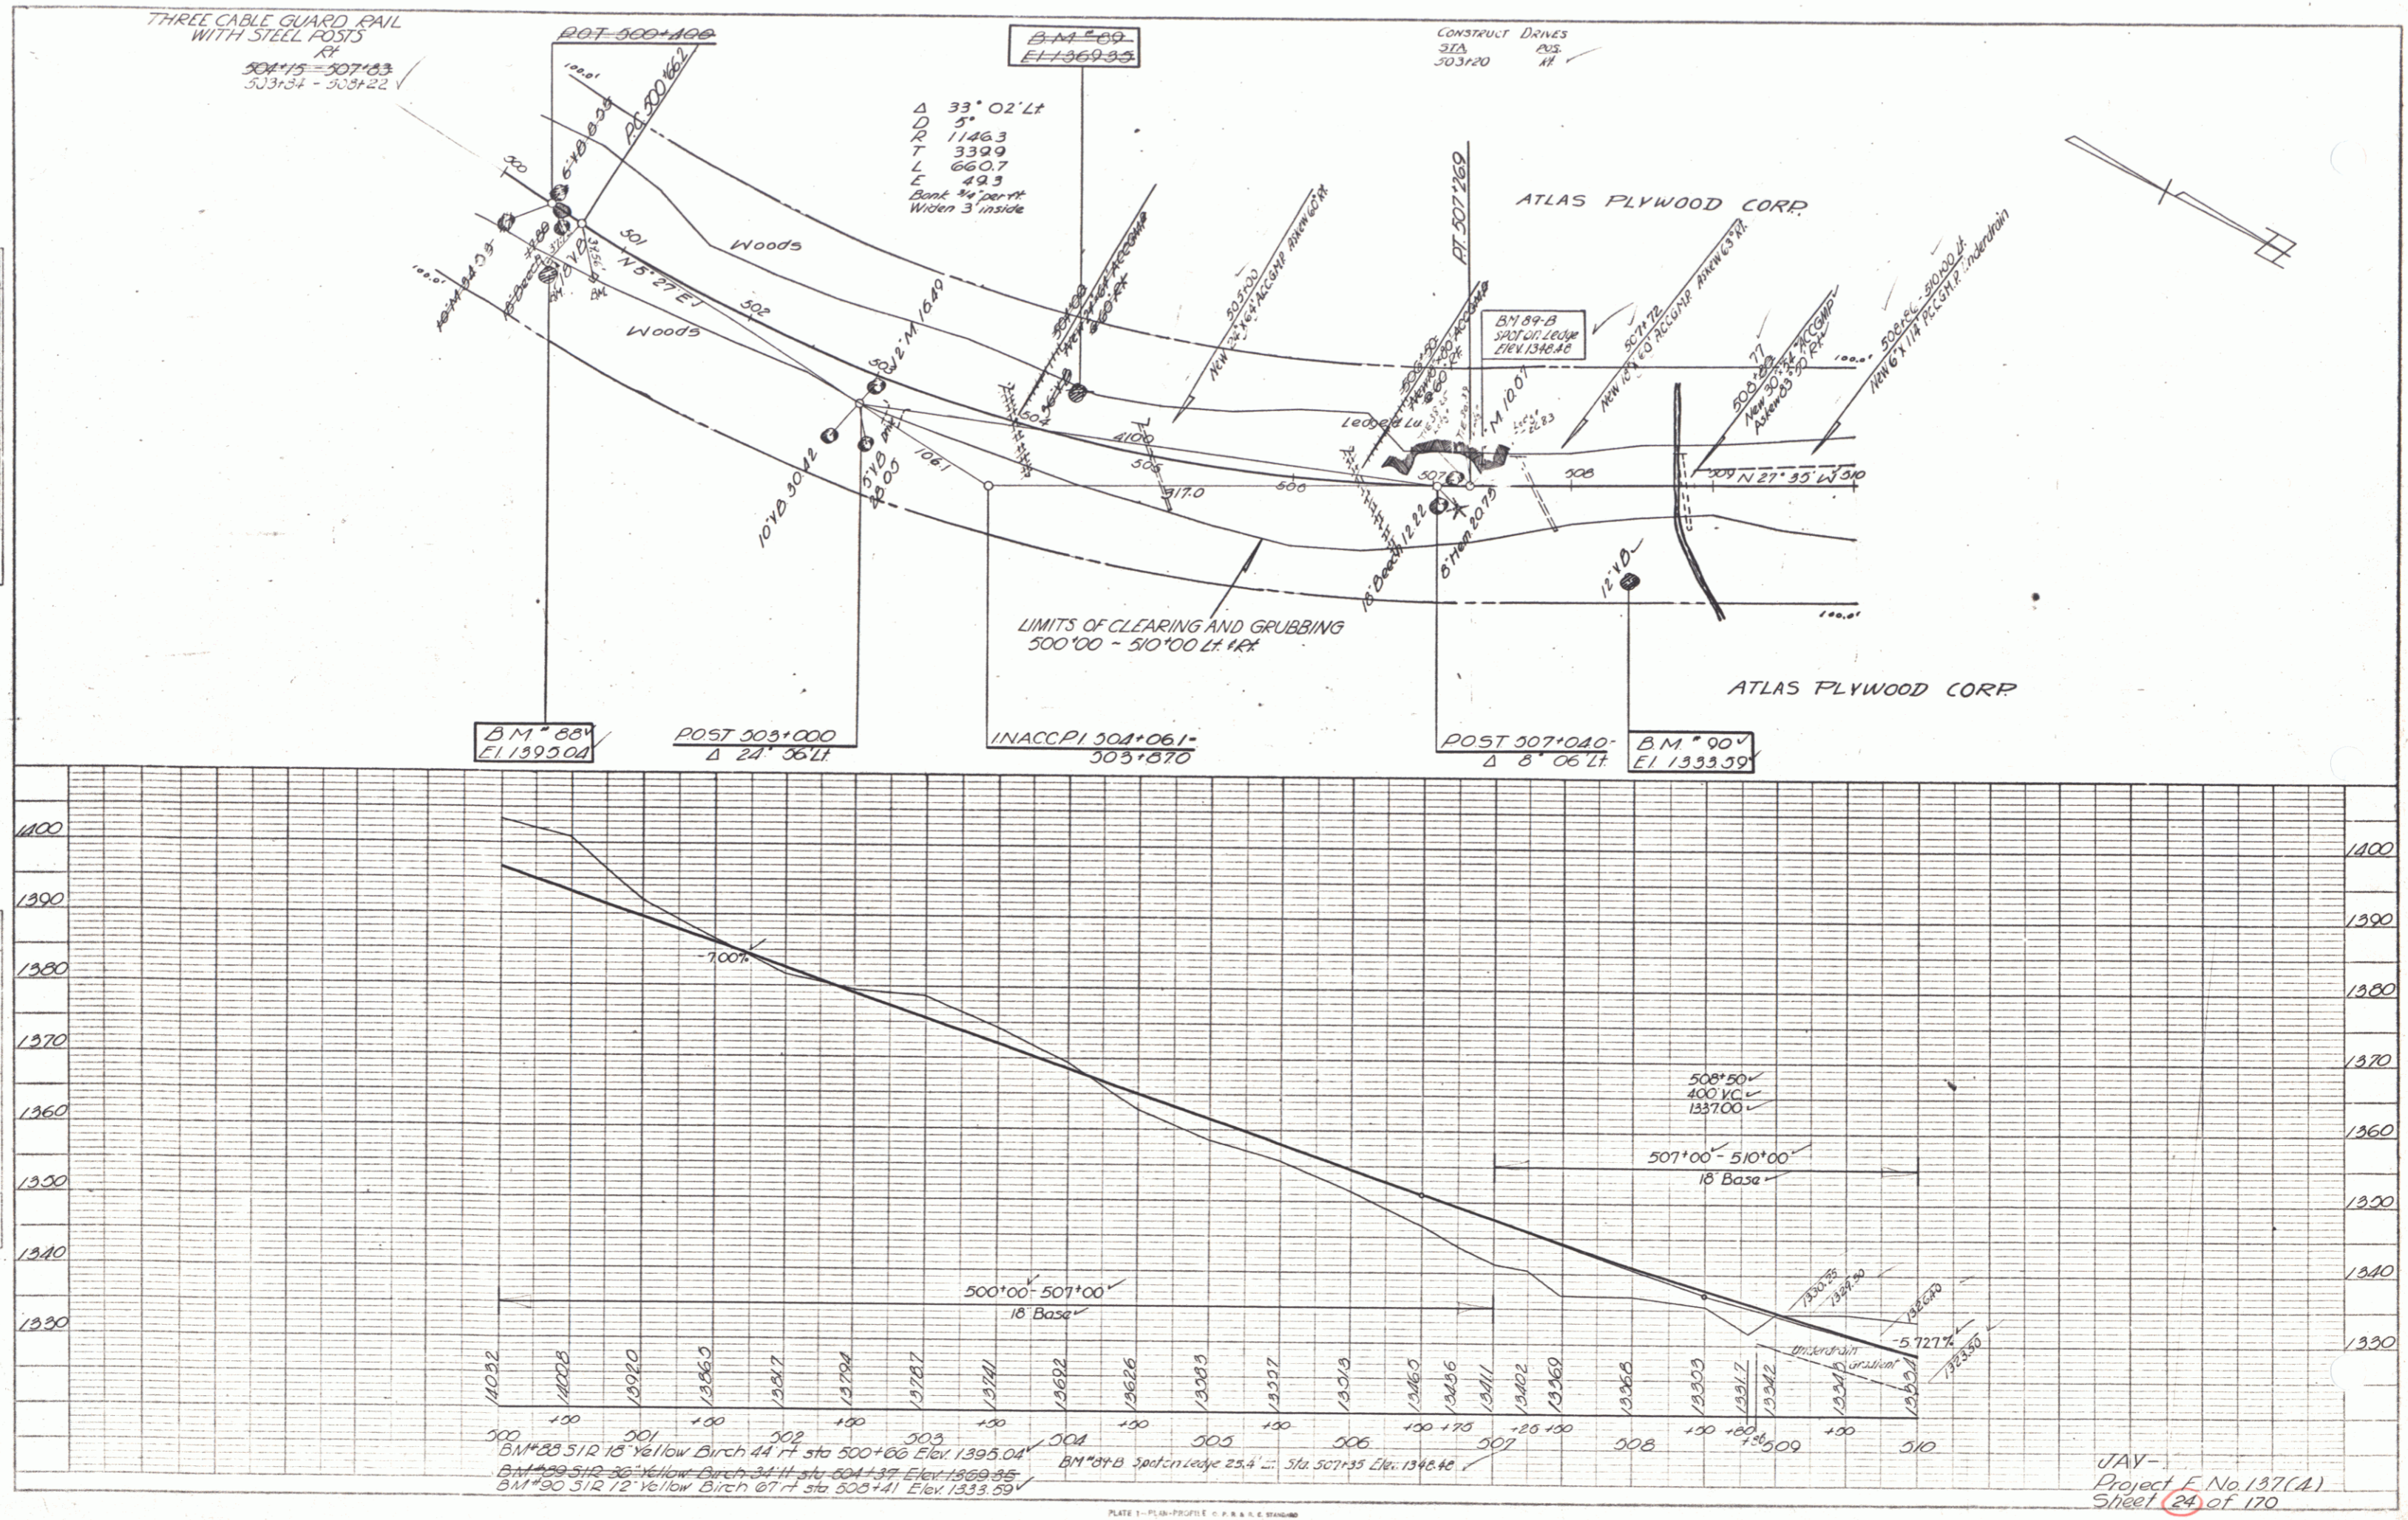


PLATE 1 - PLAN-PROFILE - P. R. & L. ENGINEERING
 NEWTON, MASSACHUSETTS
 C. & G. No. 340-11-1000

JAV -
 Project E. No. 137(A)
 Sheet 24 of 170