
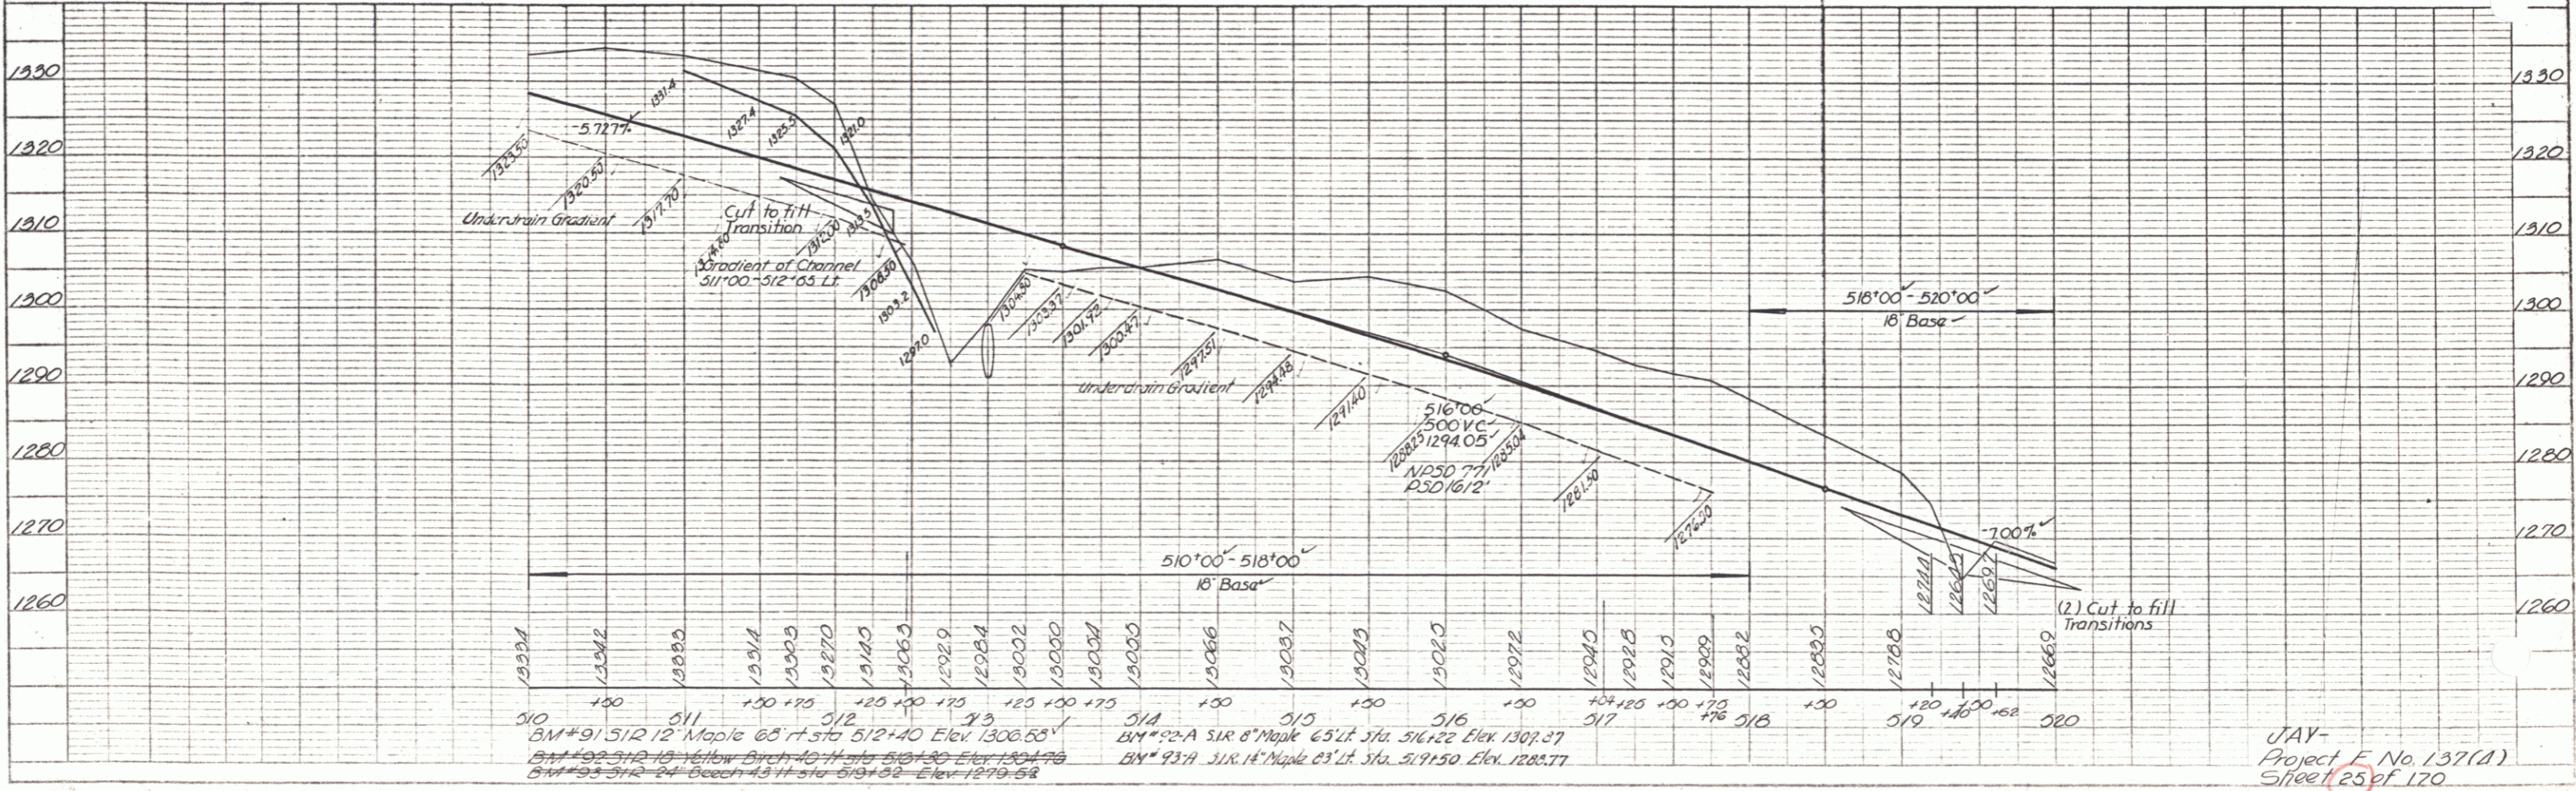


PLAN
 DRAWN BY
 CHECKED BY
 DATE
 SHEET NO. OF SHEETS
 PROJECT NO.

PROFILE
 DRAWN BY
 CHECKED BY
 DATE
 SHEET NO. OF SHEETS
 PROJECT NO.

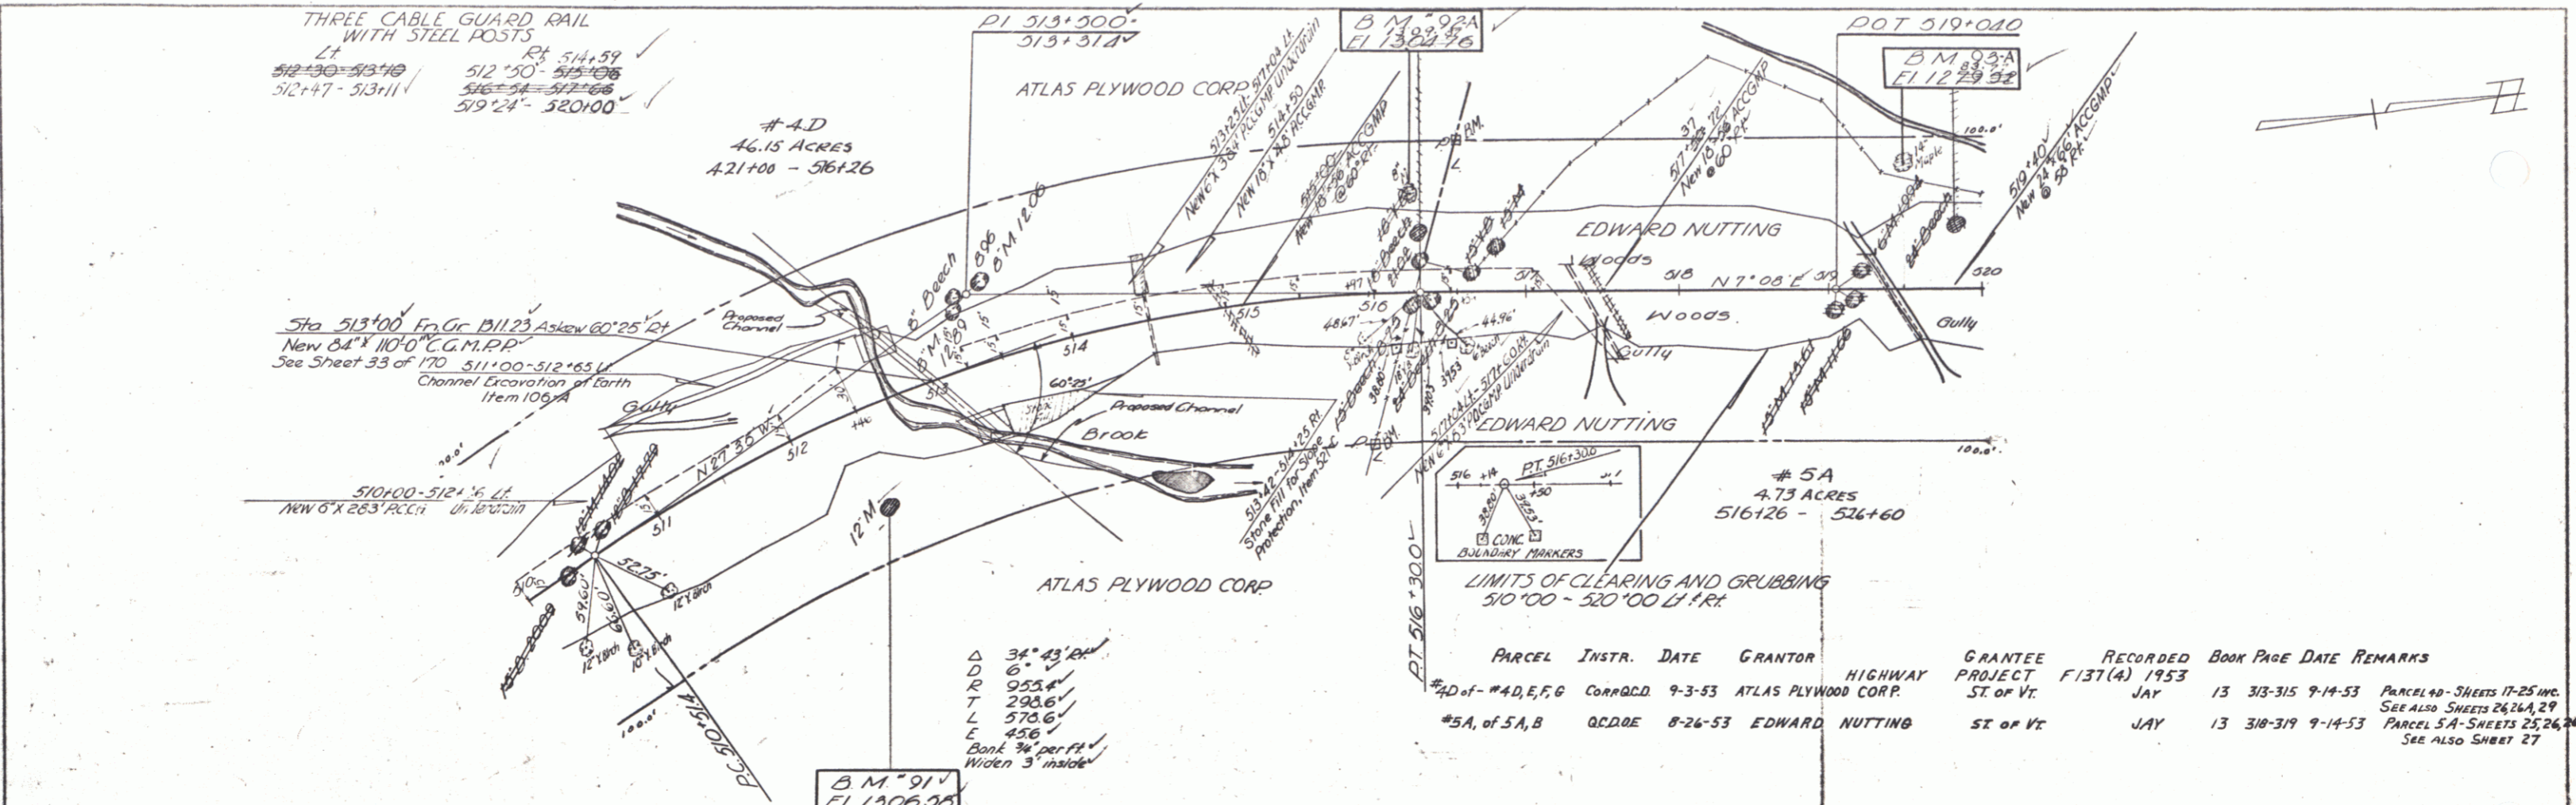

PARCEL	INSTR.	DATE	GRANTOR	HIGHWAY PROJECT	GRANTEE	RECORDED	BOOK	PAGE	DATE	REMARKS
#4D, E, F, G	CORROD	9-3-53	ATLAS PLYWOOD CORP.	HIGHWAY PROJECT ST. OF VT.	JAY	F 137(A)	13	313-315	9-14-53	PARCEL 4D - SHEETS 17-25 INC. SEE ALSO SHEETS 24, 26, 29
#5A, of 5A, B	QCDOE	8-26-53	EDWARD NUTTING	ST. OF VT.	JAY	F 137(A)	13	318-319	9-14-53	PARCEL 5A - SHEETS 25, 26, 28 SEE ALSO SHEET 27

510 BM#91 512 12 Maple 68 ft. Sta. 512+40 Elev. 1306.55
 511 BM#92 512 13 Yellow Birch 48 ft. Sta. 512+40 Elev. 1304.78
 512 BM#93 512 24 Beech 43 ft. Sta. 512+50 Elev. 1299.58
 513 BM#94 514 8 Maple 65 ft. Sta. 514+22 Elev. 1307.37
 514 BM#93 514 14 Maple 63 ft. Sta. 514+50 Elev. 1288.77

JAY
 Project E. No. 137(A)
 Sheet 25 of 120