
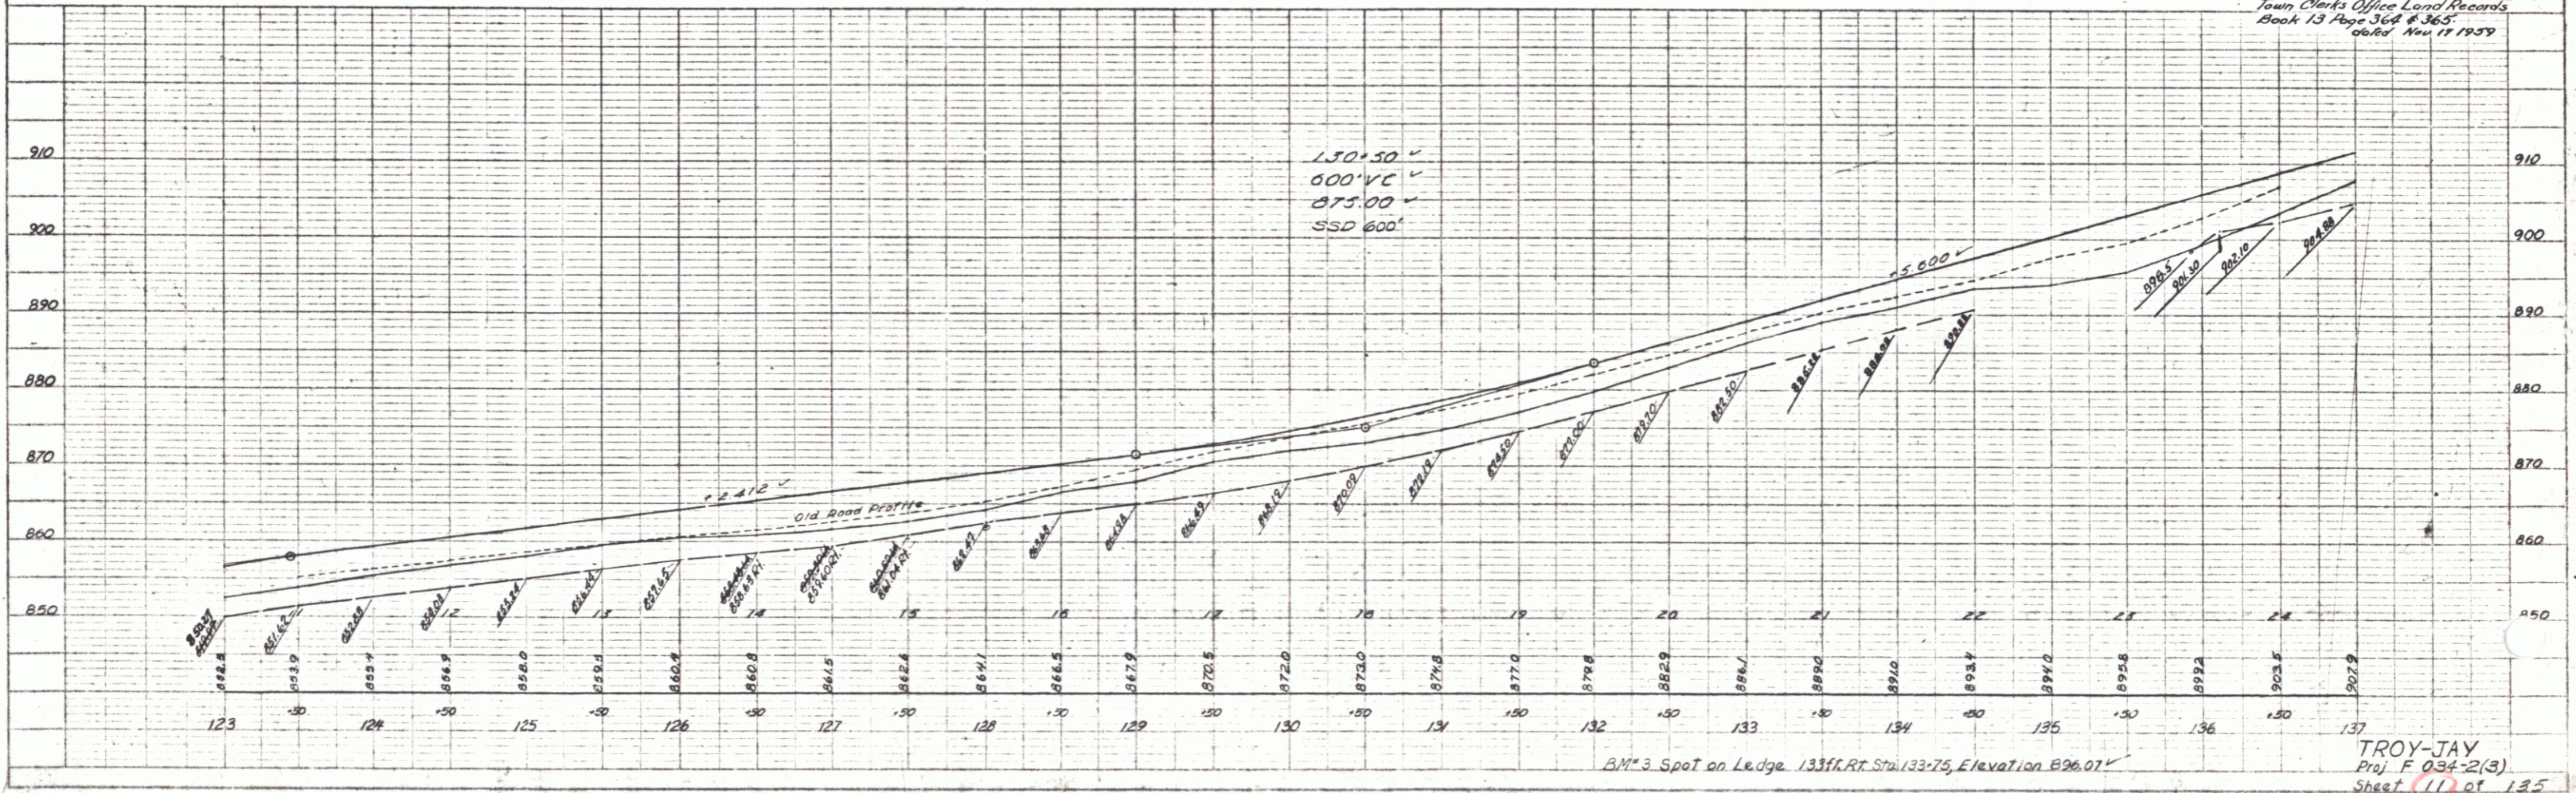


PLAN
 DRAWN BY: J. B. RABOIN
 CHECKED BY: J. B. RABOIN
 DATE: 6/26/58

PROFILE
 DRAWN BY: J. B. RABOIN
 CHECKED BY: J. B. RABOIN
 DATE: 6/26/58

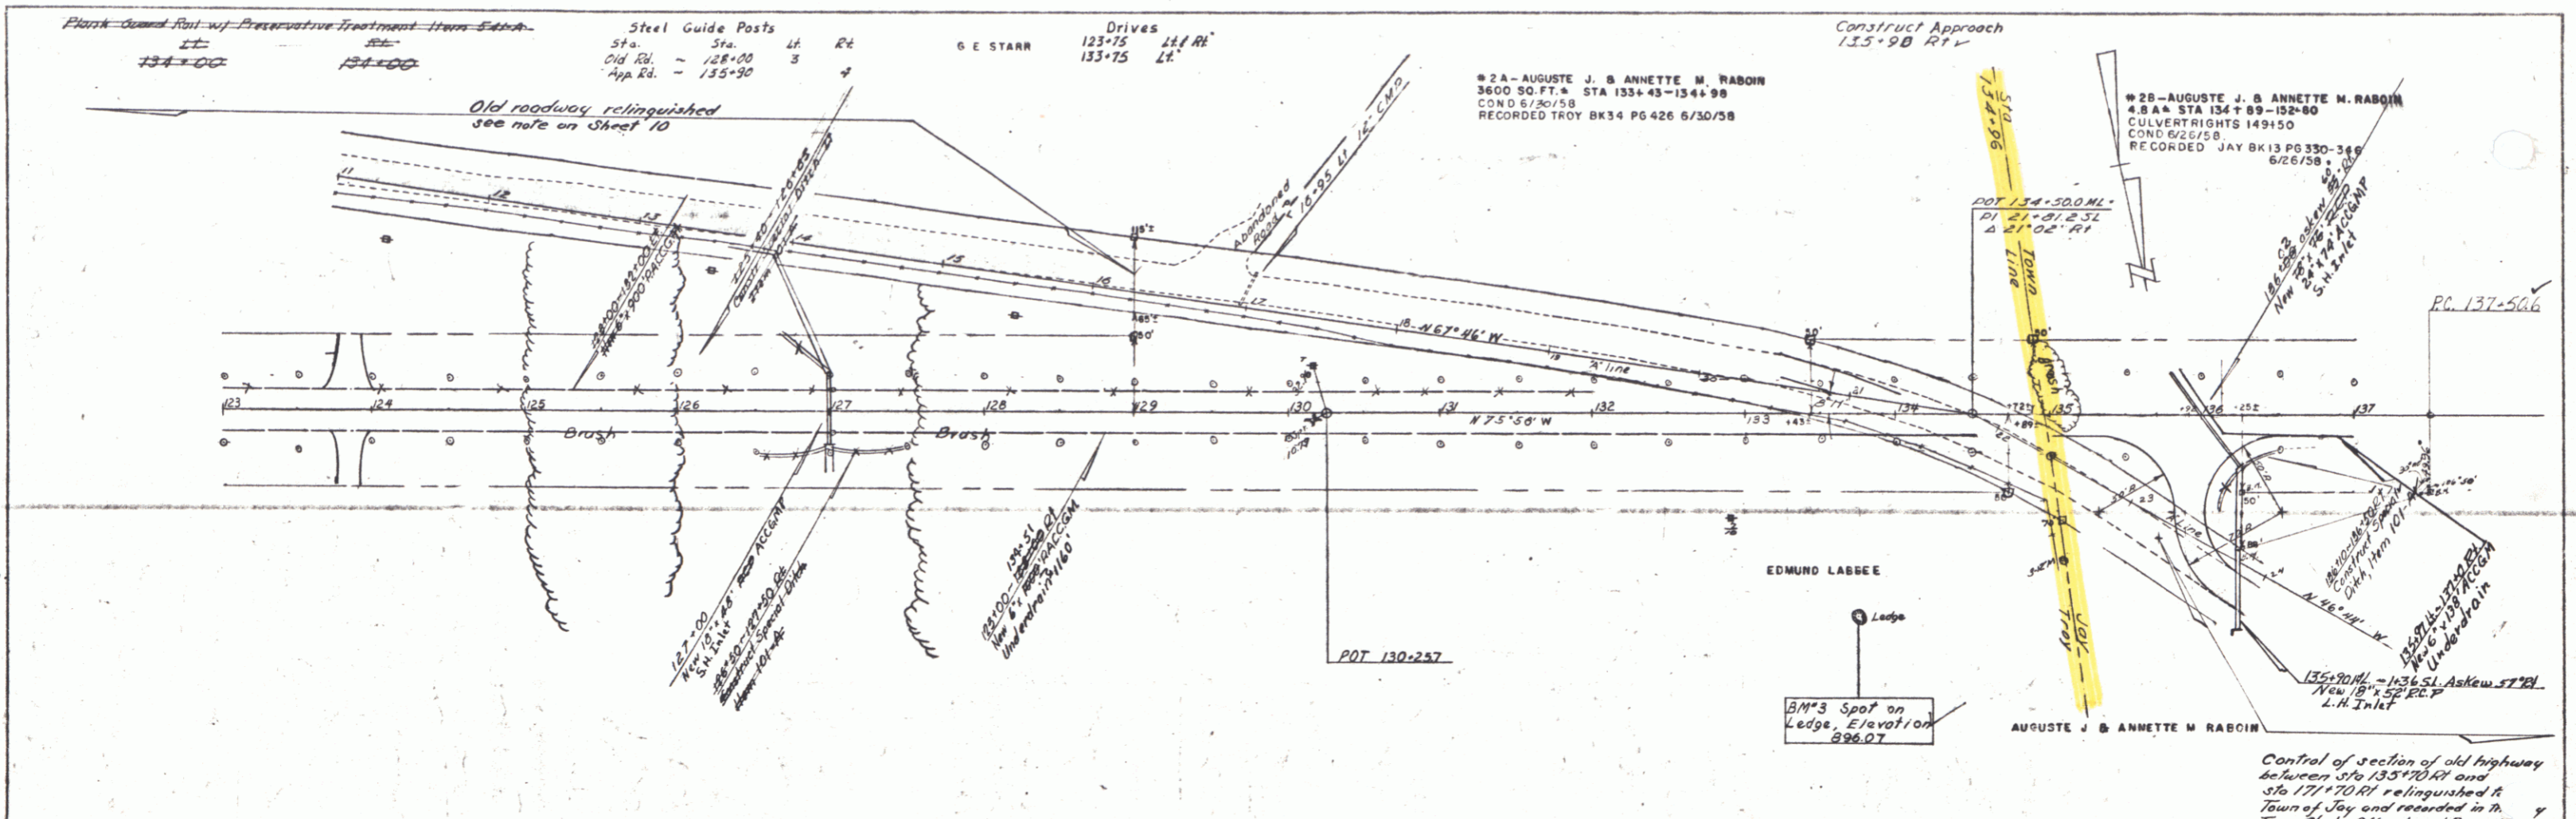

Control of section of old highway between sta 135+78 RT and sta 137+20 RT relinquished to Town of Jay and recorded in Town Clerk's Office Land Records Book 13 Page 364 & 365 dated Nov 11 1959