



PLAN
 DATE: 10/23/89
 DRAWN BY: JAY
 CHECKED BY: JAY
 PROJECT: 1034-2(3)
 SHEET: 12 OF 15

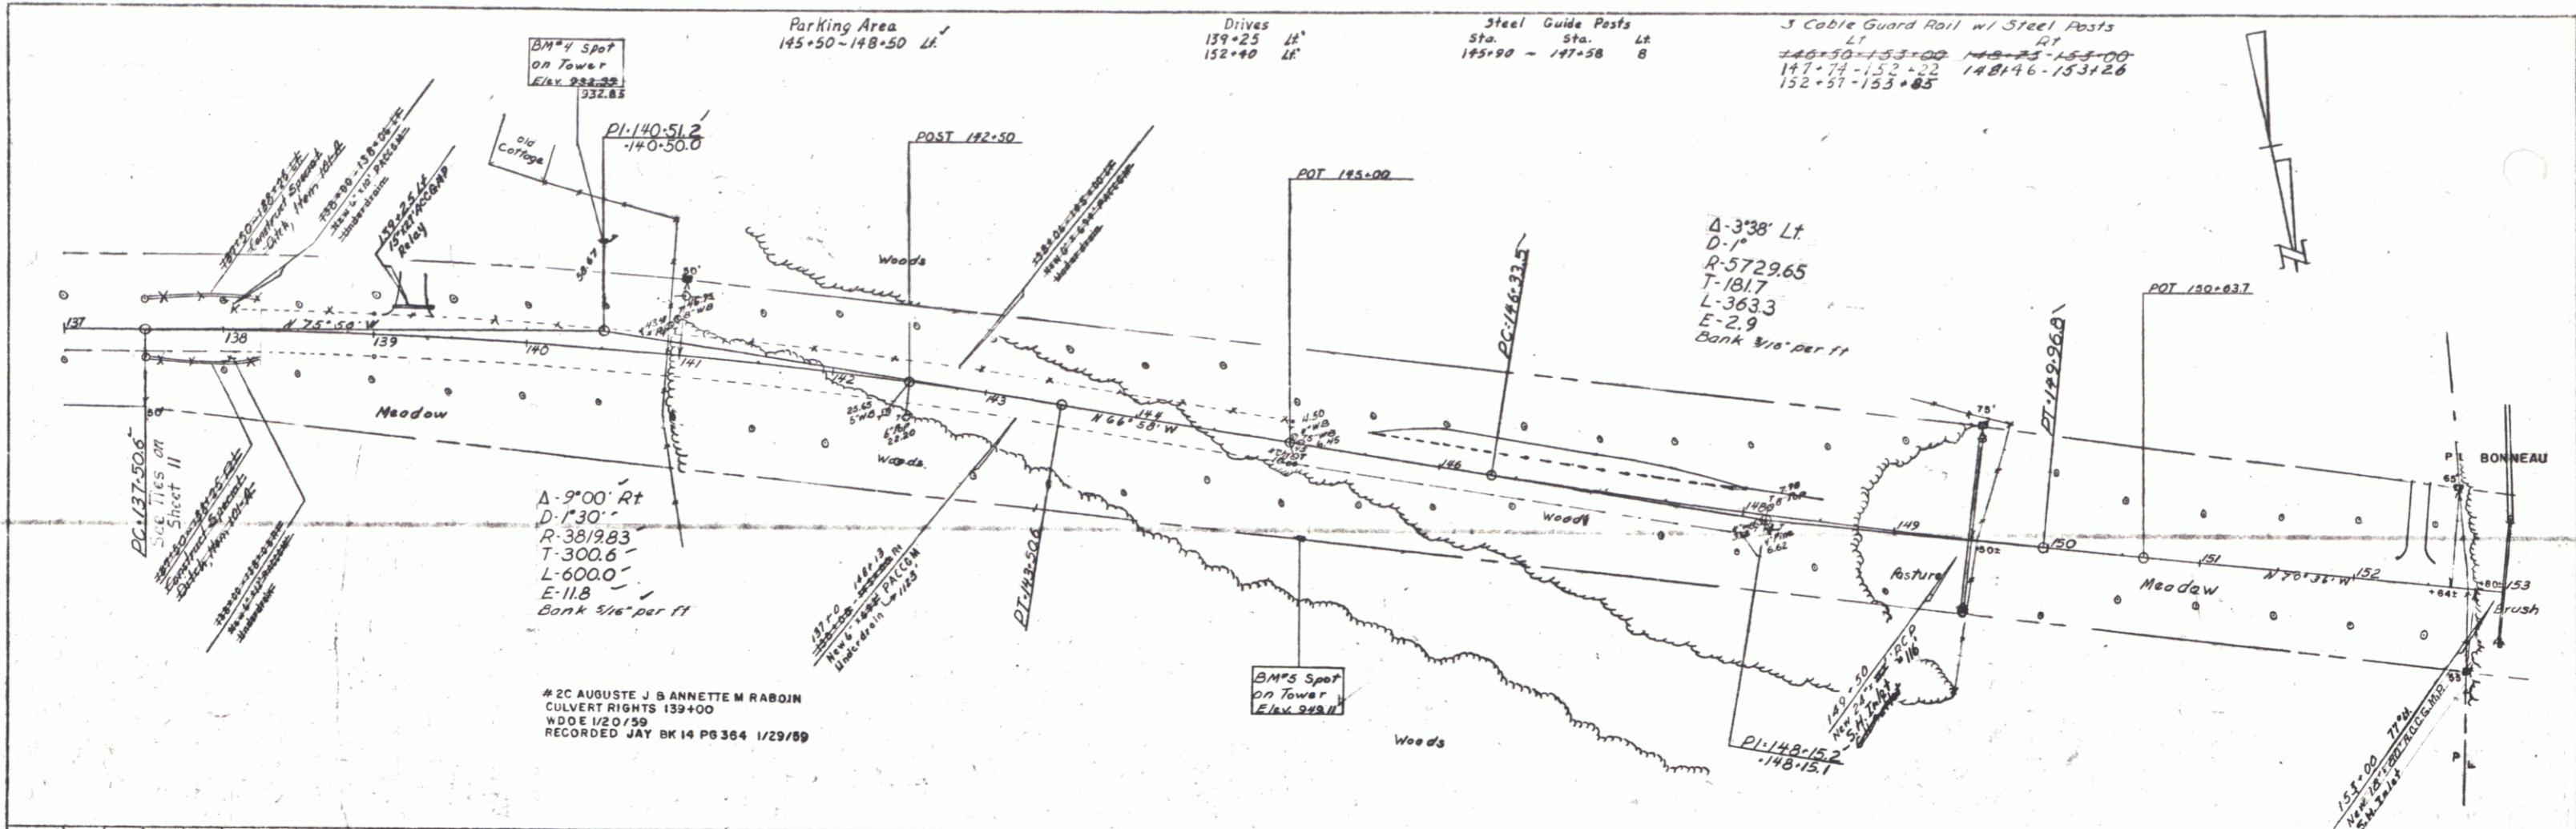

PROFILE
 DATE: 10/23/89
 DRAWN BY: JAY
 CHECKED BY: JAY
 PROJECT: 1034-2(3)
 SHEET: 12 OF 15

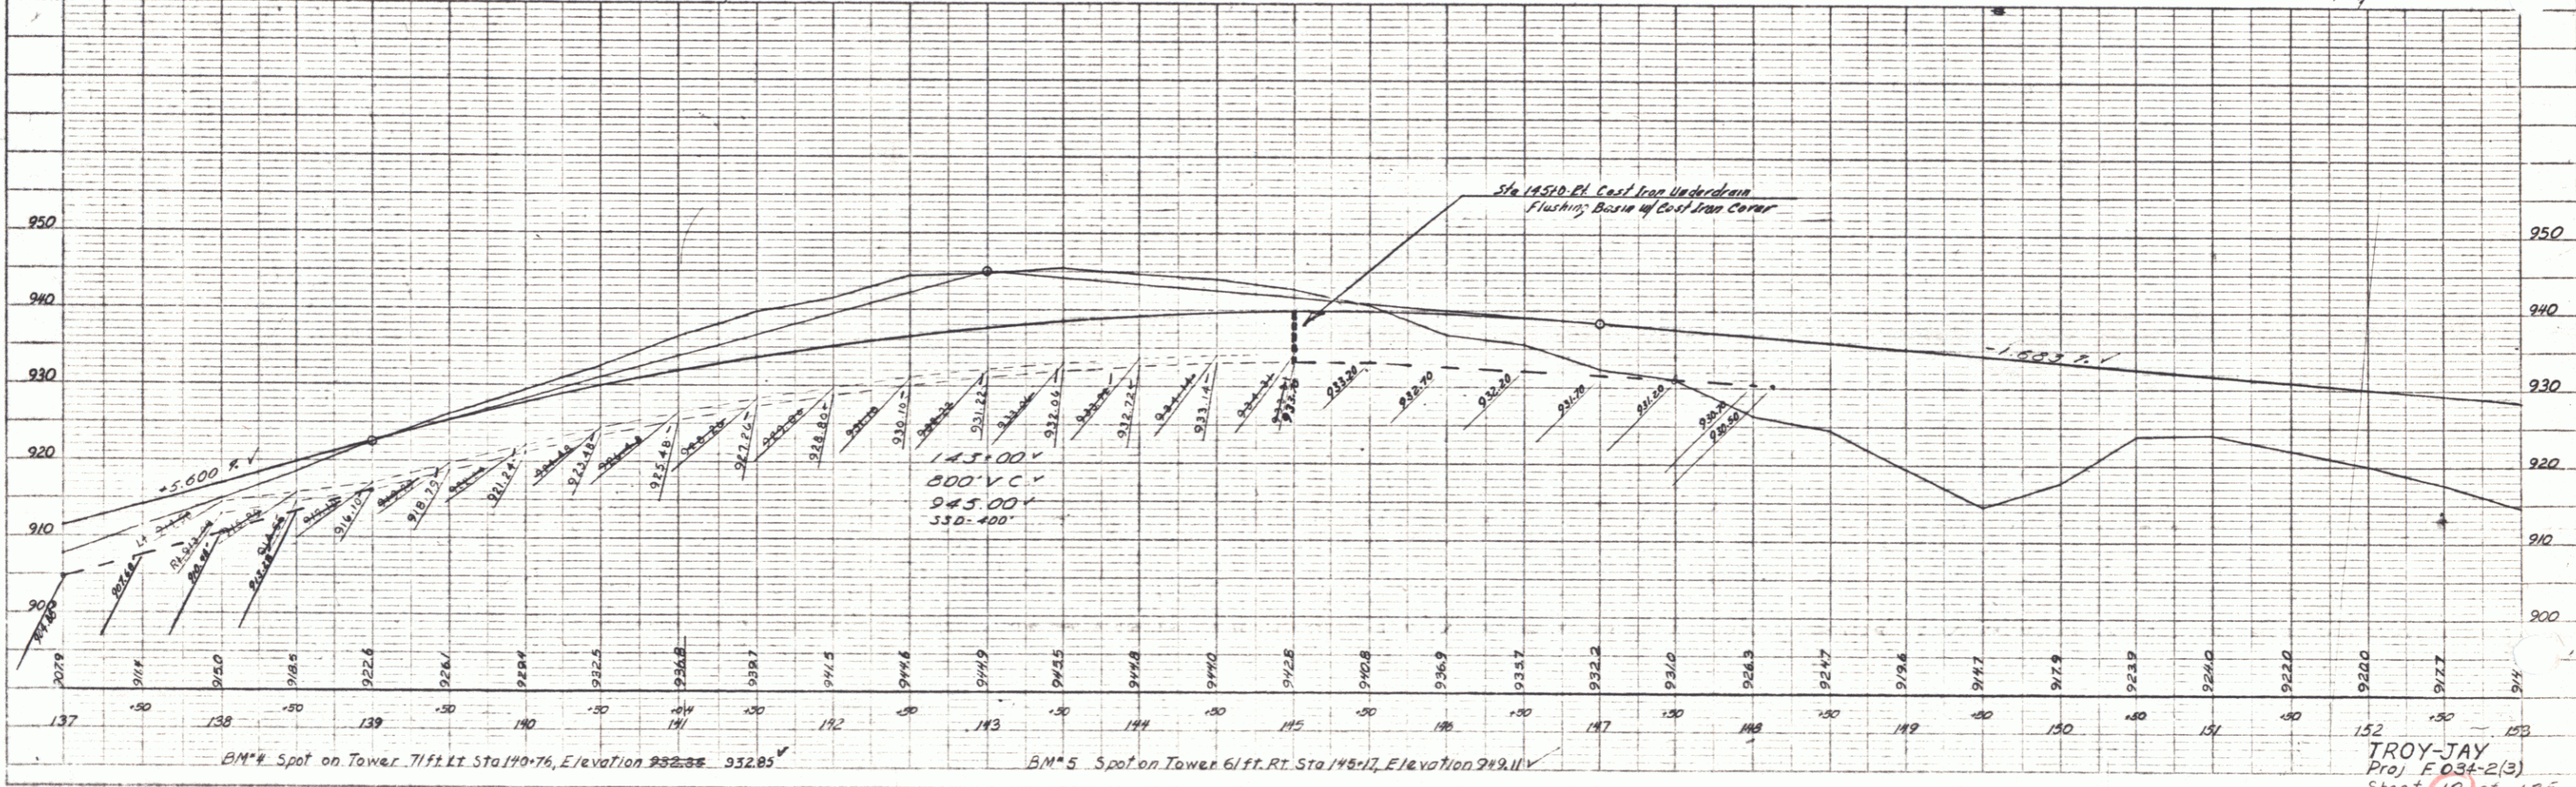

TROY-JAY
 Proj E034-2(3)
 Sheet 12 of 15

PLATE 1 - PLAN - PROFILE
 DATE: 10/23/89
 DRAWN BY: JAY
 CHECKED BY: JAY
 PROJECT: 1034-2(3)
 SHEET: 12 OF 15