


PLAN  
 DATE 8-31-58  
 BY J. JAY  
 CHECKED BY J. JAY  
 NOTE BOOK IS SHOWN CHECKED BY J. JAY  
 NO. 1

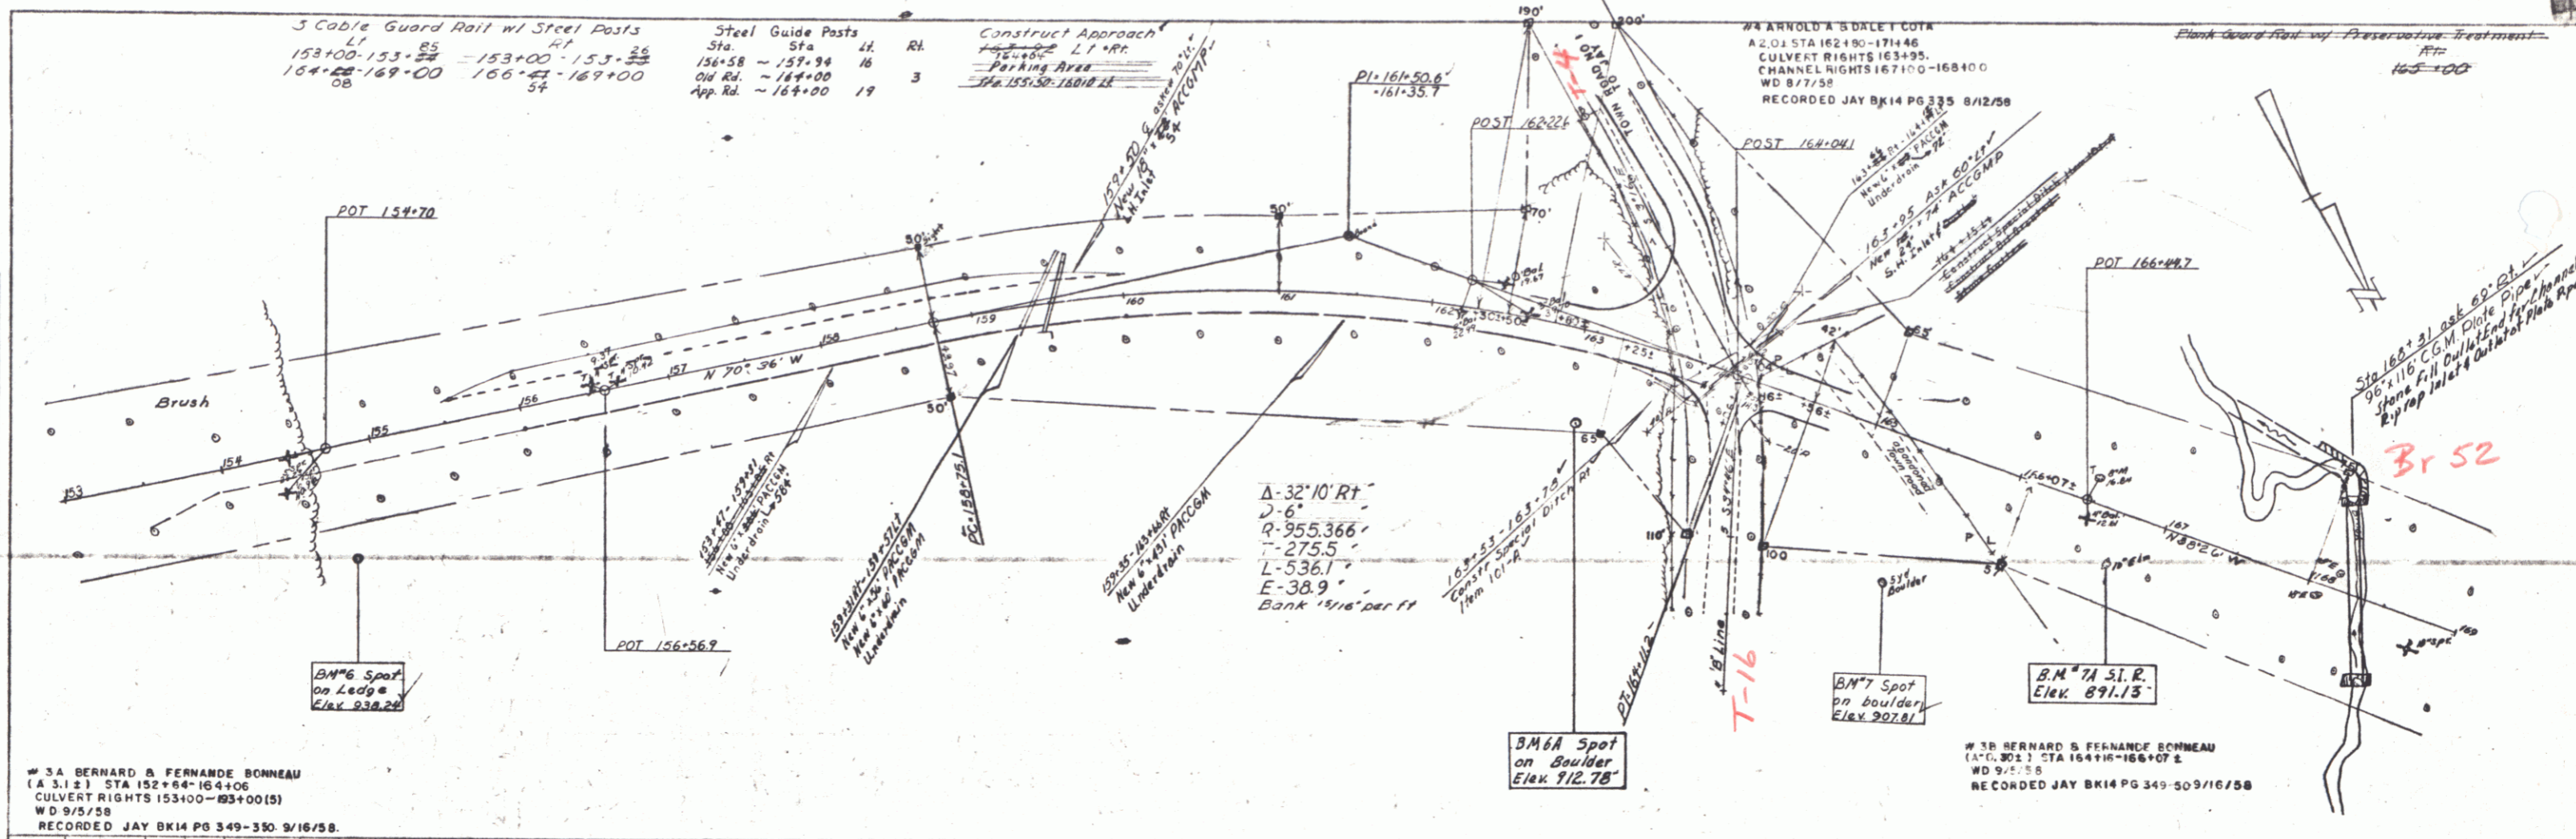

PROFILE  
 DATE 8-31-58  
 BY J. JAY  
 CHECKED BY J. JAY  
 NOTE BOOK IS SHOWN CHECKED BY J. JAY  
 NO. 1

