

PLAN	DATE	BY
DATE	BY	BY
DATE	BY	BY
DATE	BY	BY

PROFILE	DATE	BY
DATE	BY	BY
DATE	BY	BY
DATE	BY	BY

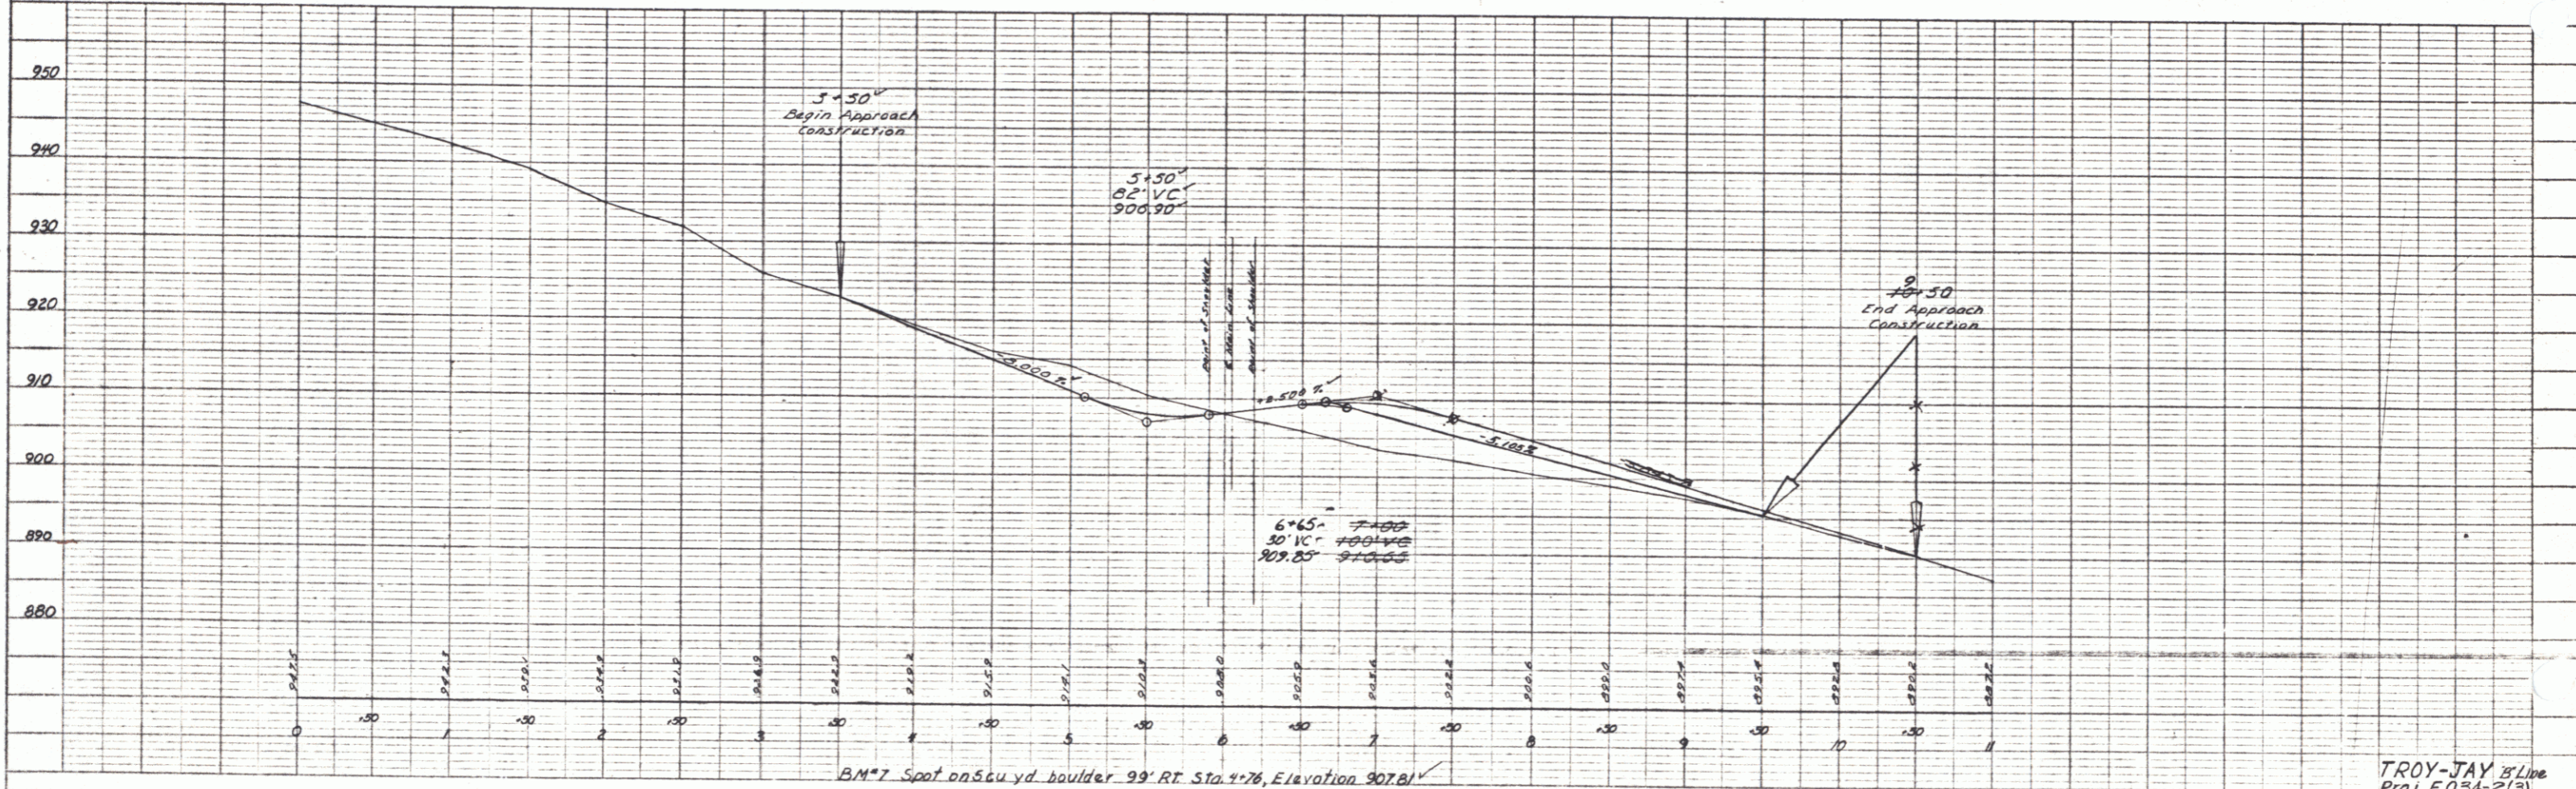
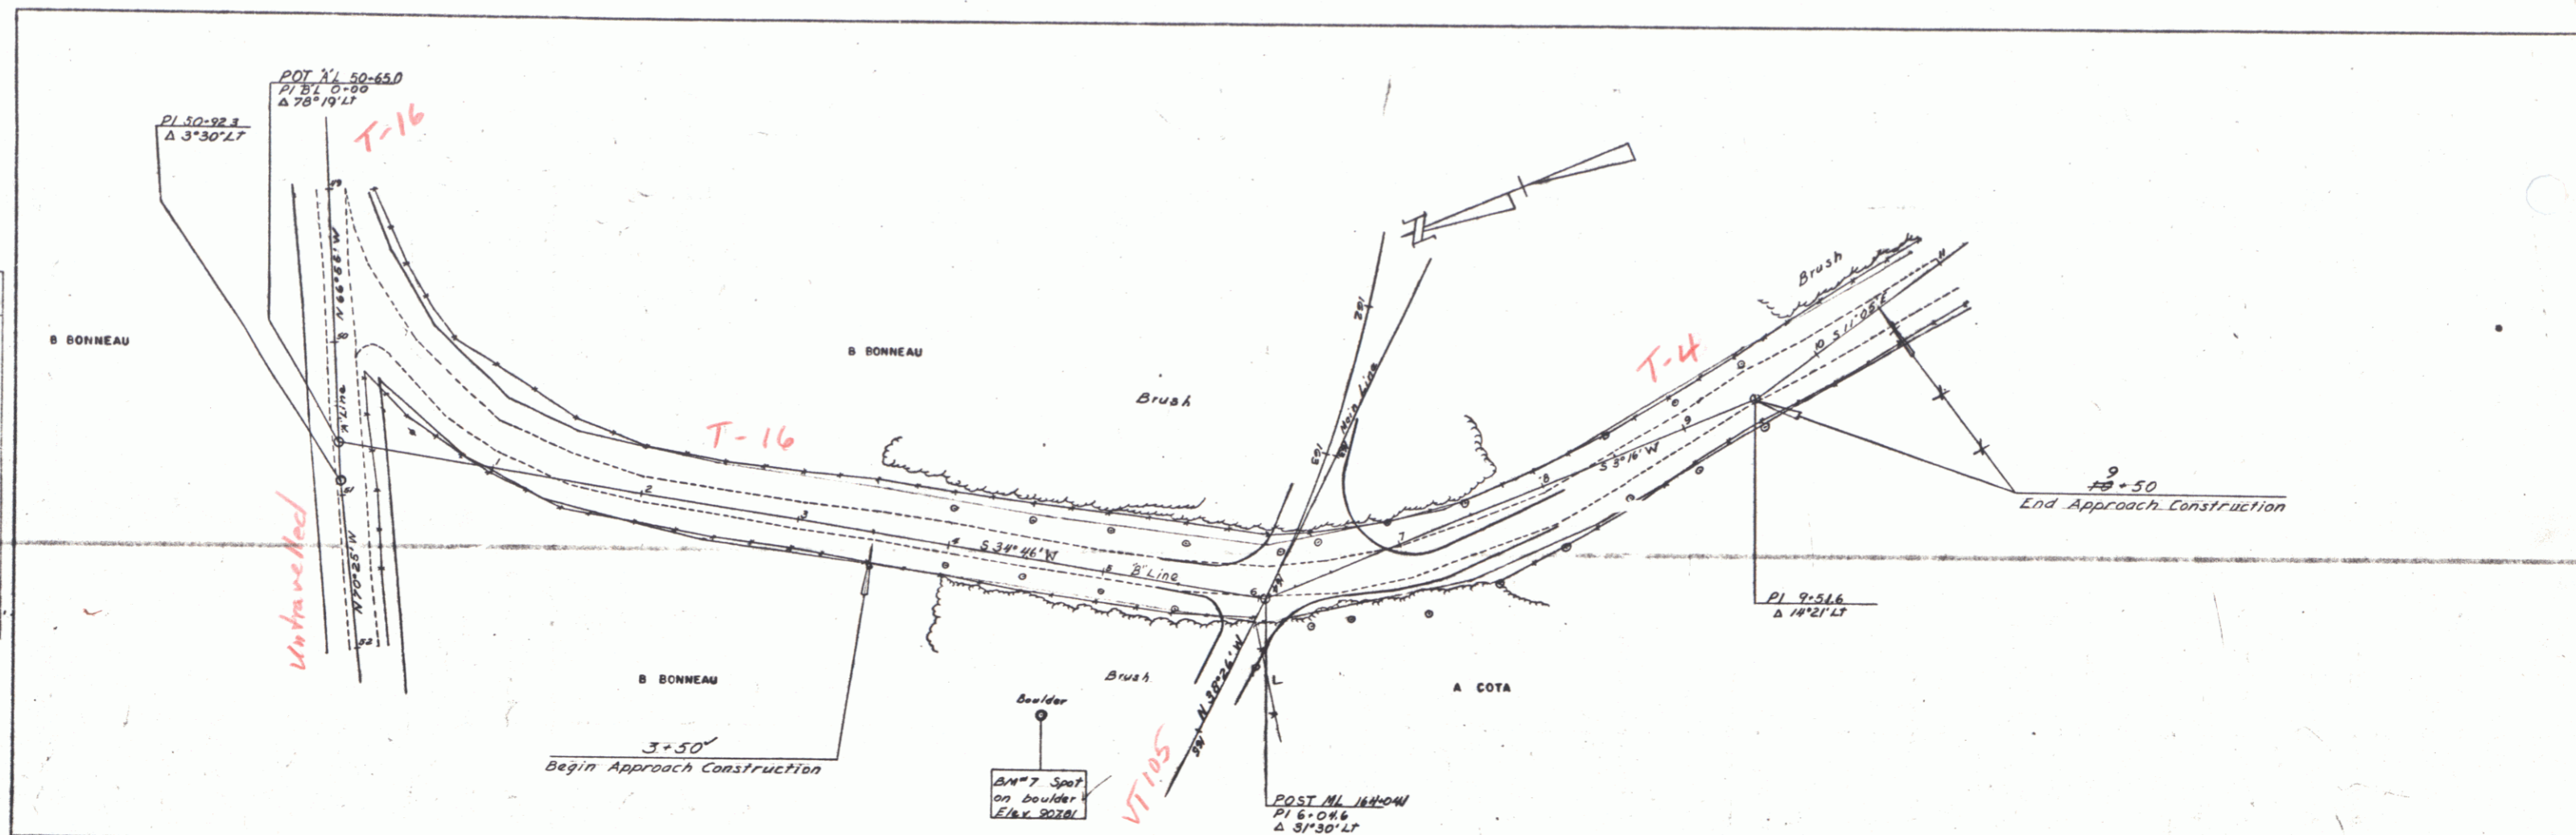


PLATE 1-PLAN-PROFILE OF P. R. & S. BONDARD
 TRUFFY & BONDARD, NEW YORK
 77 E. 10th Street
 NEW YORK

TROY-JAY 2/1/06
 Proj. F034-2(3)
 Sheet 1 of 135

6