
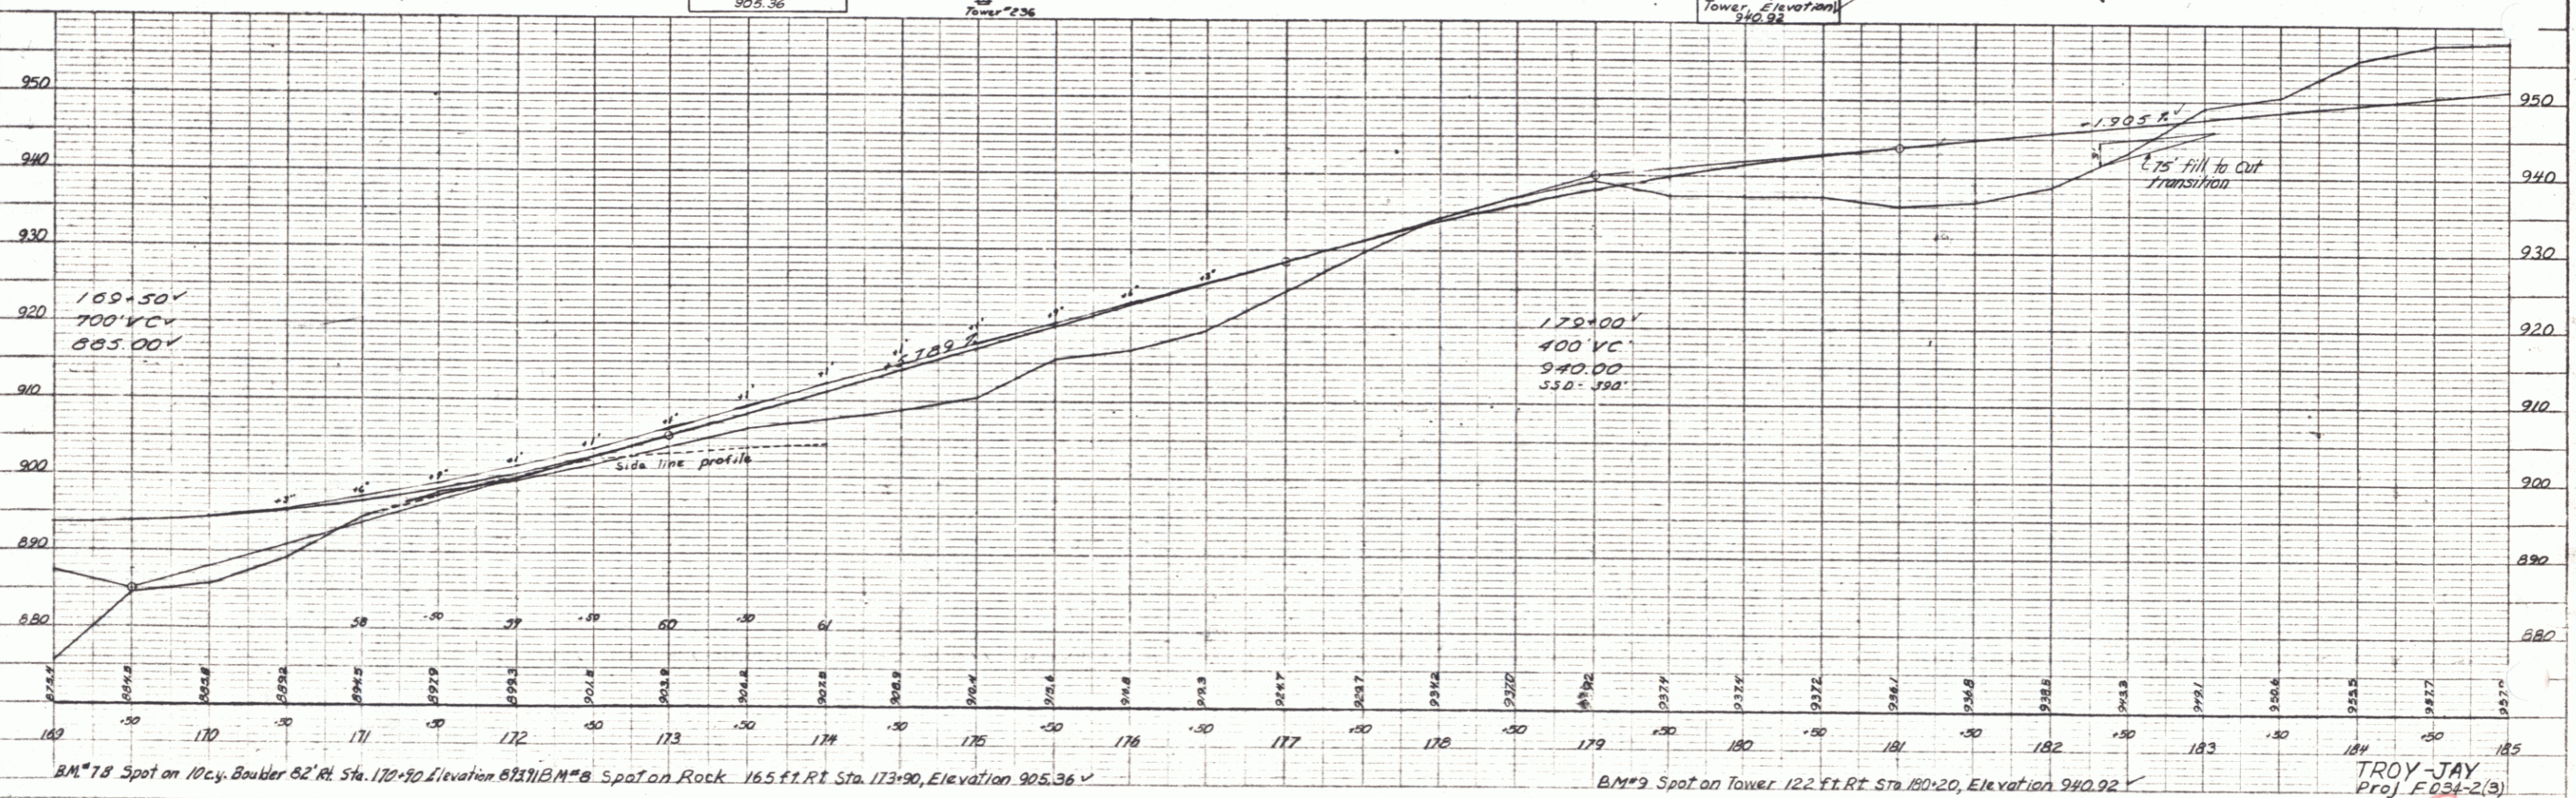


PLAN  
 DATE: 10-27-57  
 DRAWN BY: JAY  
 CHECKED BY: [Signature]  
 IN CHARGE: [Signature]

PROFILE  
 DATE: 10-27-57  
 DRAWN BY: JAY  
 CHECKED BY: [Signature]  
 IN CHARGE: [Signature]

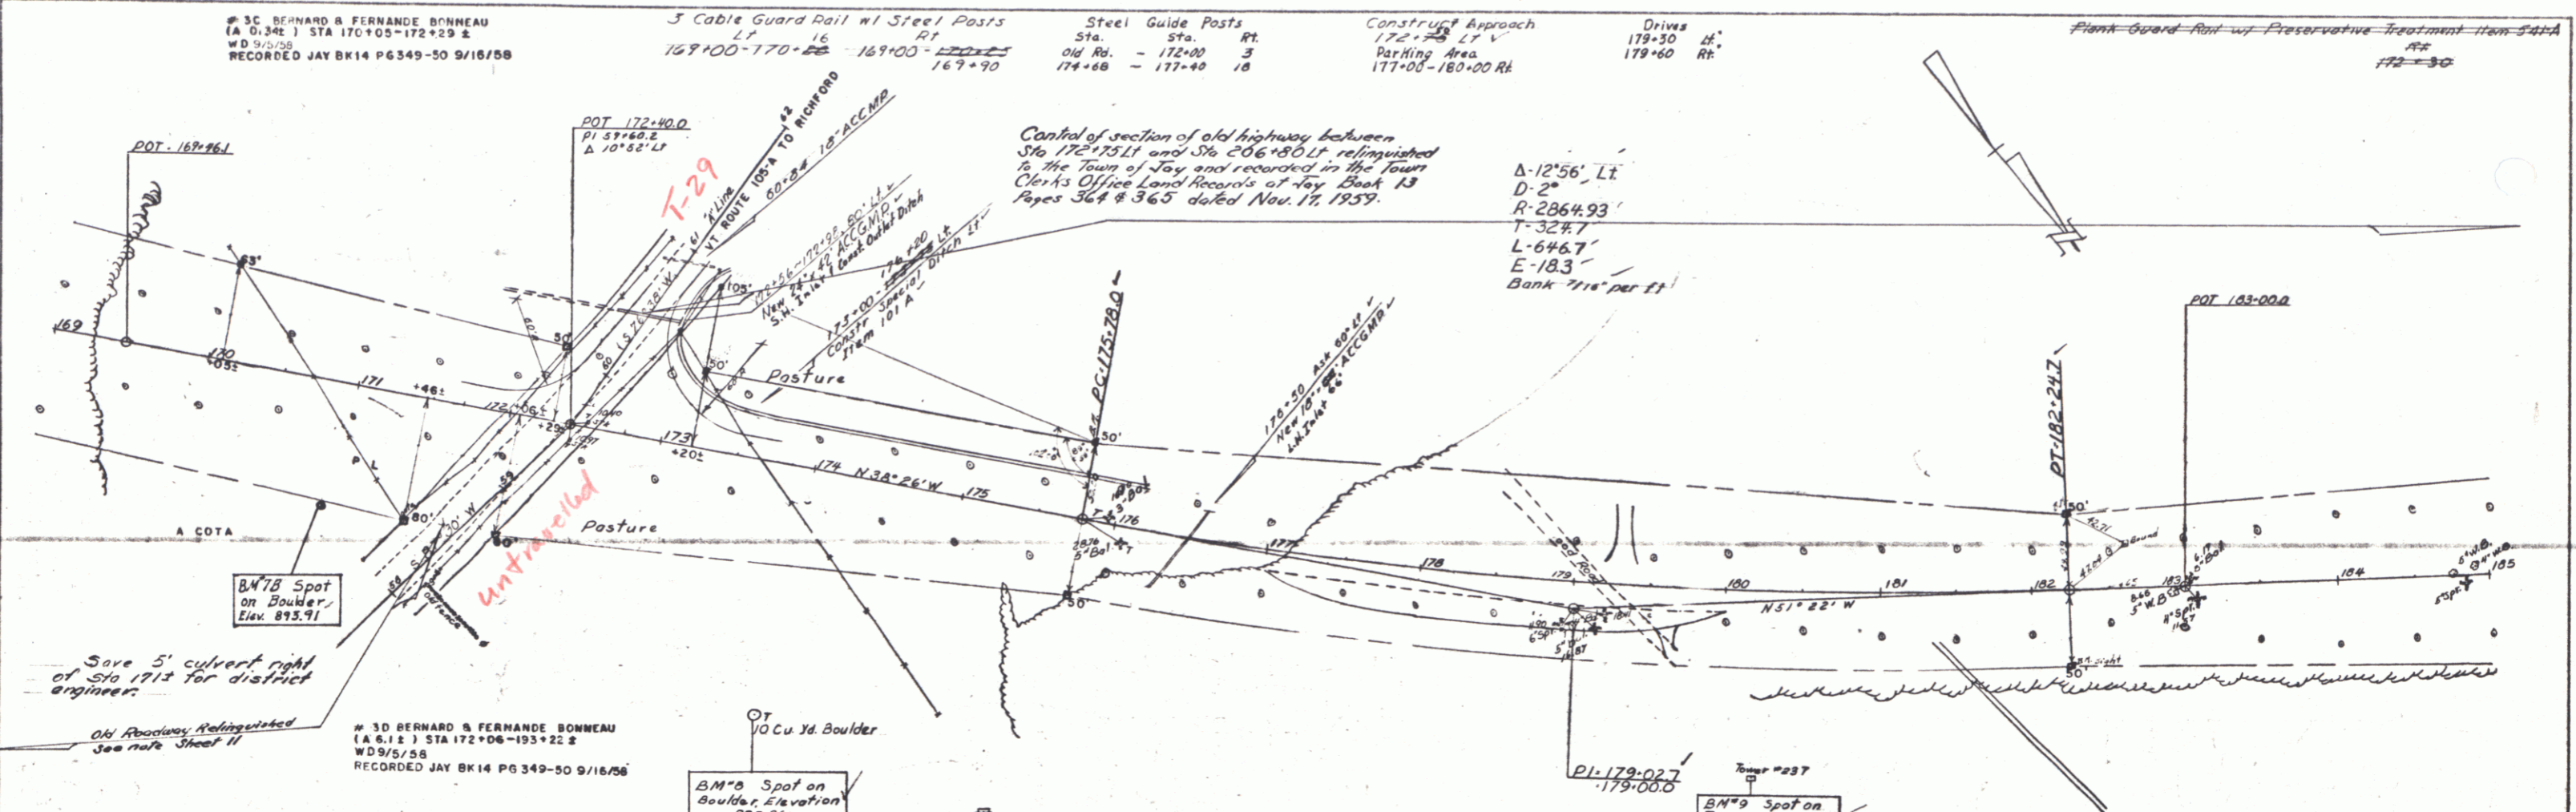

BM # 78 Spot on 10cy Boulder 62 ft. Sta. 170+90, Elevation 871.71, BM # B Spot on Rock 16.5 ft. Rt. Sta. 173+90, Elevation 905.36

BM # 9 Spot on Tower 122 ft. Rt. Sta. 180+20, Elevation 940.92

TROY-JAY  
 Proj. F034-2(3)  
 Sheet 15 of 125

PLATE 1 - PLAN PROFILE  
 CONSULT: [Signature]  
 DESIGN: [Signature]  
 CHECK: [Signature]  
 DATE: 10-27-57