
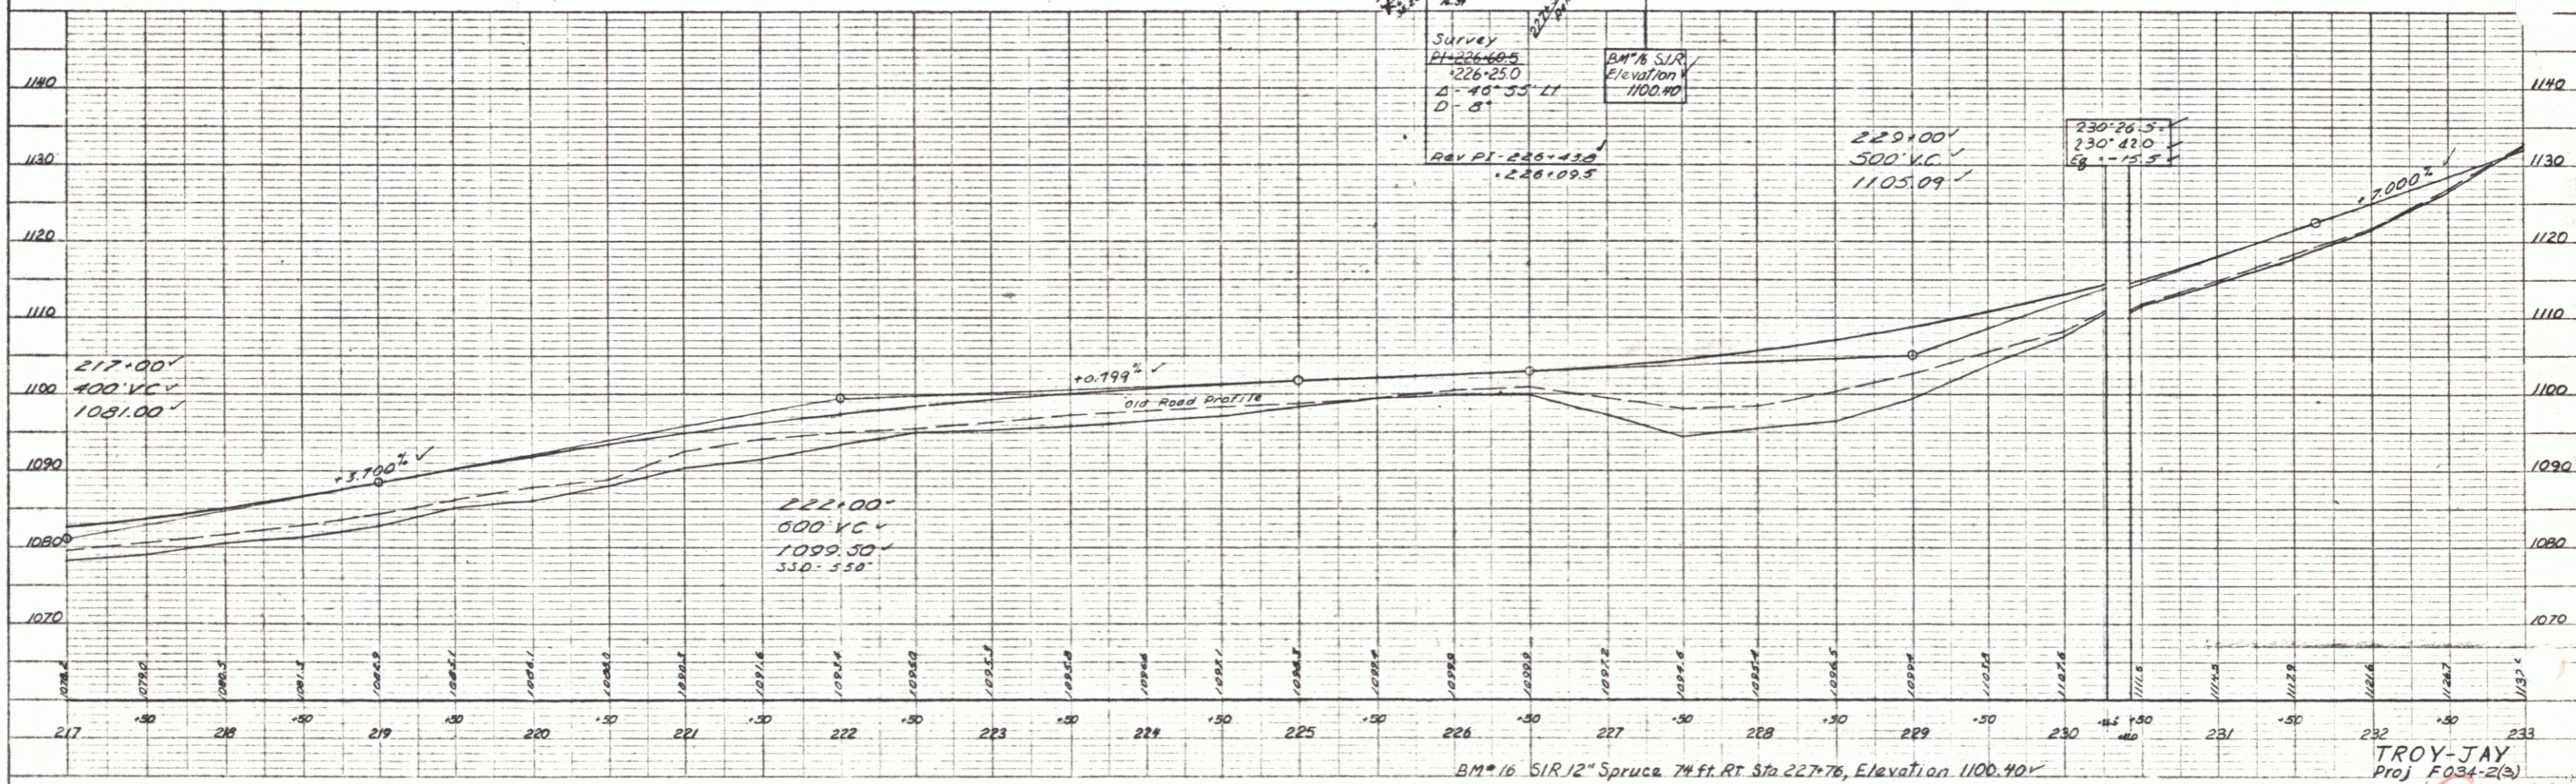


PLAN
 DRAWN BY: [Signature]
 CHECKED BY: [Signature]
 DATE: 8-31-57

PROFILE
 DRAWN BY: [Signature]
 CHECKED BY: [Signature]
 DATE: 8-31-57

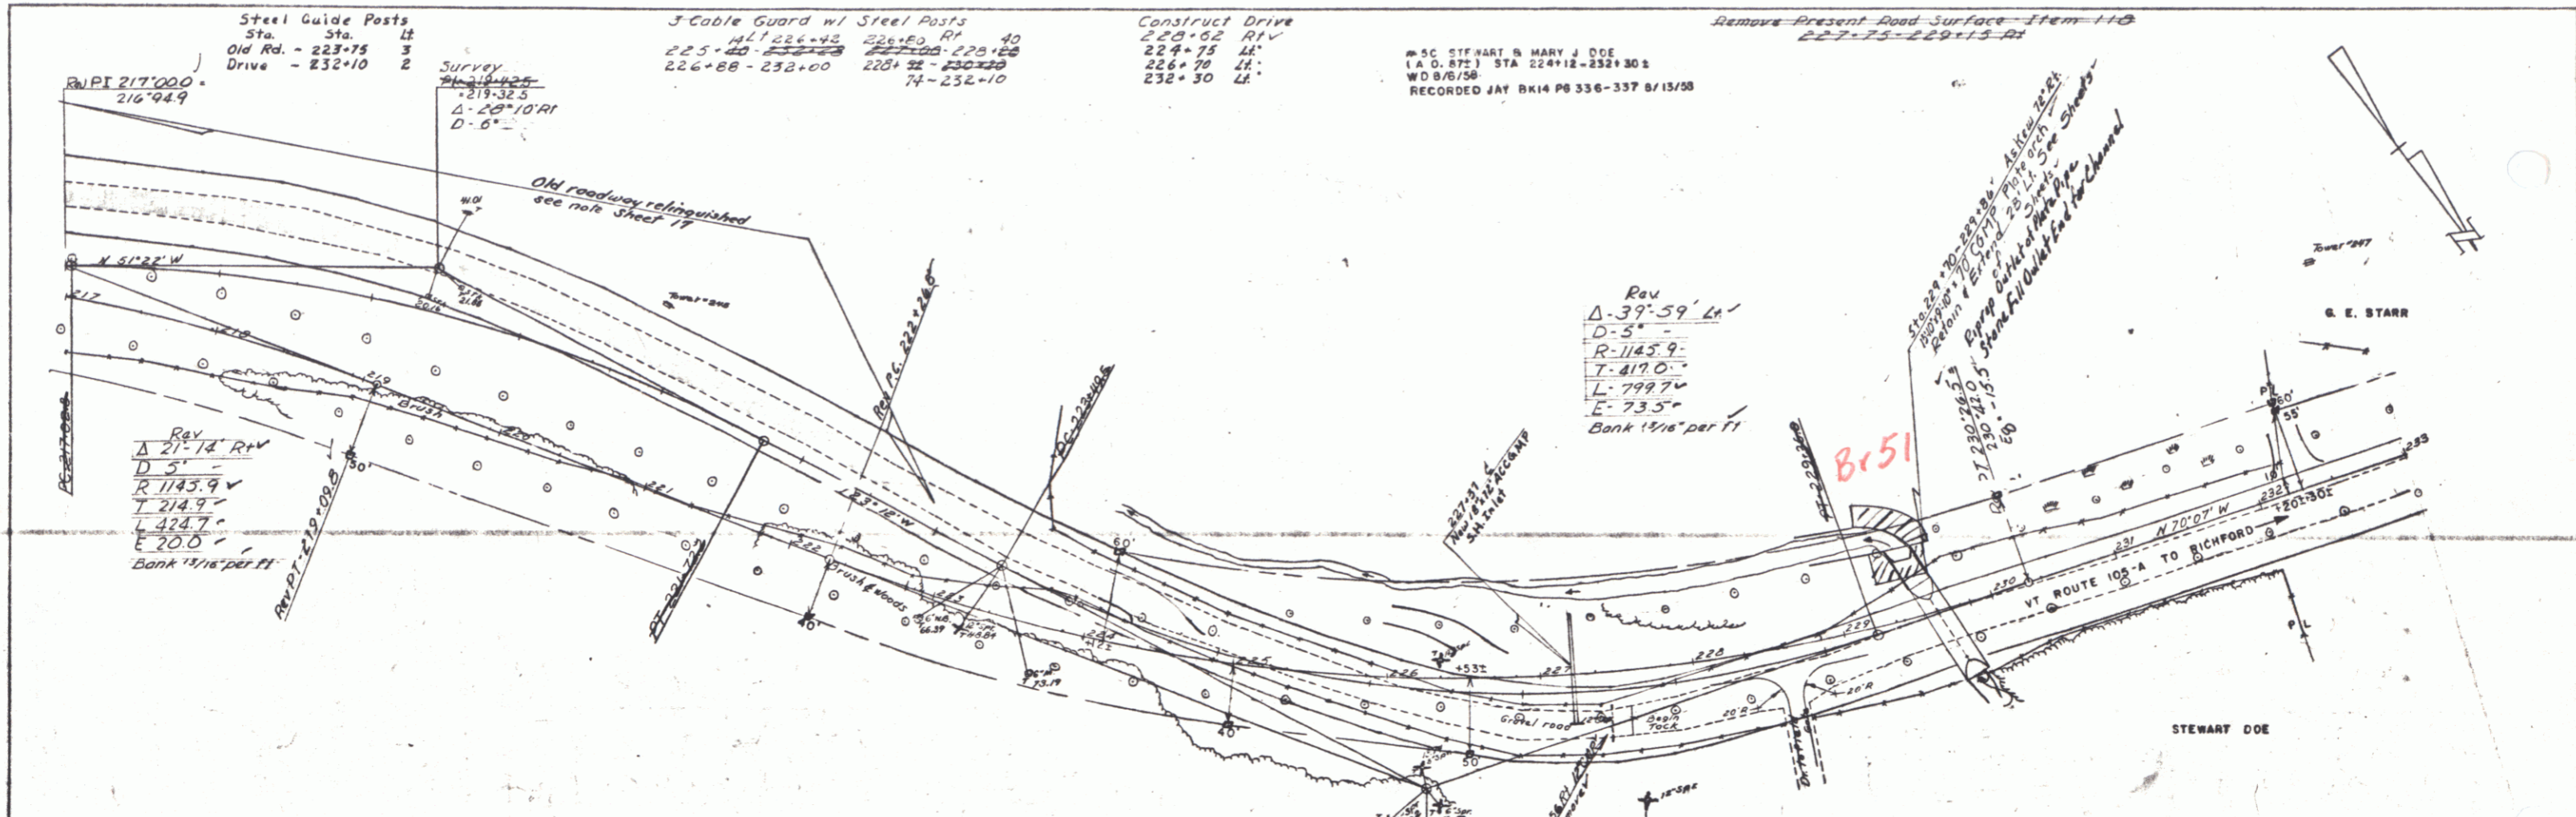

TROY-JAY
 Proj F034-2(3)
 Sheet 18 of 135