
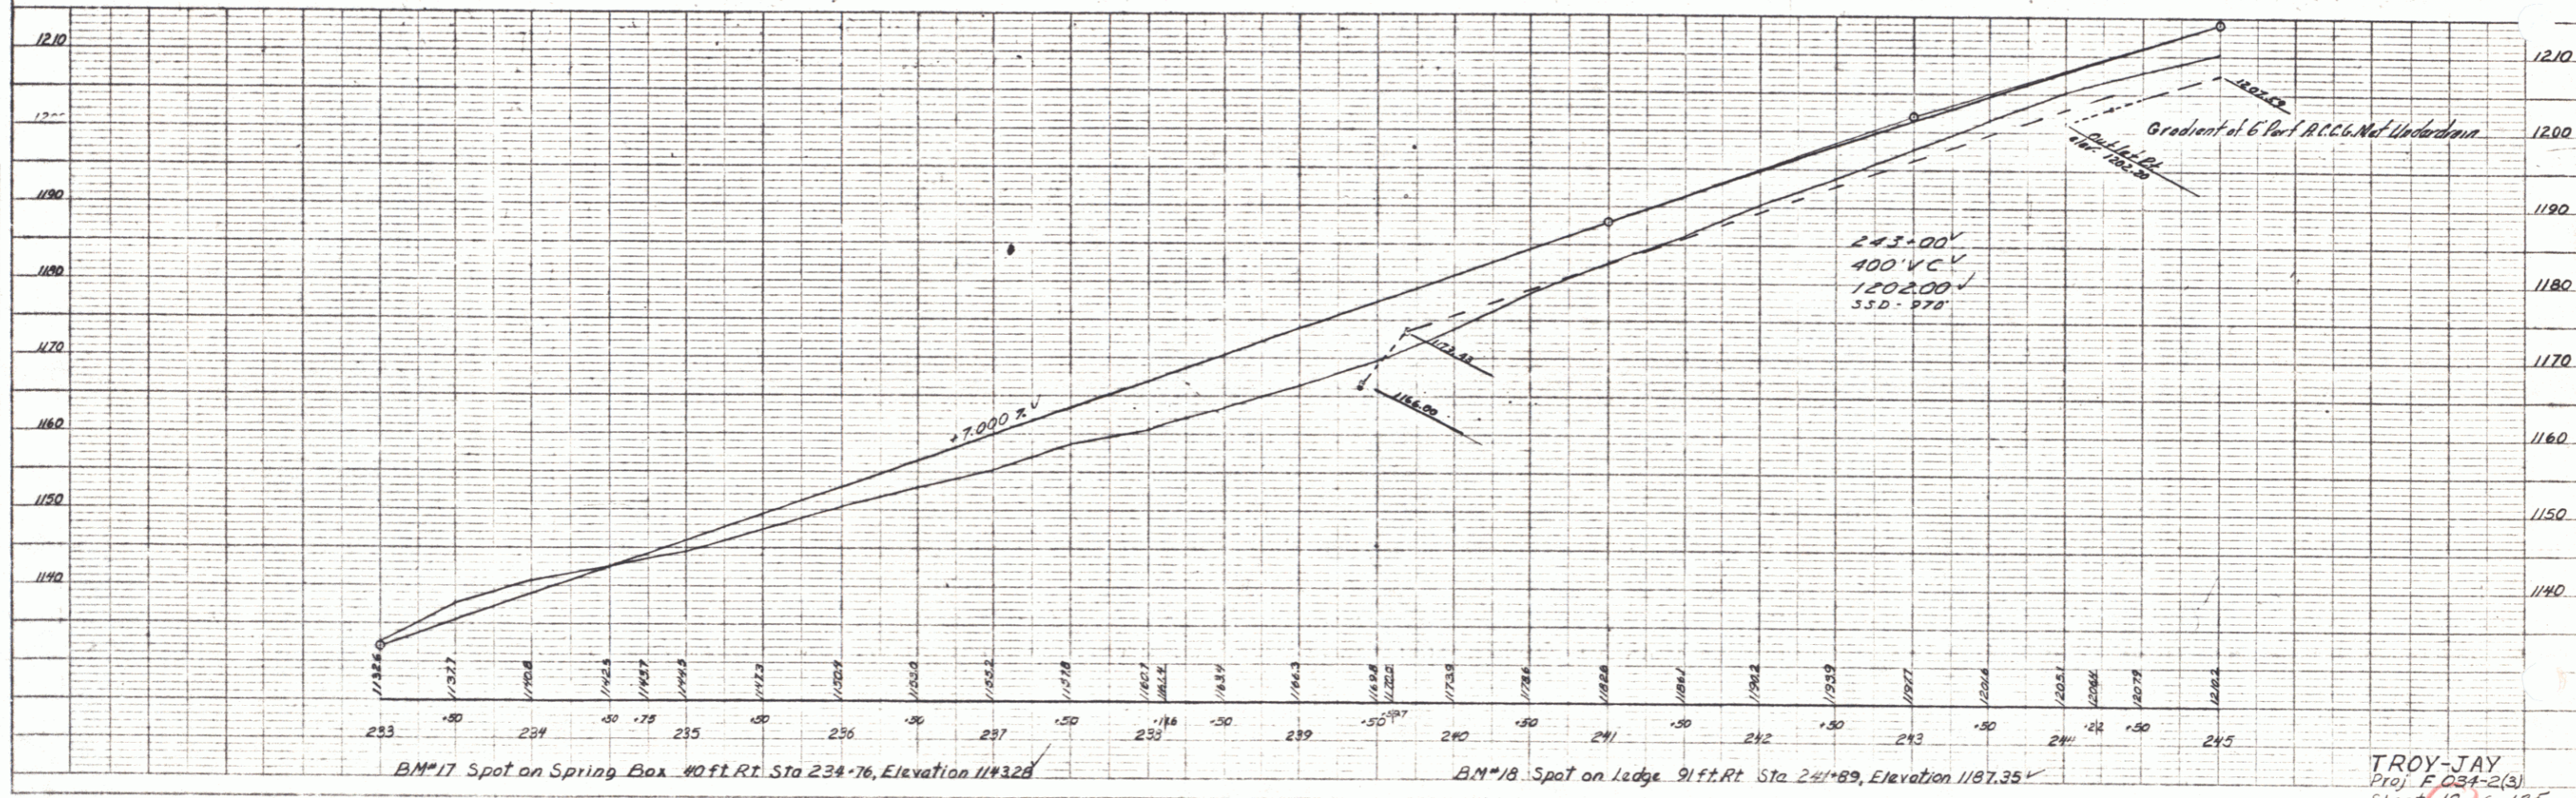


PLAN  
 NOTE BOOK NO. 1000  
 CHECKED BY  
 DATE  
 DRAWN BY  
 DATE

PROFILE  
 NOTE BOOK NO. 1000  
 CHECKED BY  
 DATE  
 DRAWN BY  
 DATE

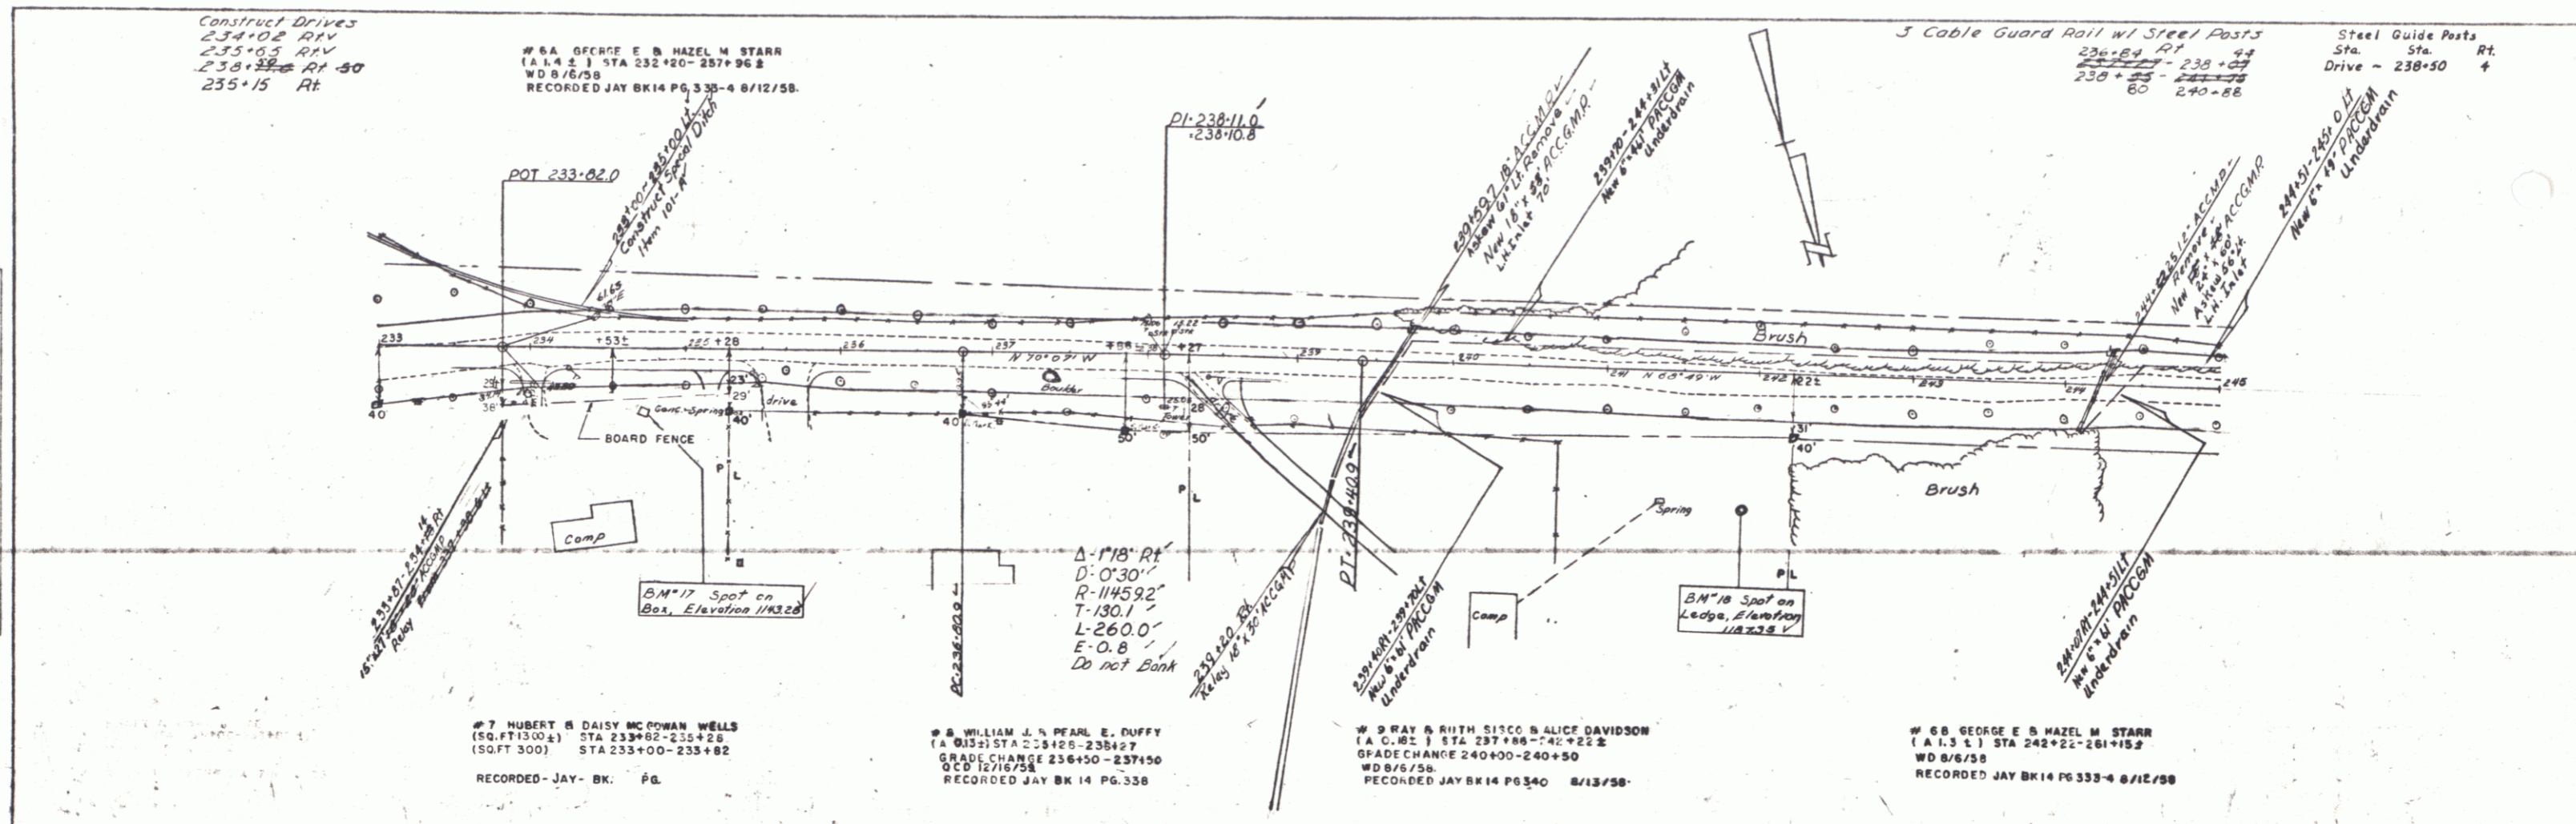

TROY-JAY  
 Proj. F 034-2(3)  
 Sheet 19 of 185

PLATE 1 - PLAN-PROFILE  
 REUTEL & ROSE CO., NEW YORK  
 110 N. 34th ST.  
 NEW YORK, N.Y.