


PLAN
DATE: 8-31-37
BY: [Signature]
CHECKED: [Signature]
NOTE: [Text]

PROFILE
DATE: 8-31-37
BY: [Signature]
CHECKED: [Signature]
NOTE: [Text]

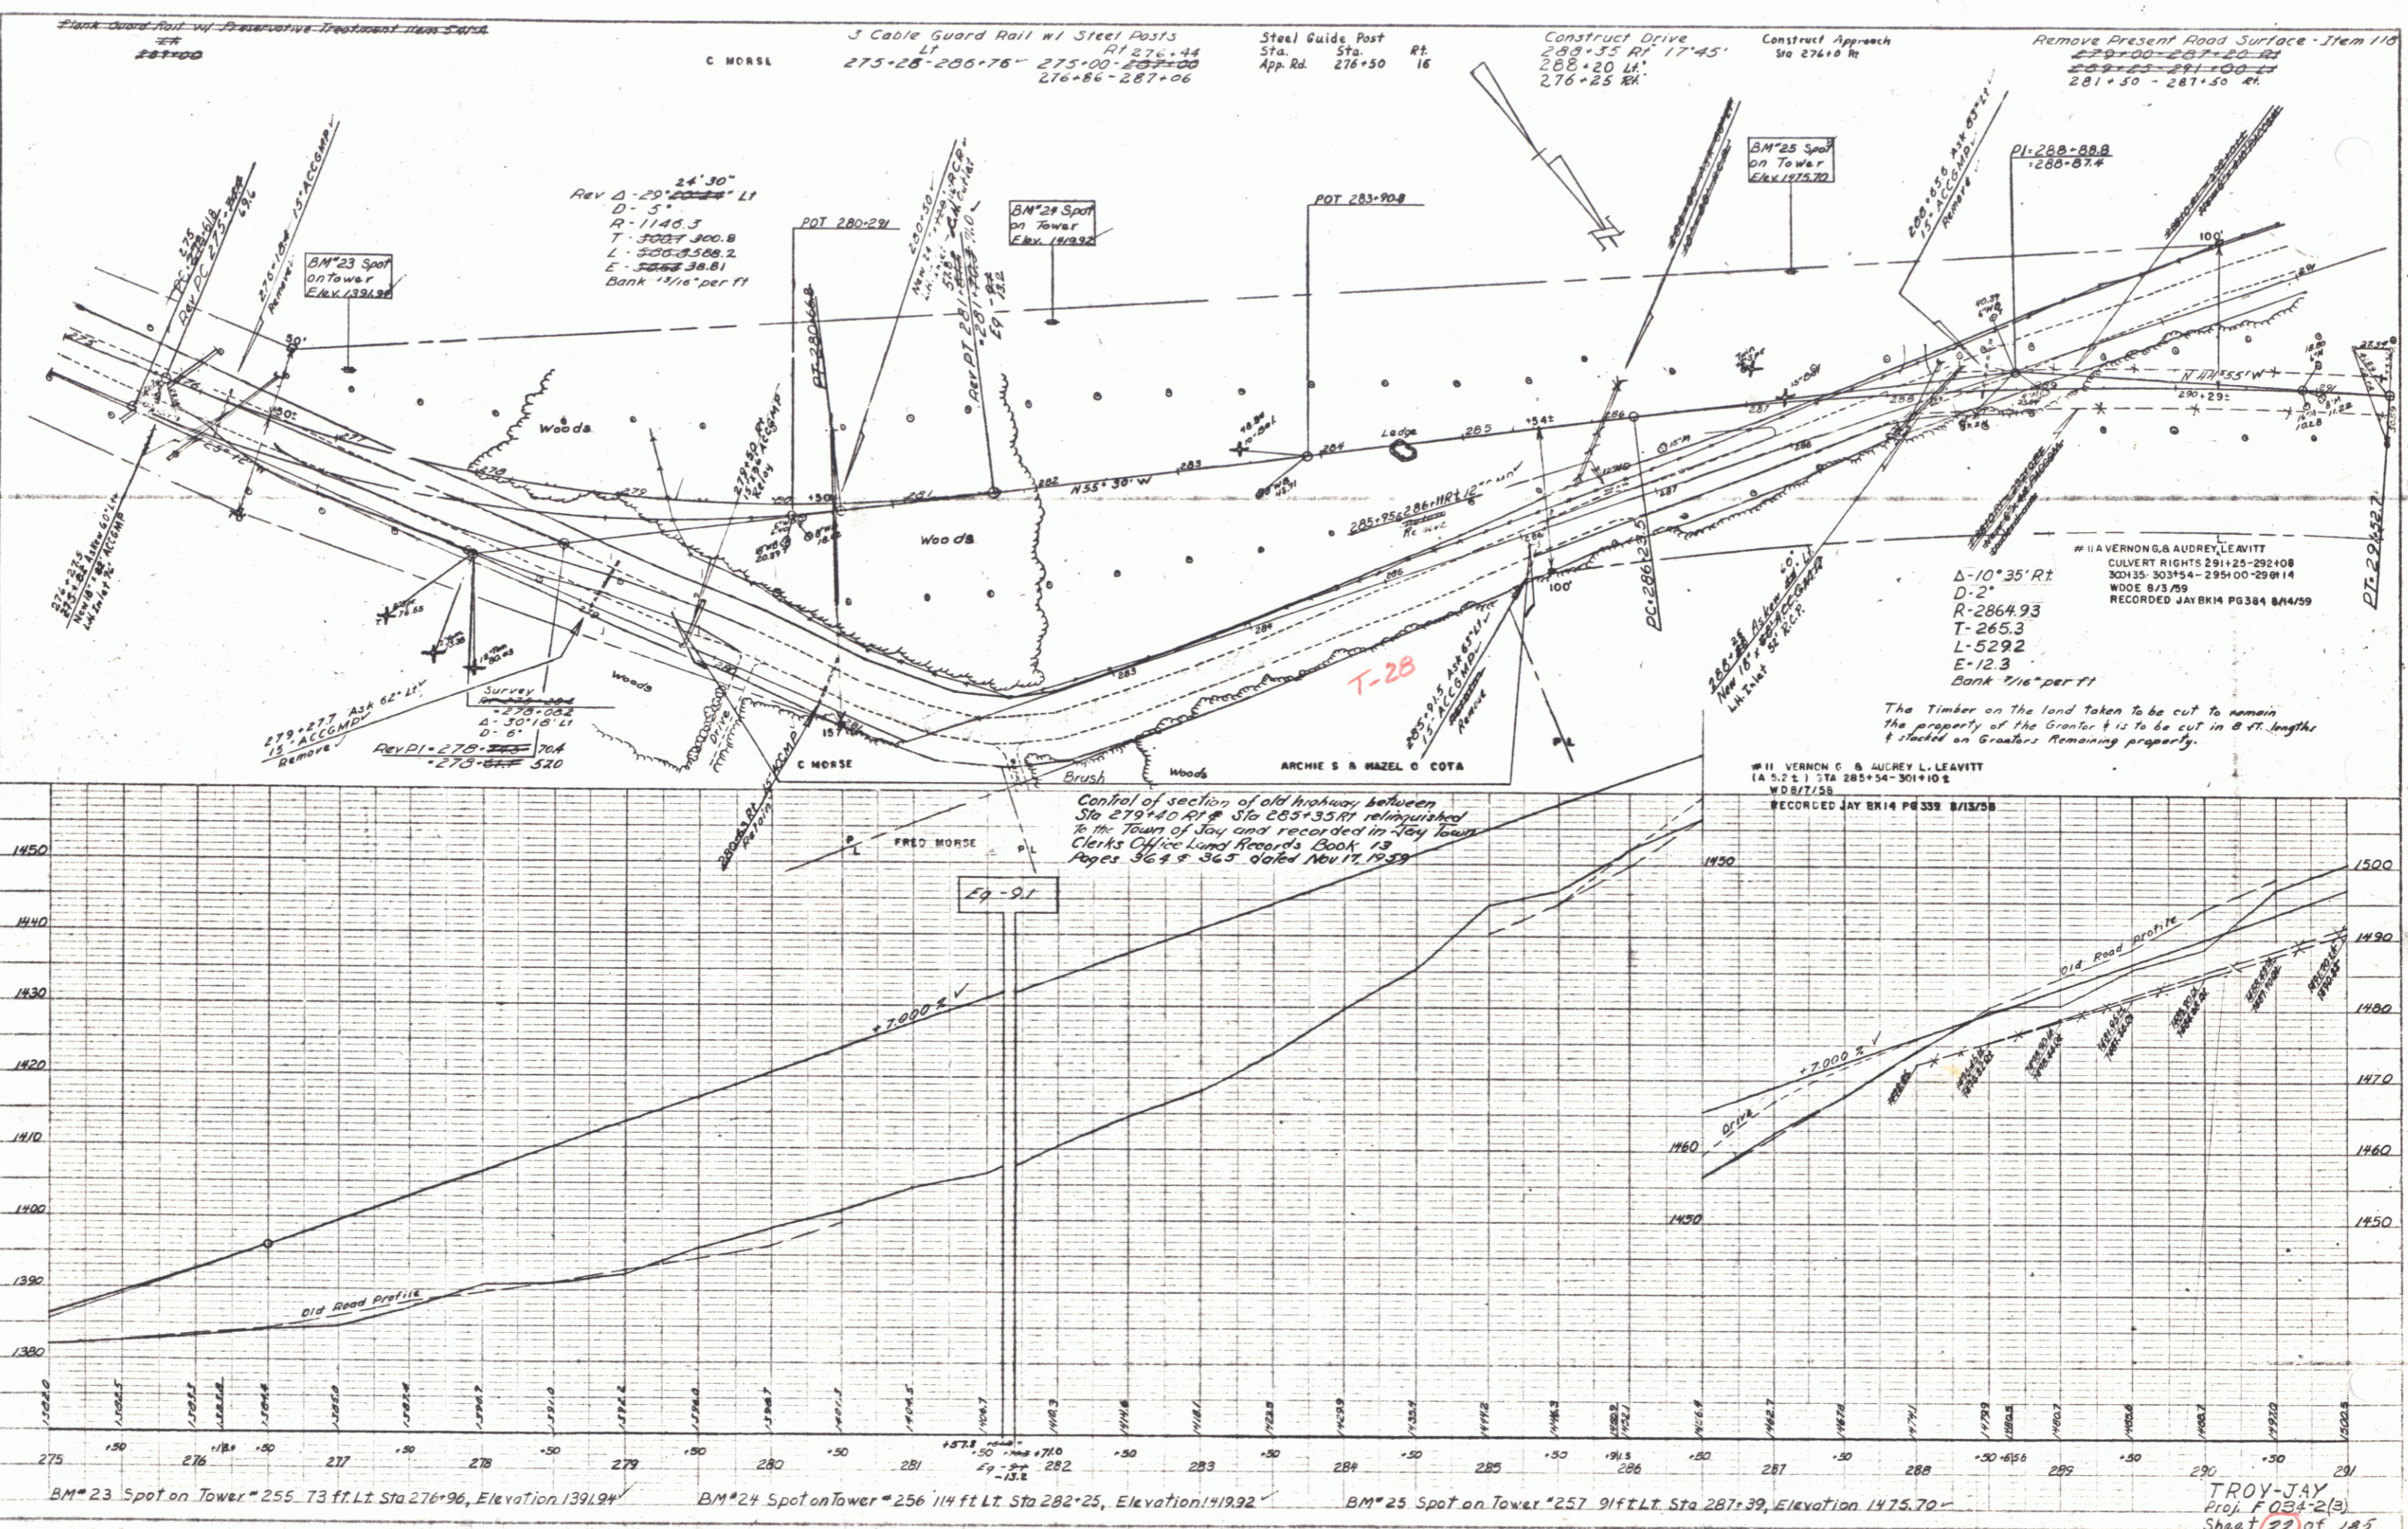

TROY-JAY
Proj. F 034-2(B)
Sheet 22 of 185