

PLAN
 DATE: 8/26/58
 DRAWN BY: JAY
 CHECKED BY: JAY
 SCALE: AS SHOWN

PROFILE
 DATE: 8/26/58
 DRAWN BY: JAY
 CHECKED BY: JAY
 SCALE: AS SHOWN

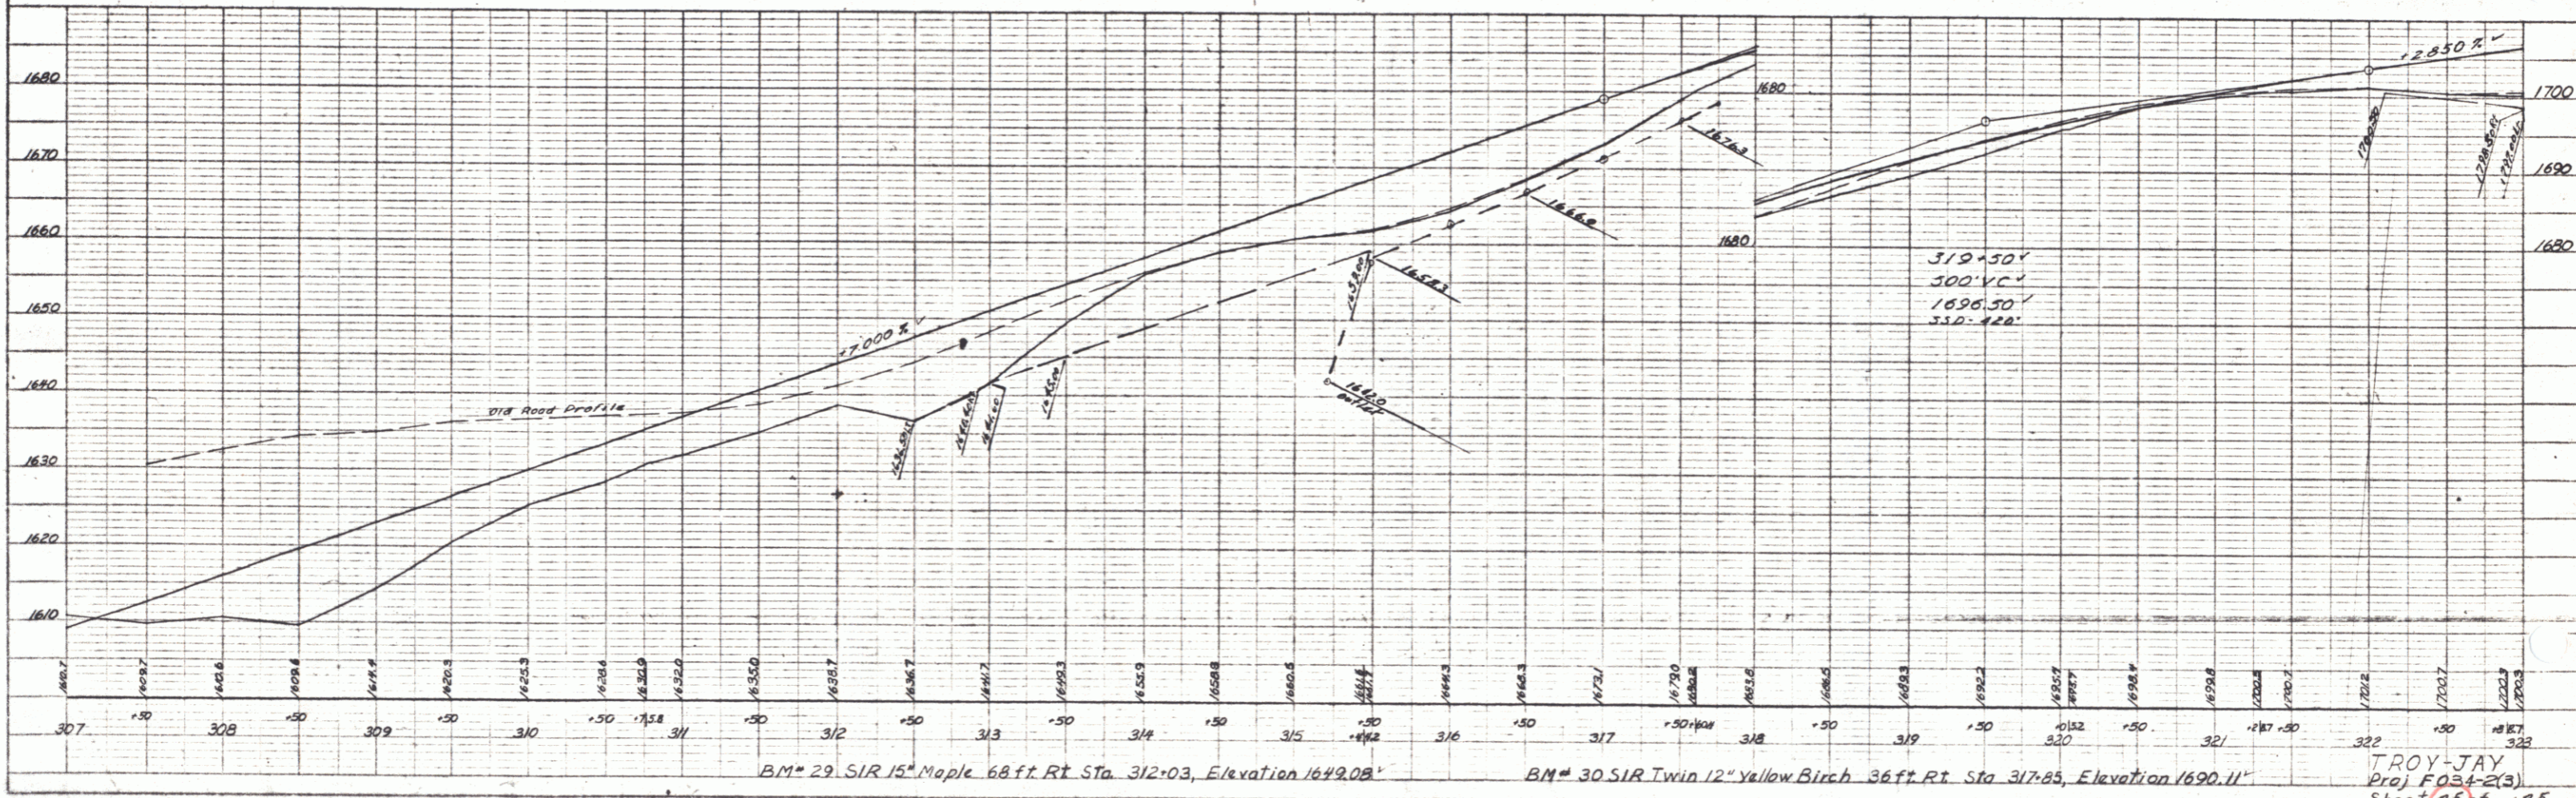
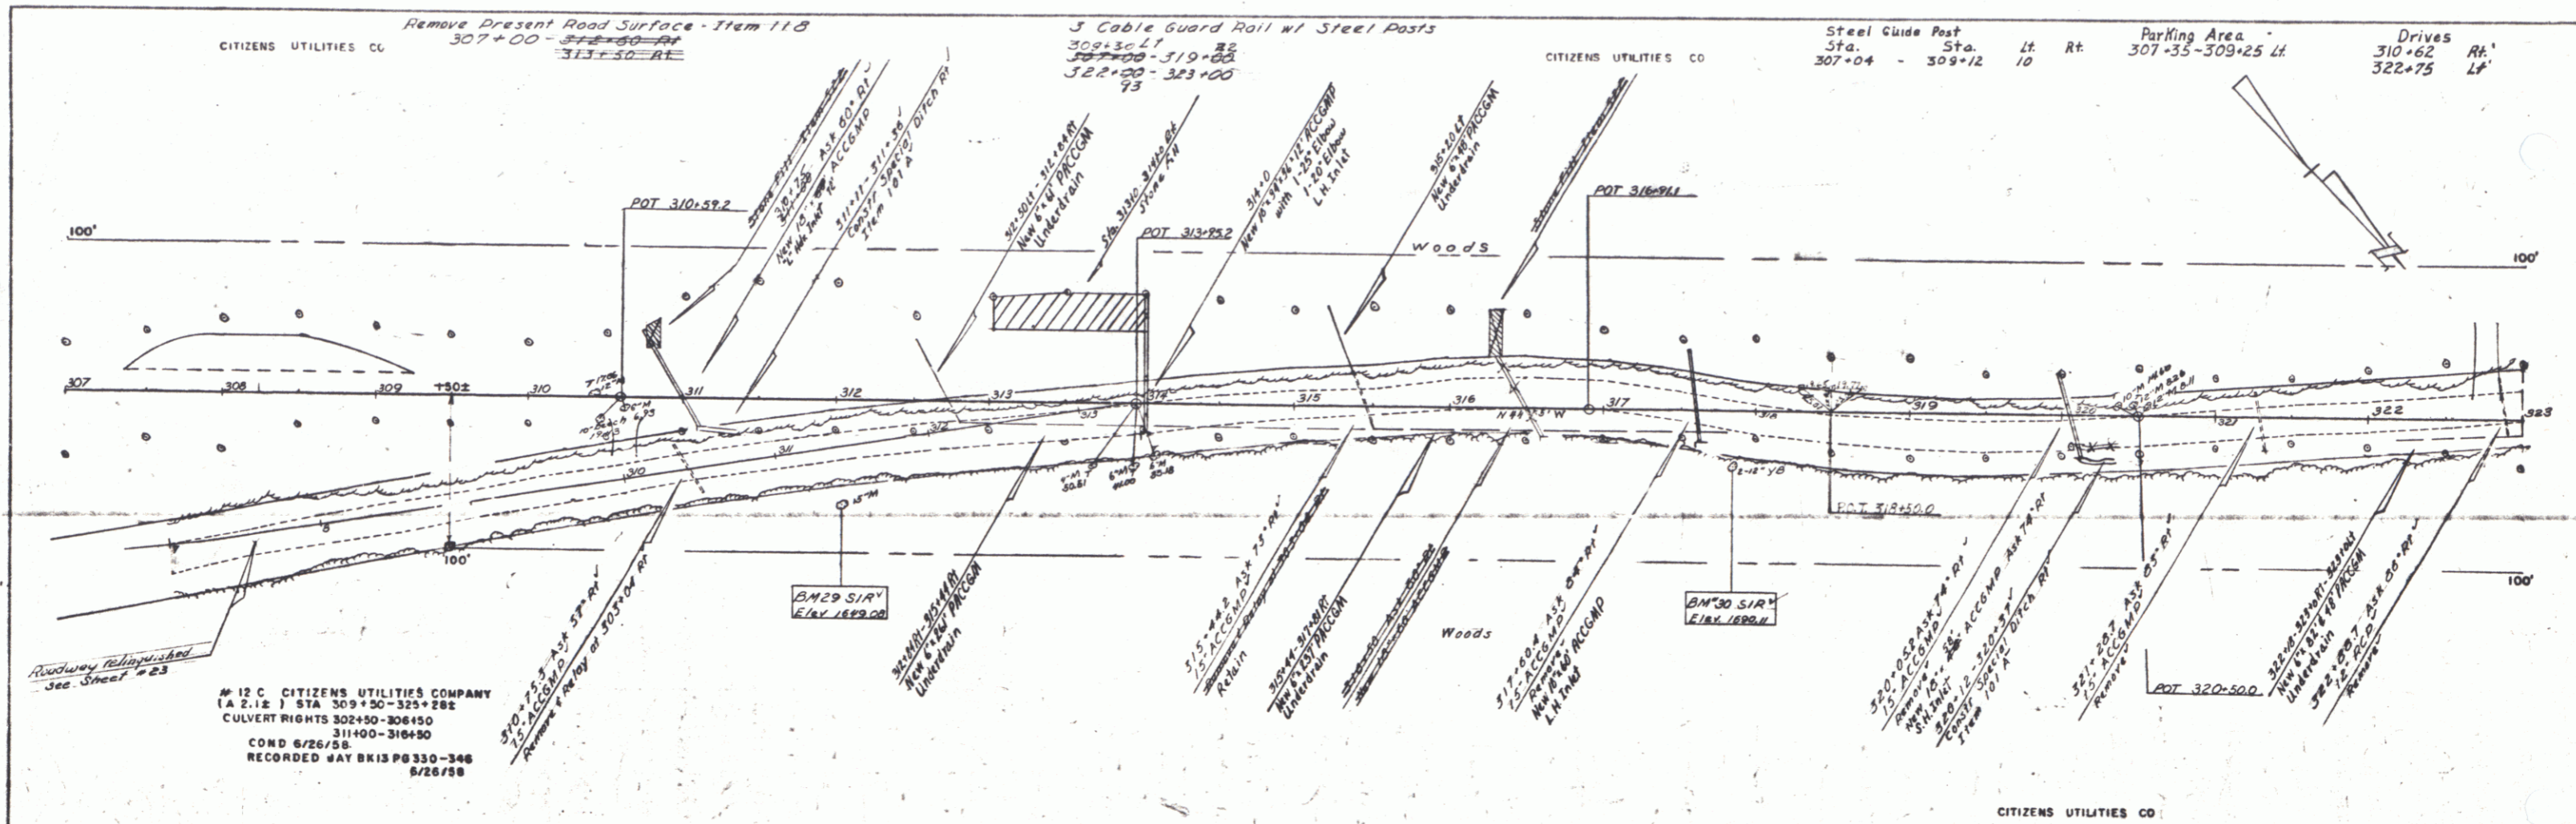


PLATE 1 - PLAN PROFILE U.P.A. & L.E. STANDARD
 REPTED & USED FOR THE PROJECT
 H. & R. CO. INC. 3400
 BOSTON, MASS.

TROY-JAY
 Proj. F034-2(3)
 Sheet 25 of 125