

PLAN  
 SHEET NO. 20  
 PROJECT NO. 100-100-100  
 DATE 10/10/10  
 DRAWN BY J. JAY

PROFILE  
 SHEET NO. 20  
 PROJECT NO. 100-100-100  
 DATE 10/10/10  
 DRAWN BY J. JAY

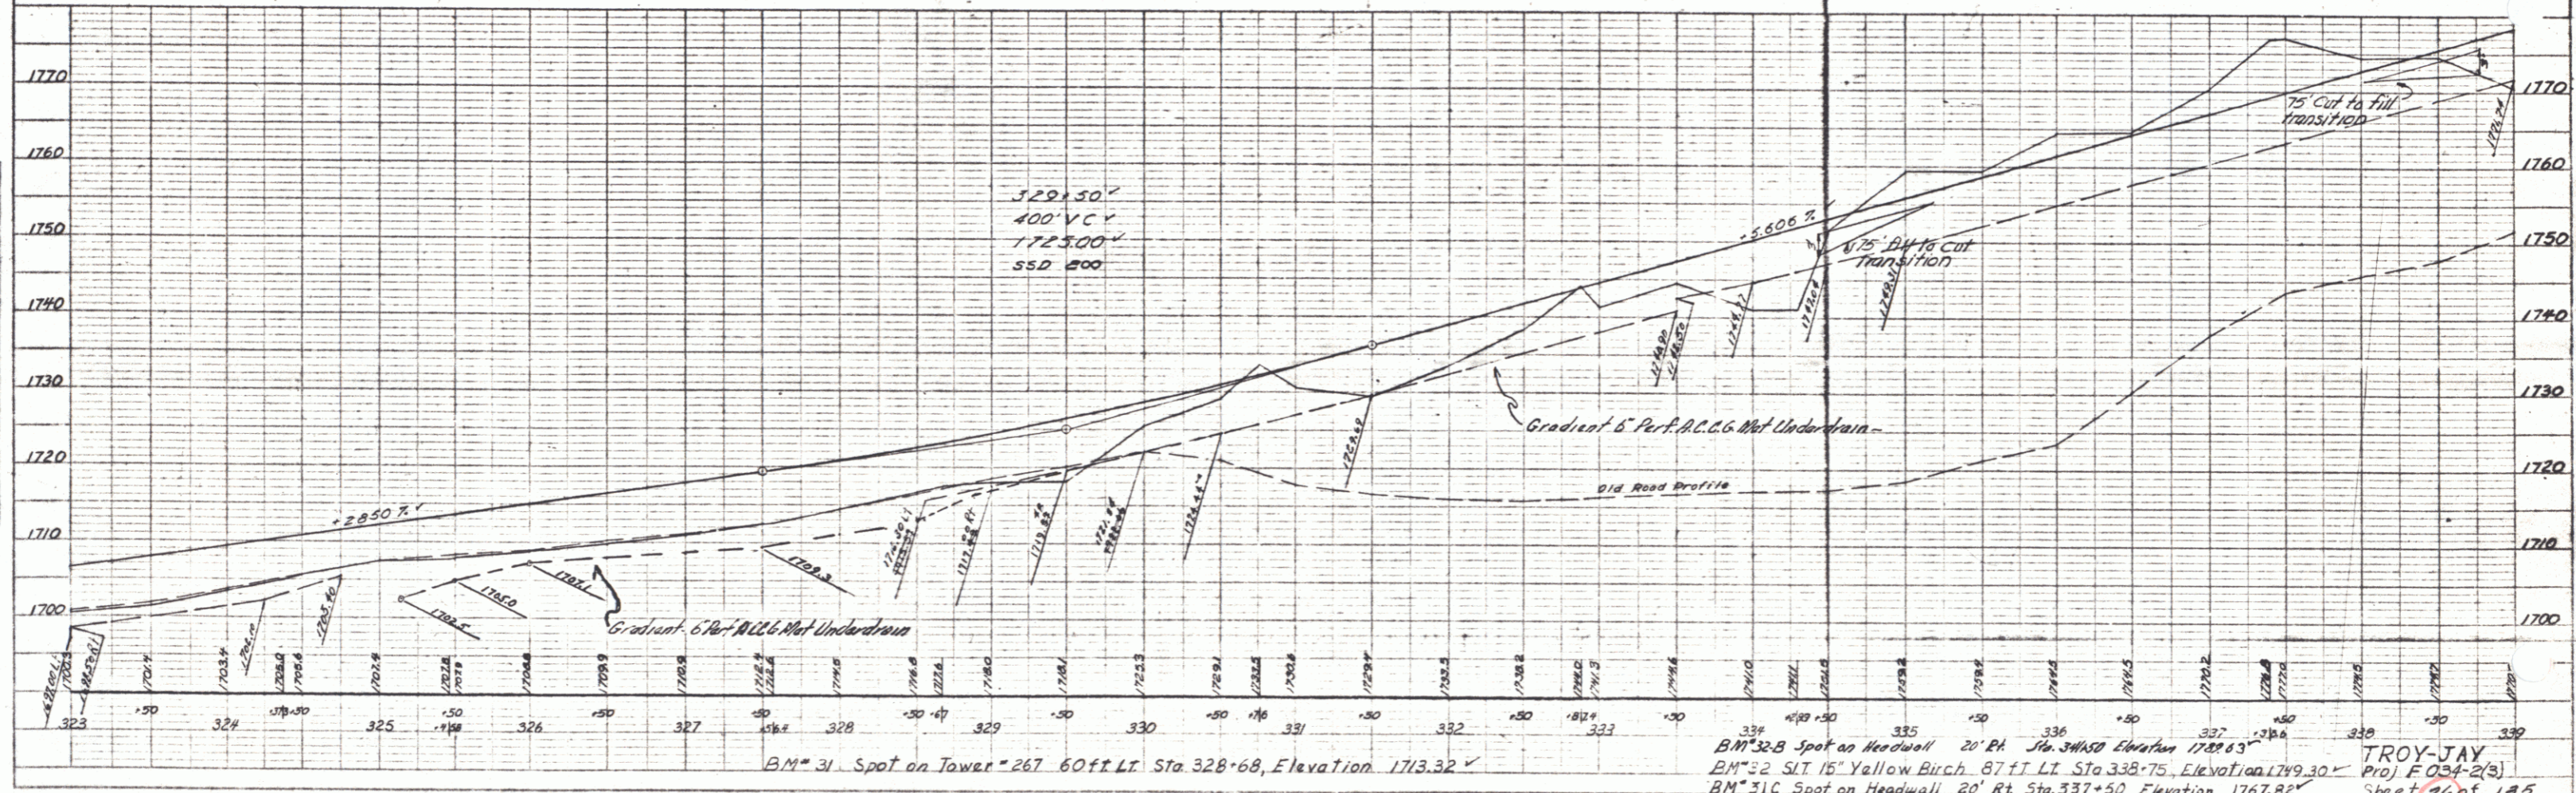
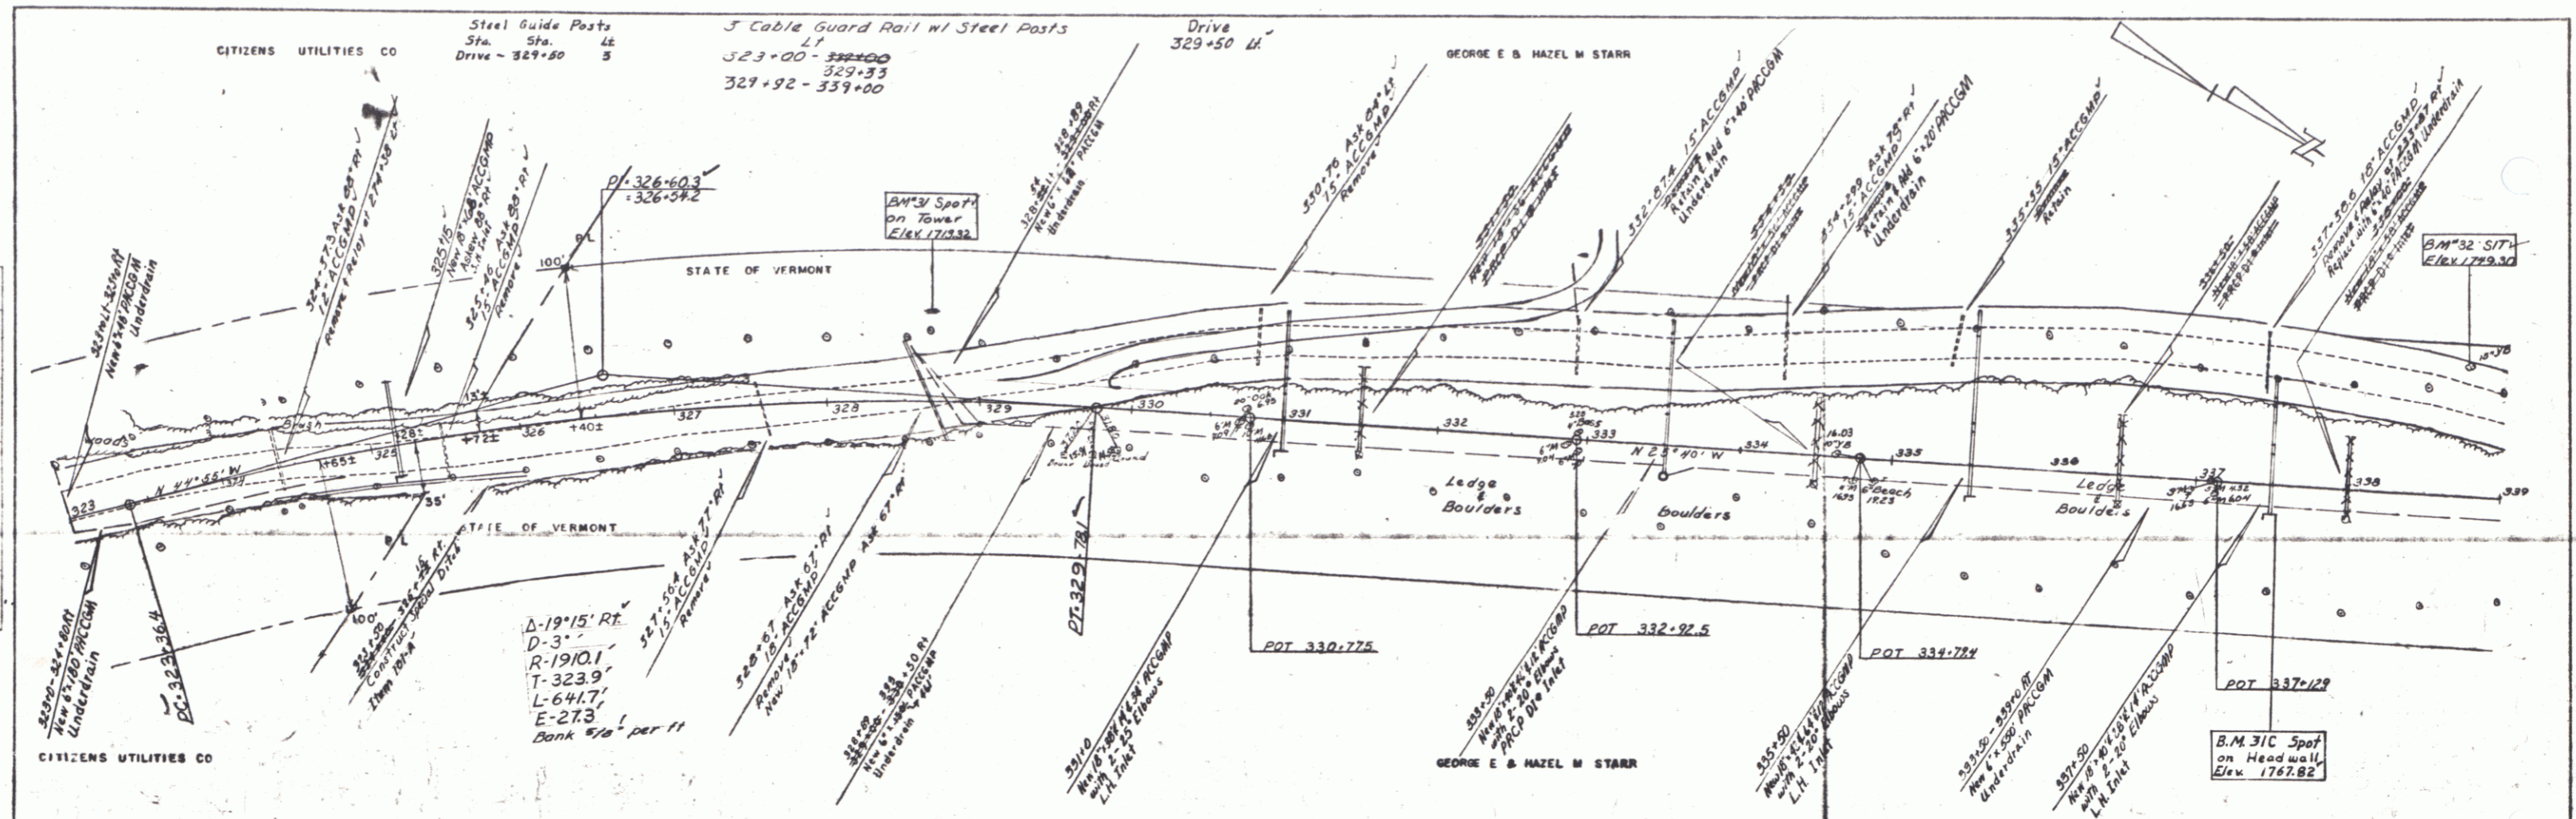


PLATE 1 - PLAN PROFILE - P.A.R.E. SYSTEM  
 SCALE: 1" = 40' HORIZ. 1" = 10' VERT.

TROY-JAY  
 Proj. F 034-2(s)  
 Sheet 20 of 125