

PLAN
 DRAWN BY: [Signature]
 CHECKED BY: [Signature]
 DATE: 2-27-57
 SCALE: AS SHOWN
 BY: [Signature]

PROFILE
 DRAWN BY: [Signature]
 CHECKED BY: [Signature]
 DATE: 2-27-57
 SCALE: AS SHOWN
 BY: [Signature]

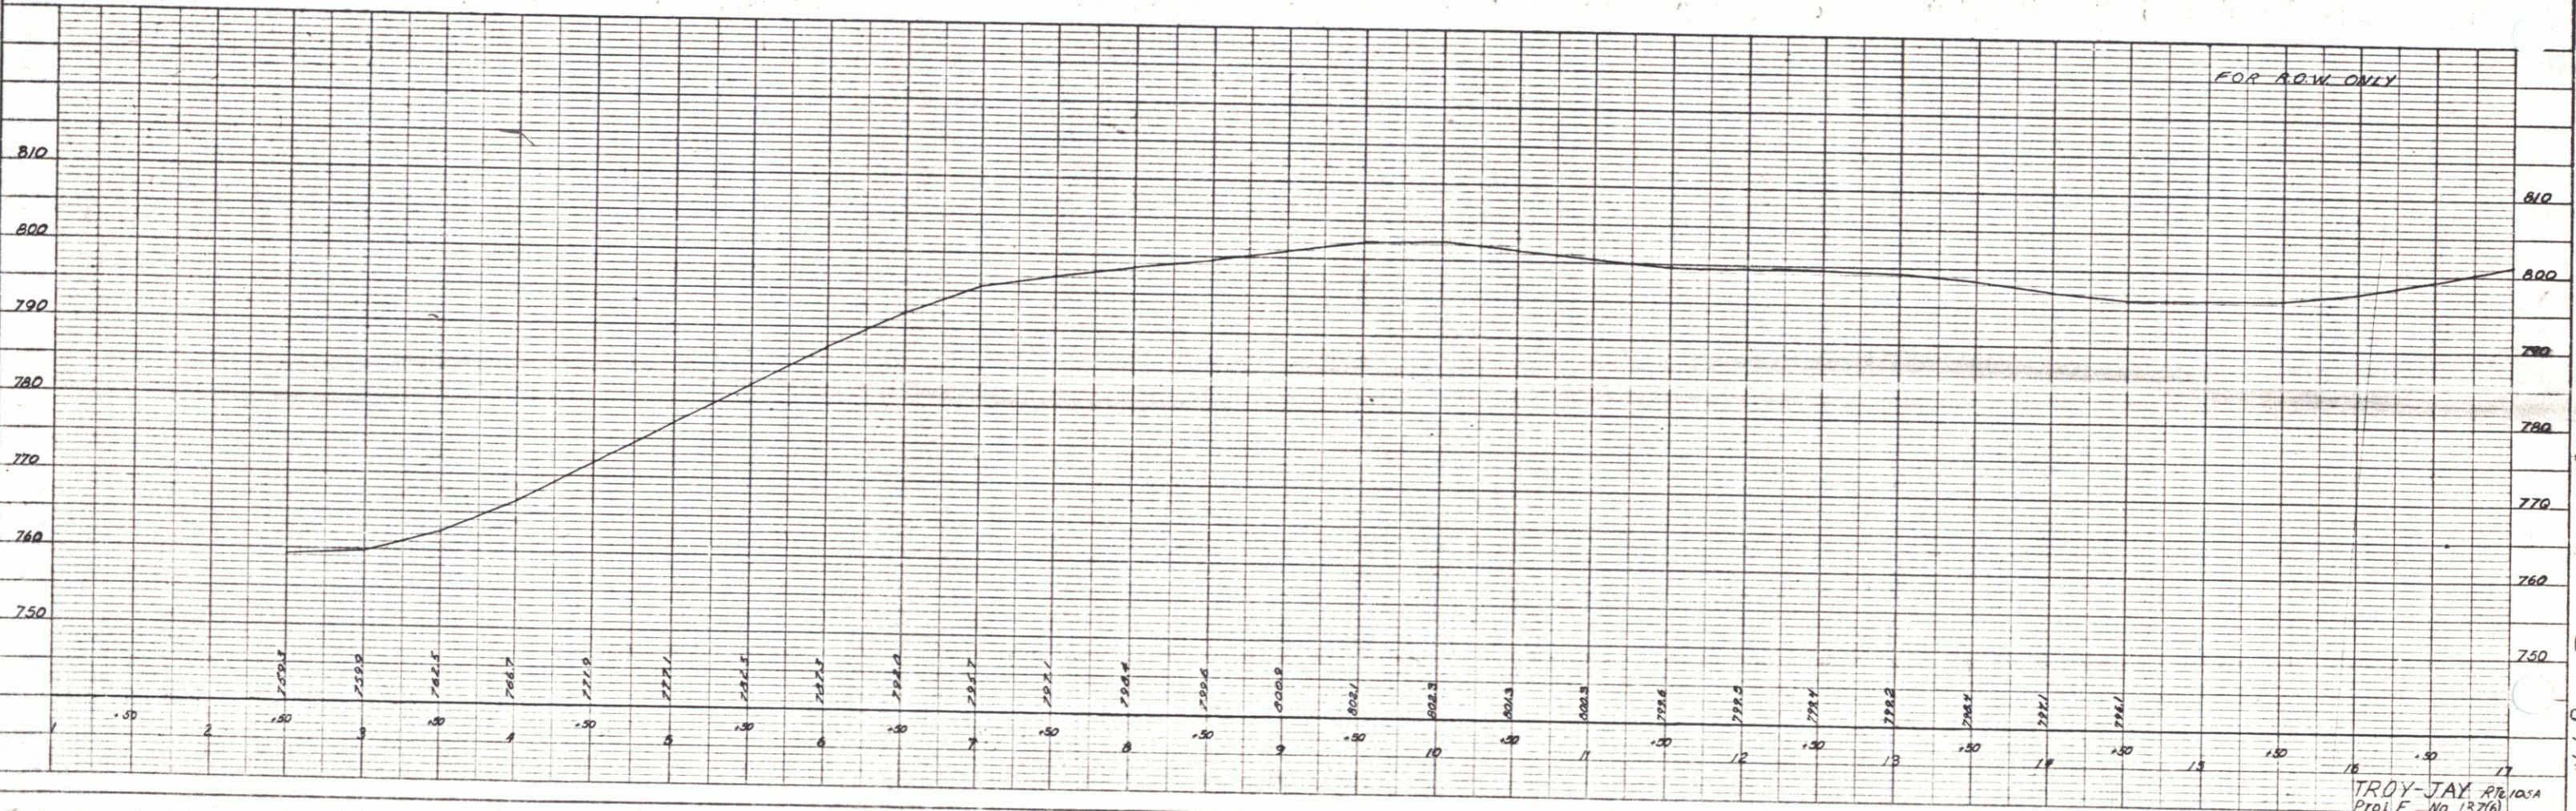
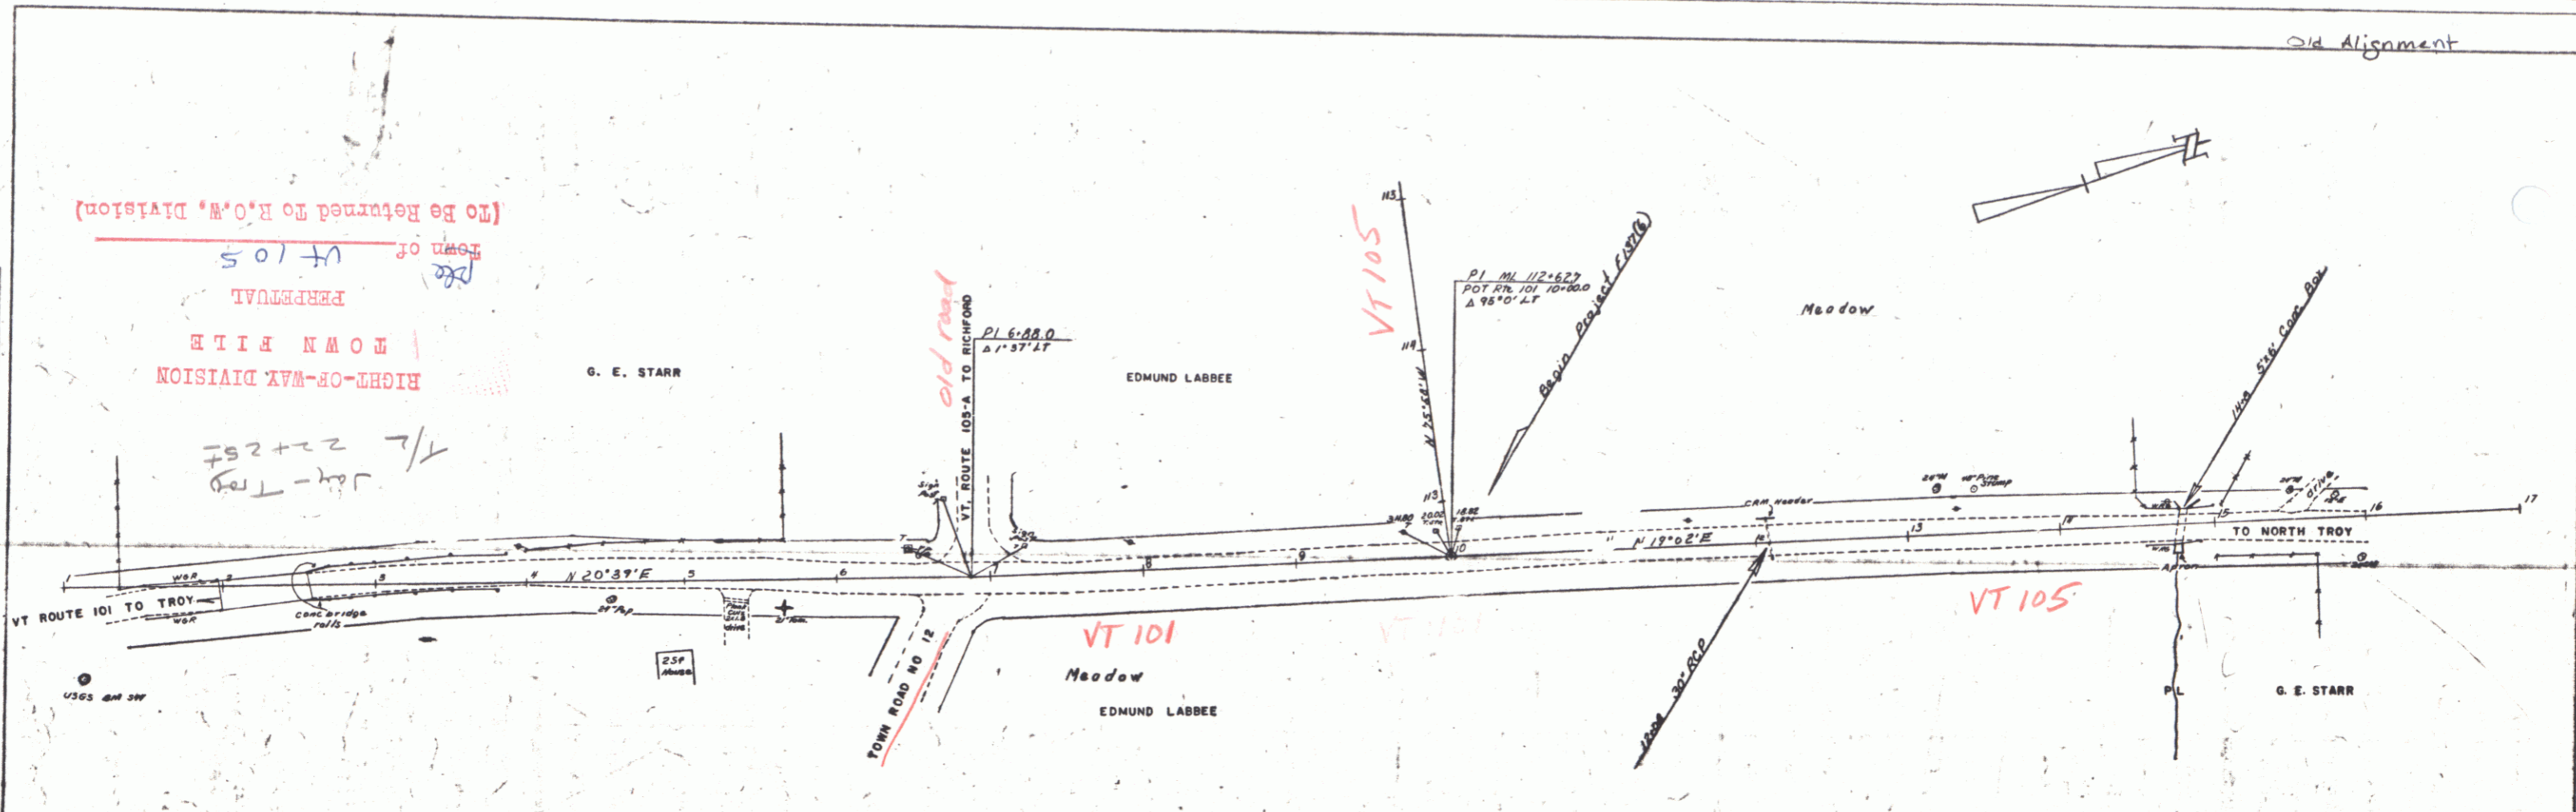


PLATE 1 - PLAN-PROFILE © P. R. A. C. STANDARD
 KUFFEL & ESSER CO., NEW YORK
 P. R. A. C. NO. 248-115
 © 1954 P. R. A. C.

TROY-JAY PROJECT
 PROFILE No. 13276
 Sheet 14 of 17

19