

PLAN	DATE	BY
REVISED	DATE	BY
NOTE BOOK	NO. OF SHEETS	NO.
NO.		

PROFILE	DATE	BY
REVISED	DATE	BY
NOTE BOOK	NO. OF SHEETS	NO.
NO.		

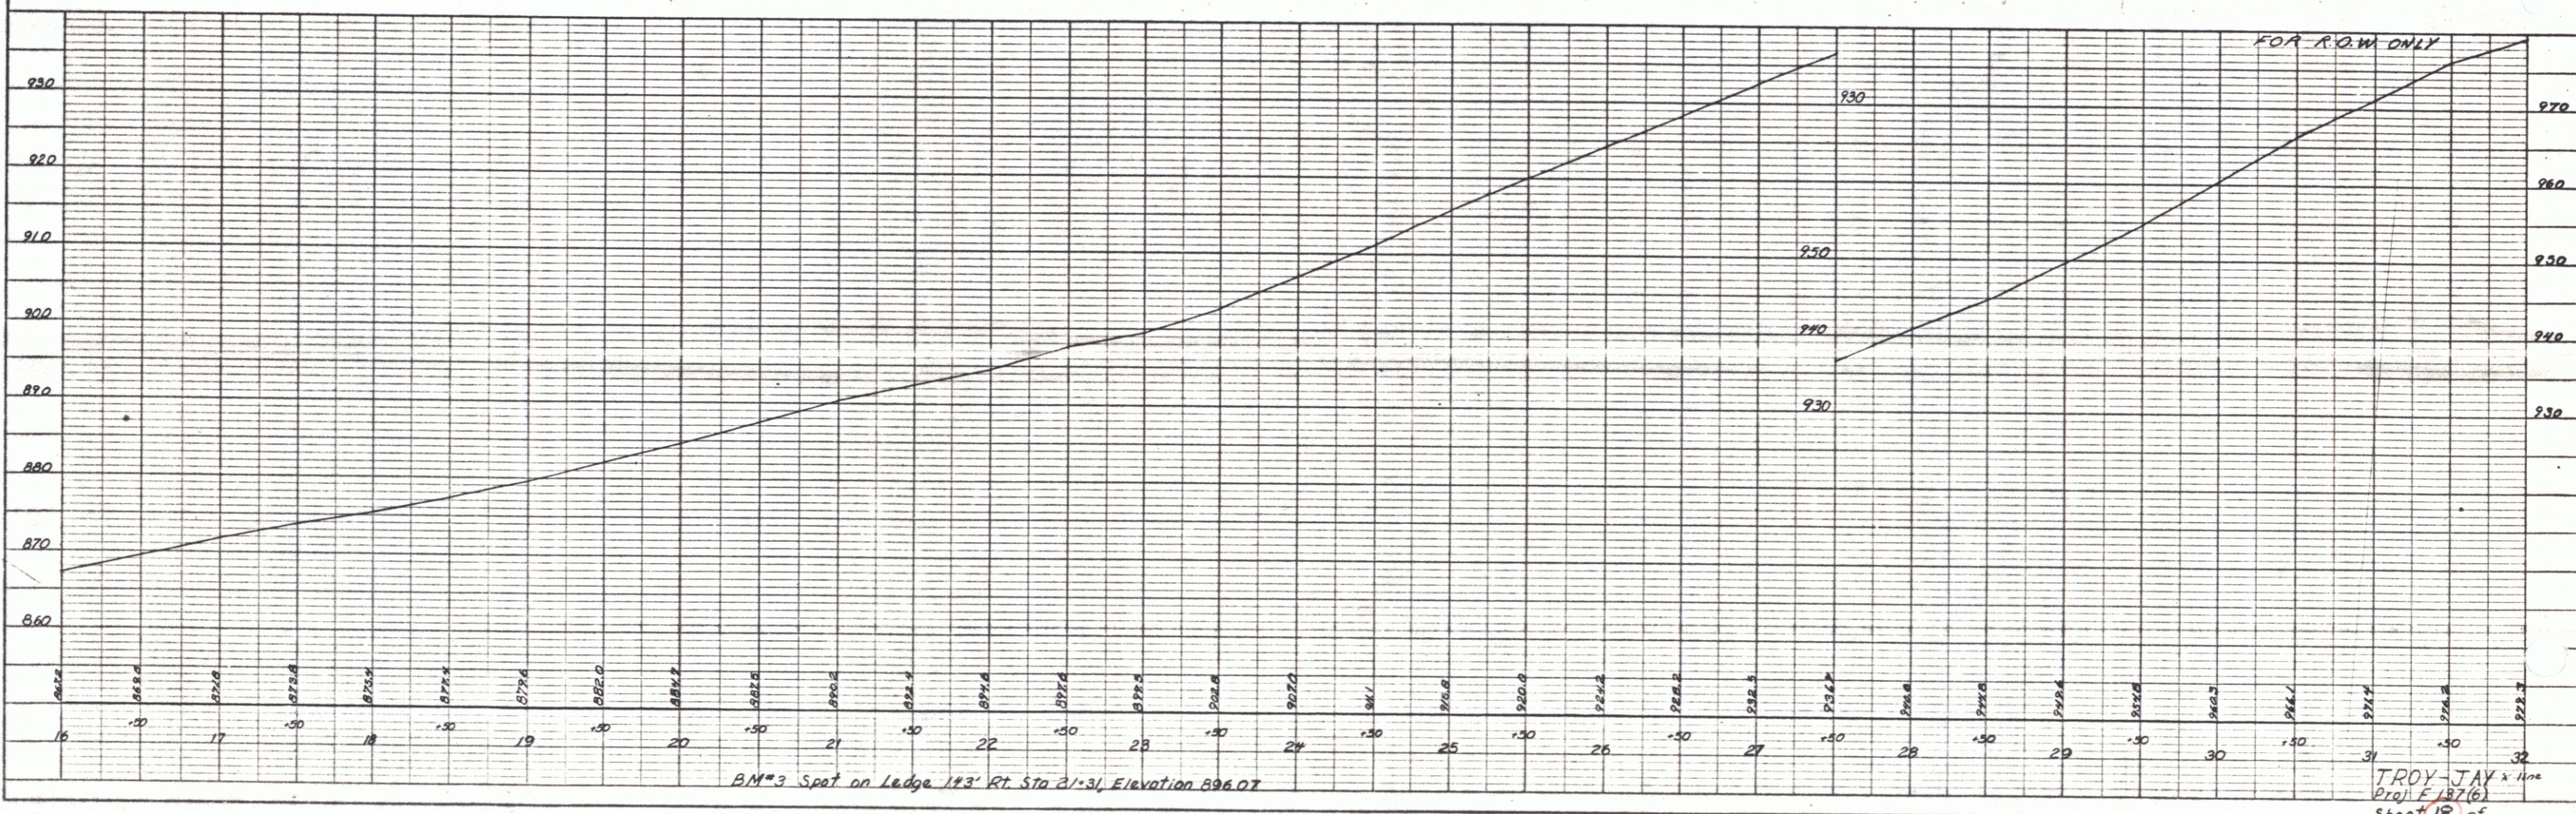
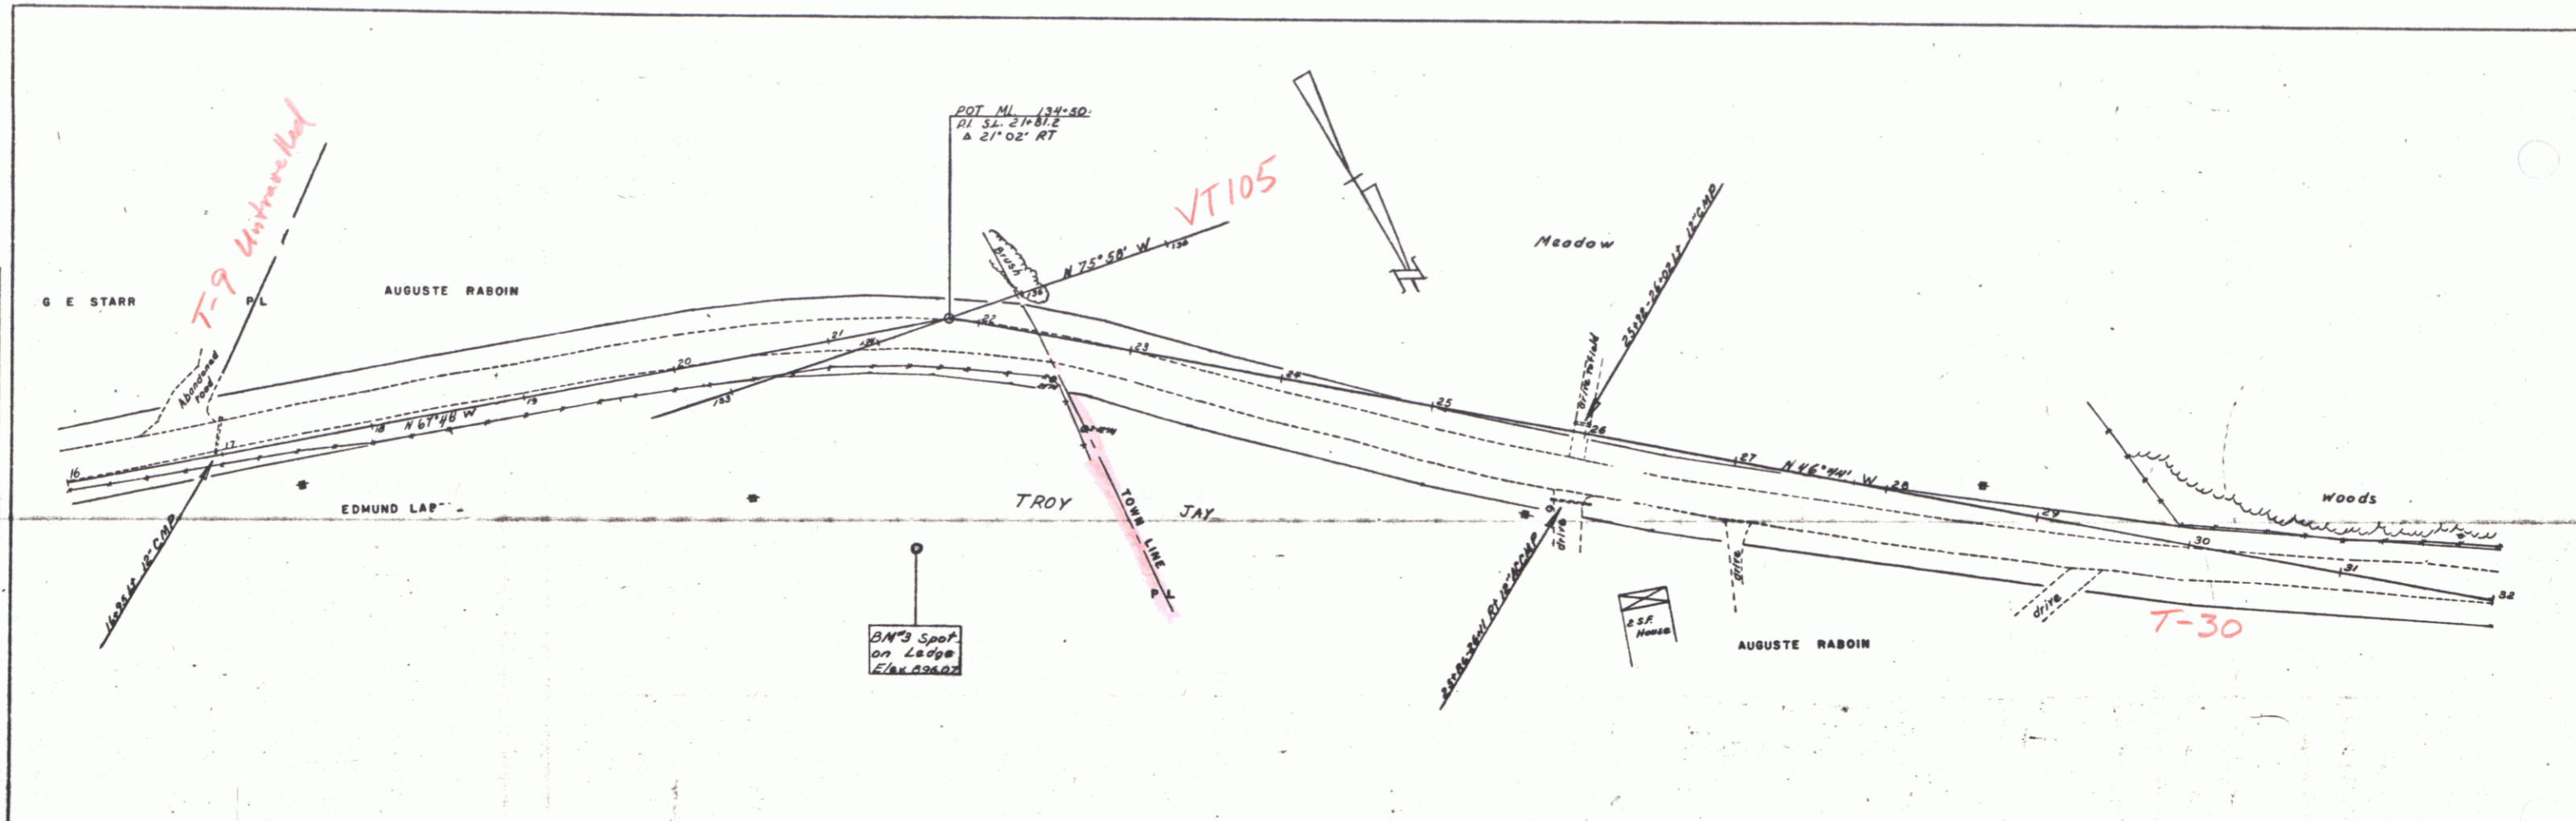


PLATE 1 - PLAN-PROFILE OF P. & R. E. STARR  
 HOFFEL & SONS CO., NEW YORK  
 K & E'S NO. 348-1000  
 1927

TROY-JAY  
 Proj. E. 1876  
 Sheet 18 of