

PLAN	DATE	BY	CHECKED
DATE	2/28/57	BY	JAY
NO.	32-403	NO.	2-37
PROJECT	ROAD	PROJECT	ROAD
NO.	32-403	NO.	2-37
SCALE	1" = 10'	SCALE	1" = 10'
DATE	2/28/57	DATE	2/28/57
BY	JAY	BY	JAY
CHECKED		CHECKED	

PROFILE	DATE	BY	CHECKED
DATE	2/28/57	BY	JAY
NO.	32-403	NO.	2-37
PROJECT	ROAD	PROJECT	ROAD
NO.	32-403	NO.	2-37
SCALE	1" = 10'	SCALE	1" = 10'
DATE	2/28/57	DATE	2/28/57
BY	JAY	BY	JAY
CHECKED		CHECKED	

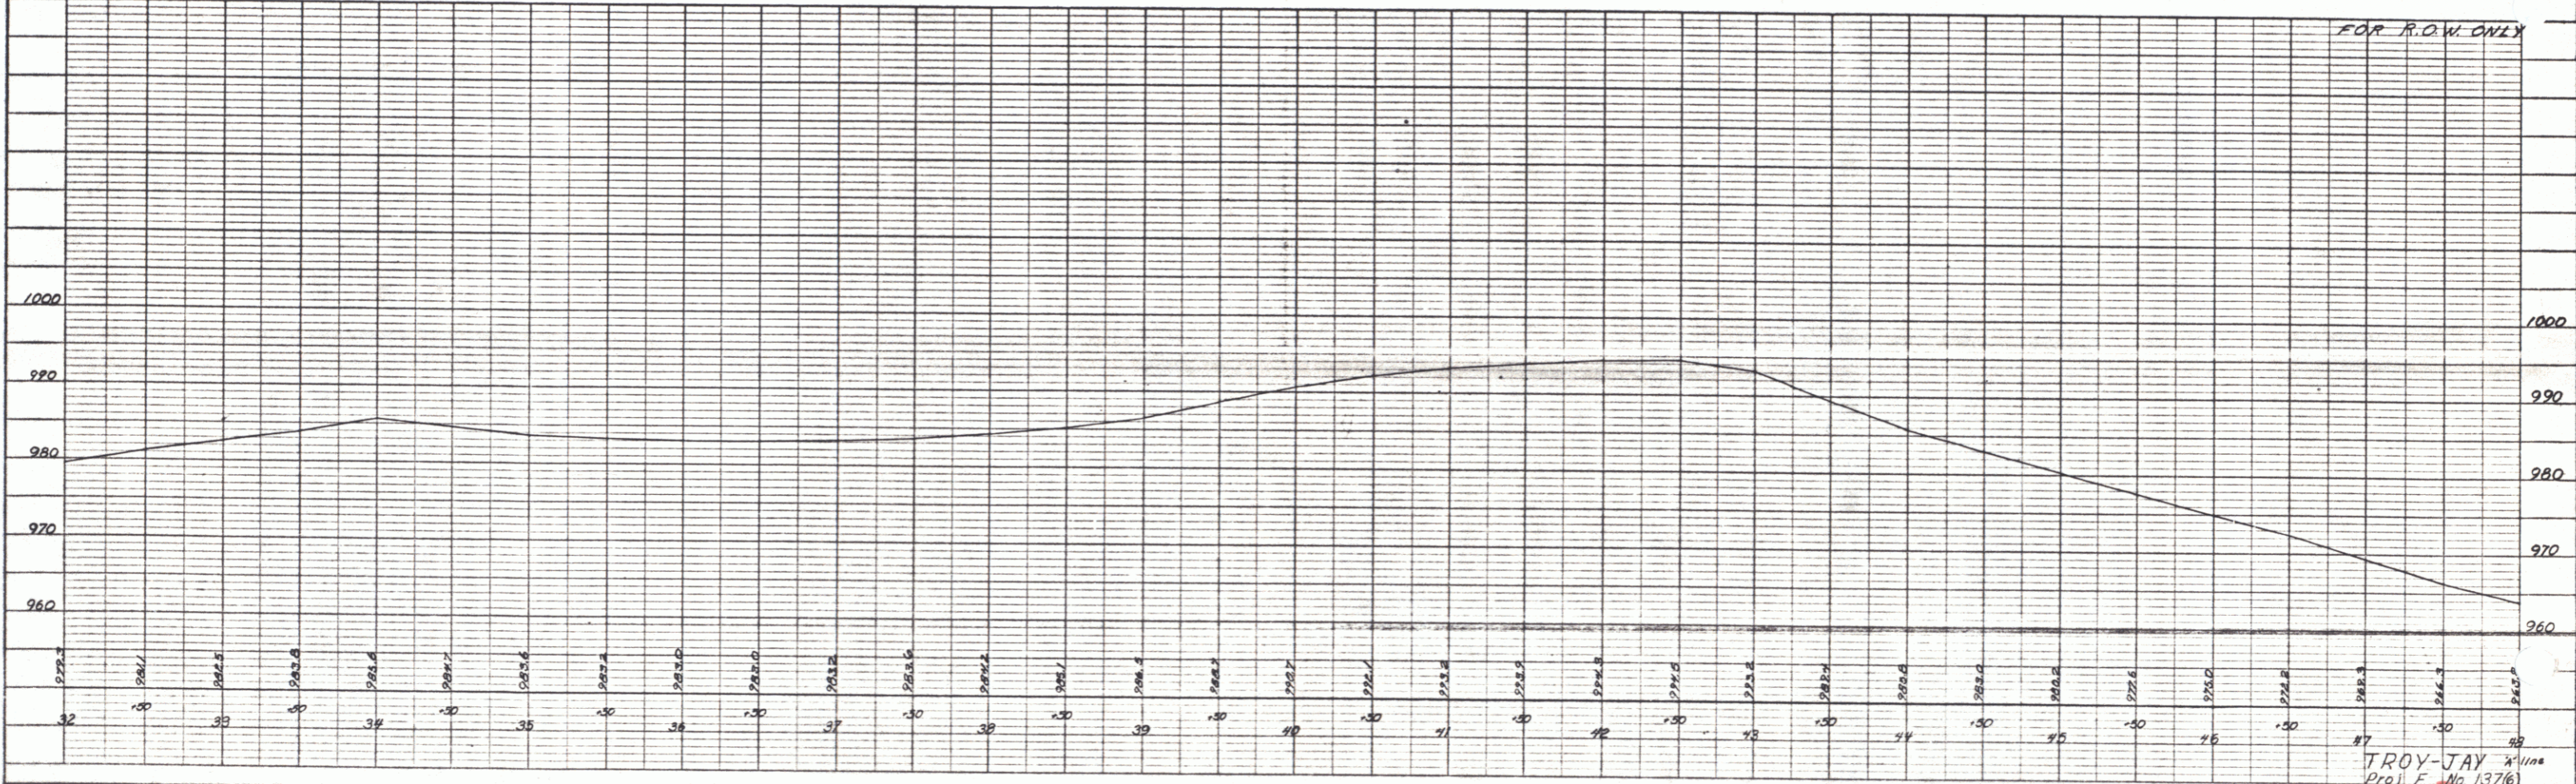
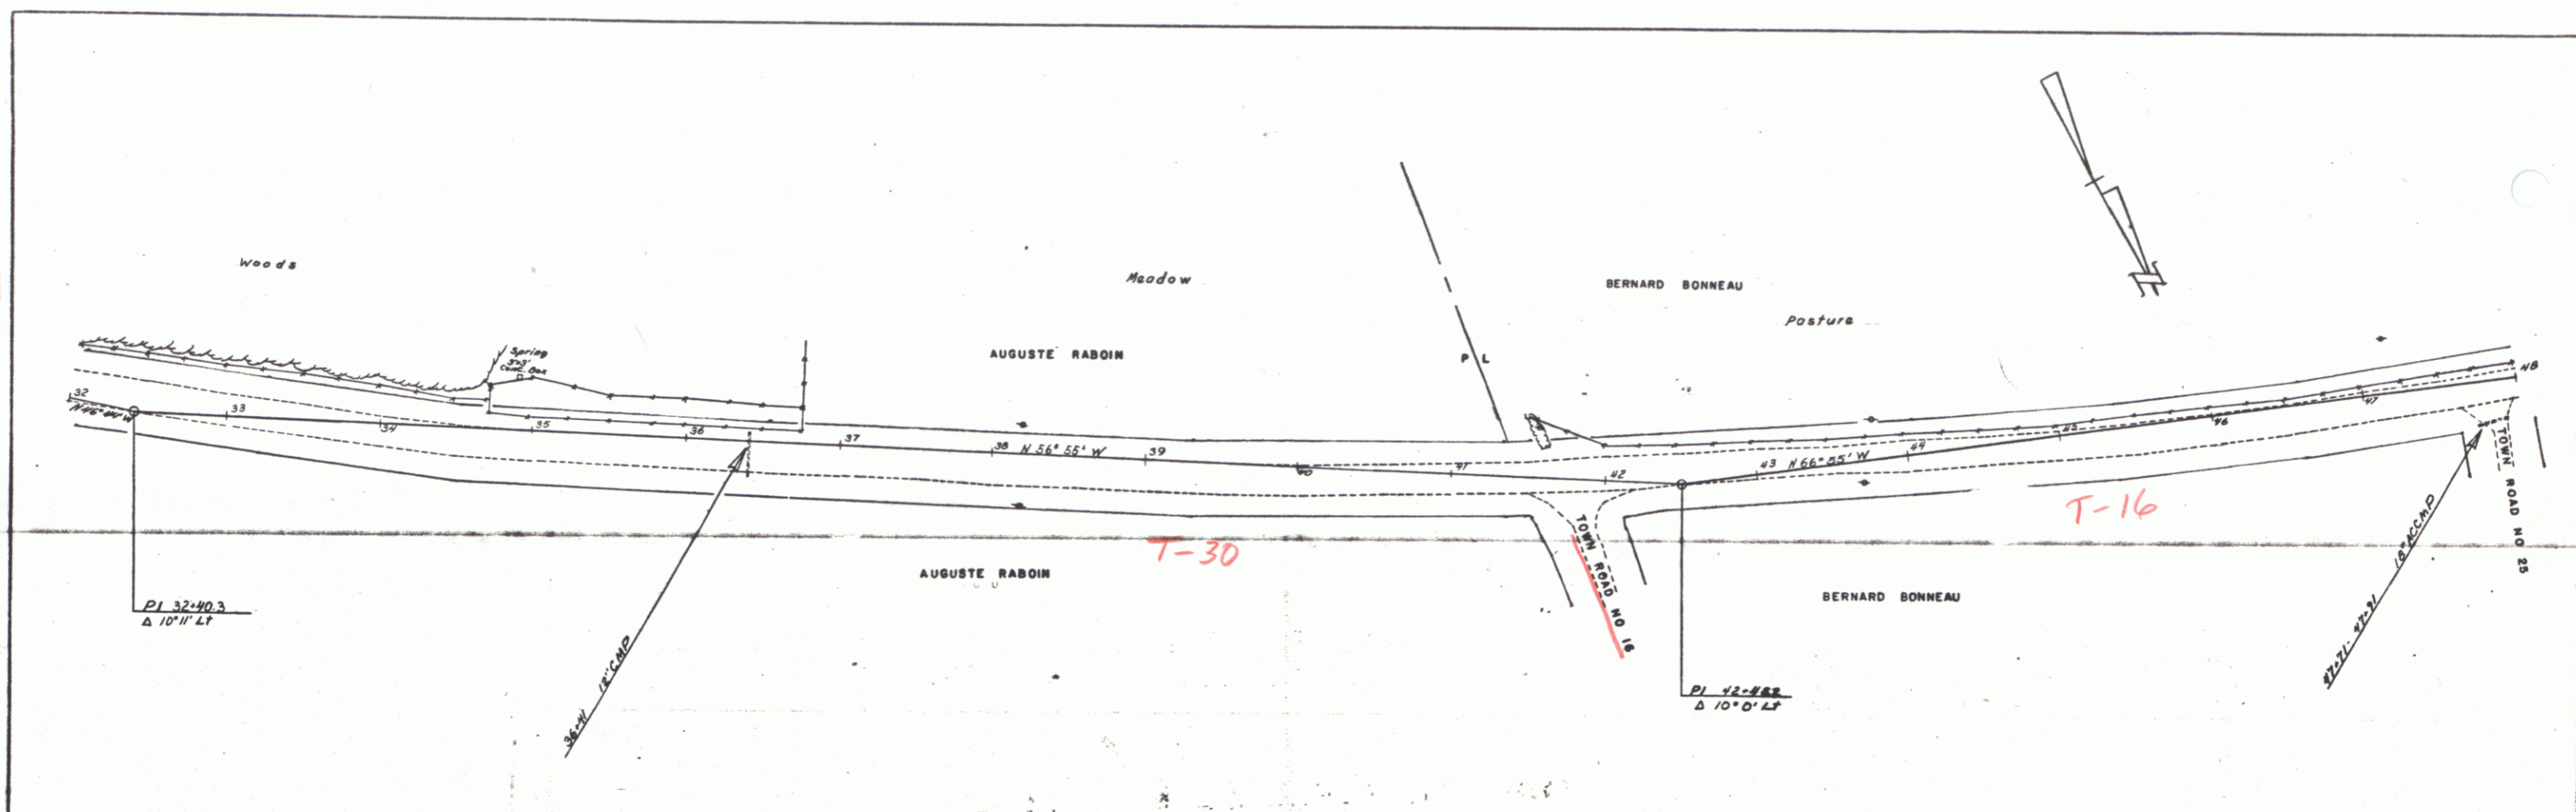


PLATE 1 - PLAN-PROFILE  
 KEFFEL & ESSER CO., NEW YORK  
 N. Y. C. No. 348-28

TROY-JAY  
 Proj. E No. 137(6)  
 Sheet 1 of 1

Road Turned back to Town