

PLAN	DATE	BY
REVISED		
NOTED		
BY		

PROFILE	DATE	BY
REVISED		
NOTED		
BY		

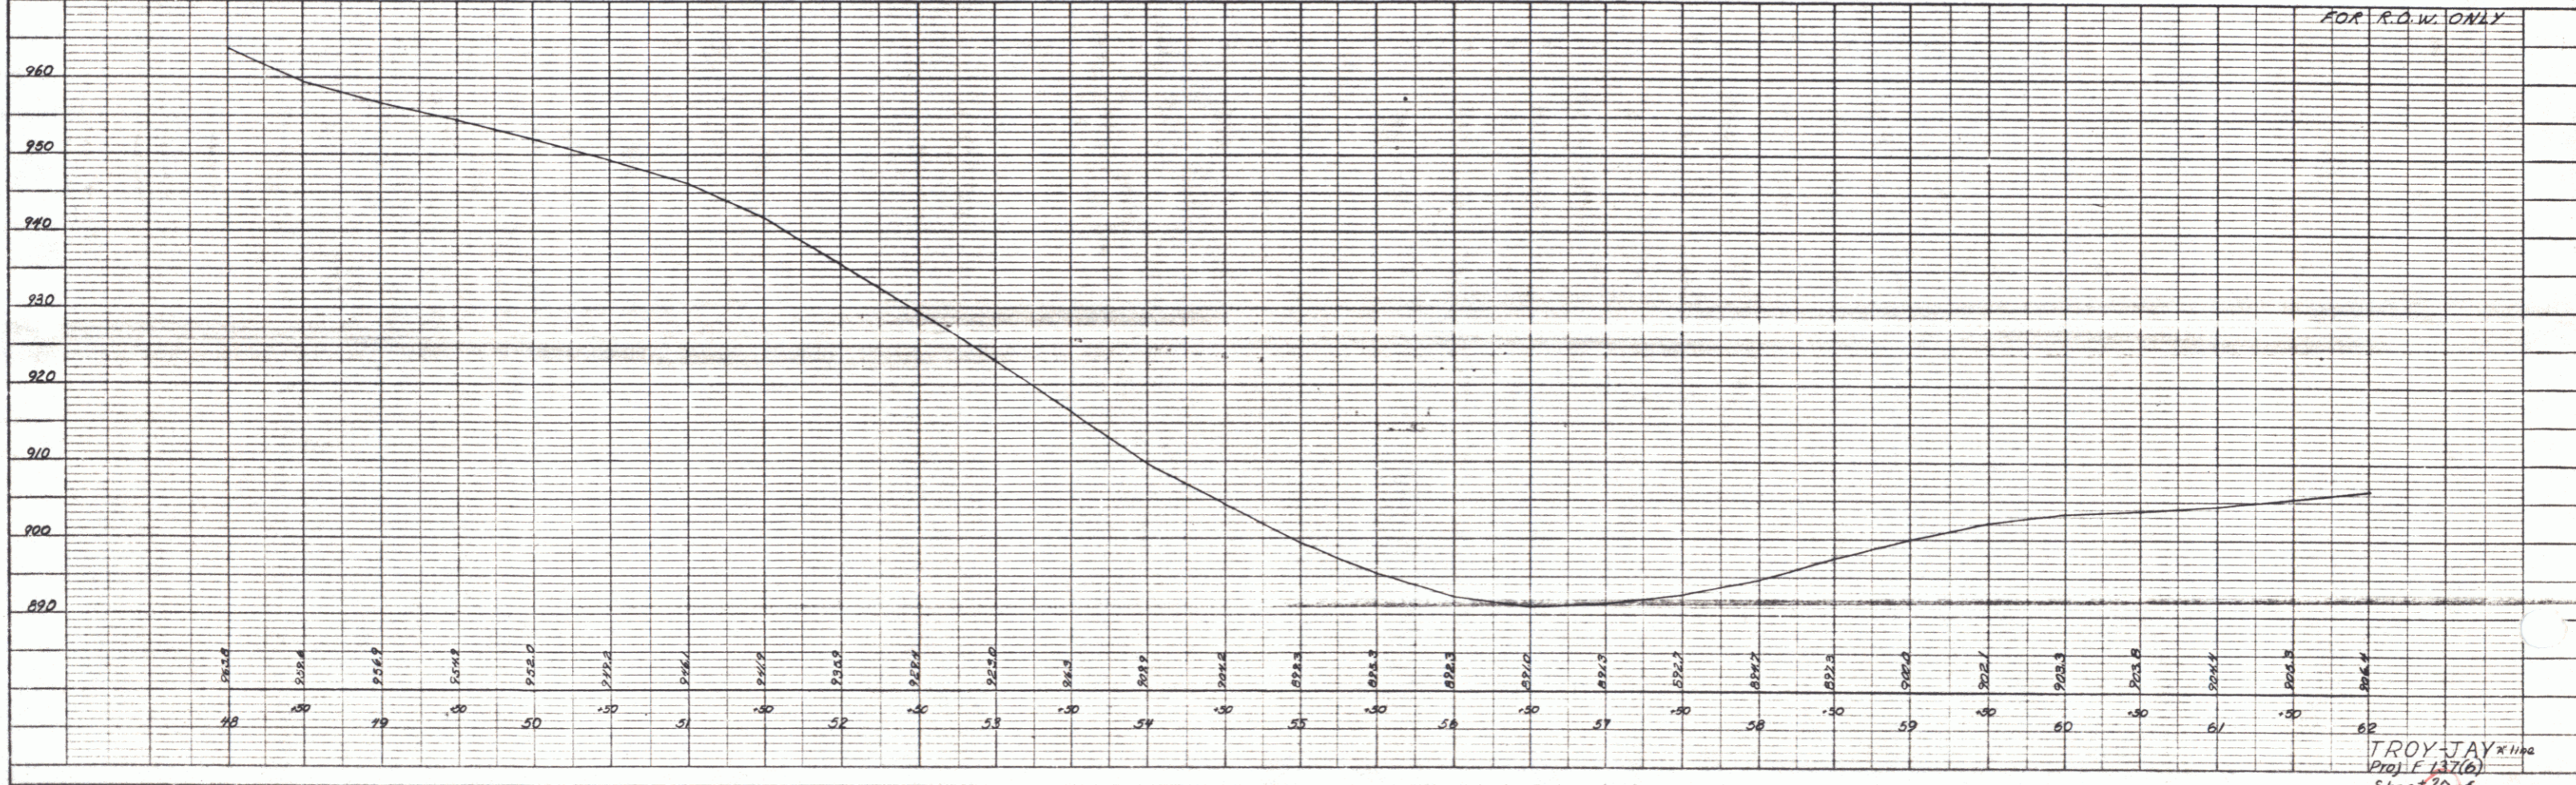
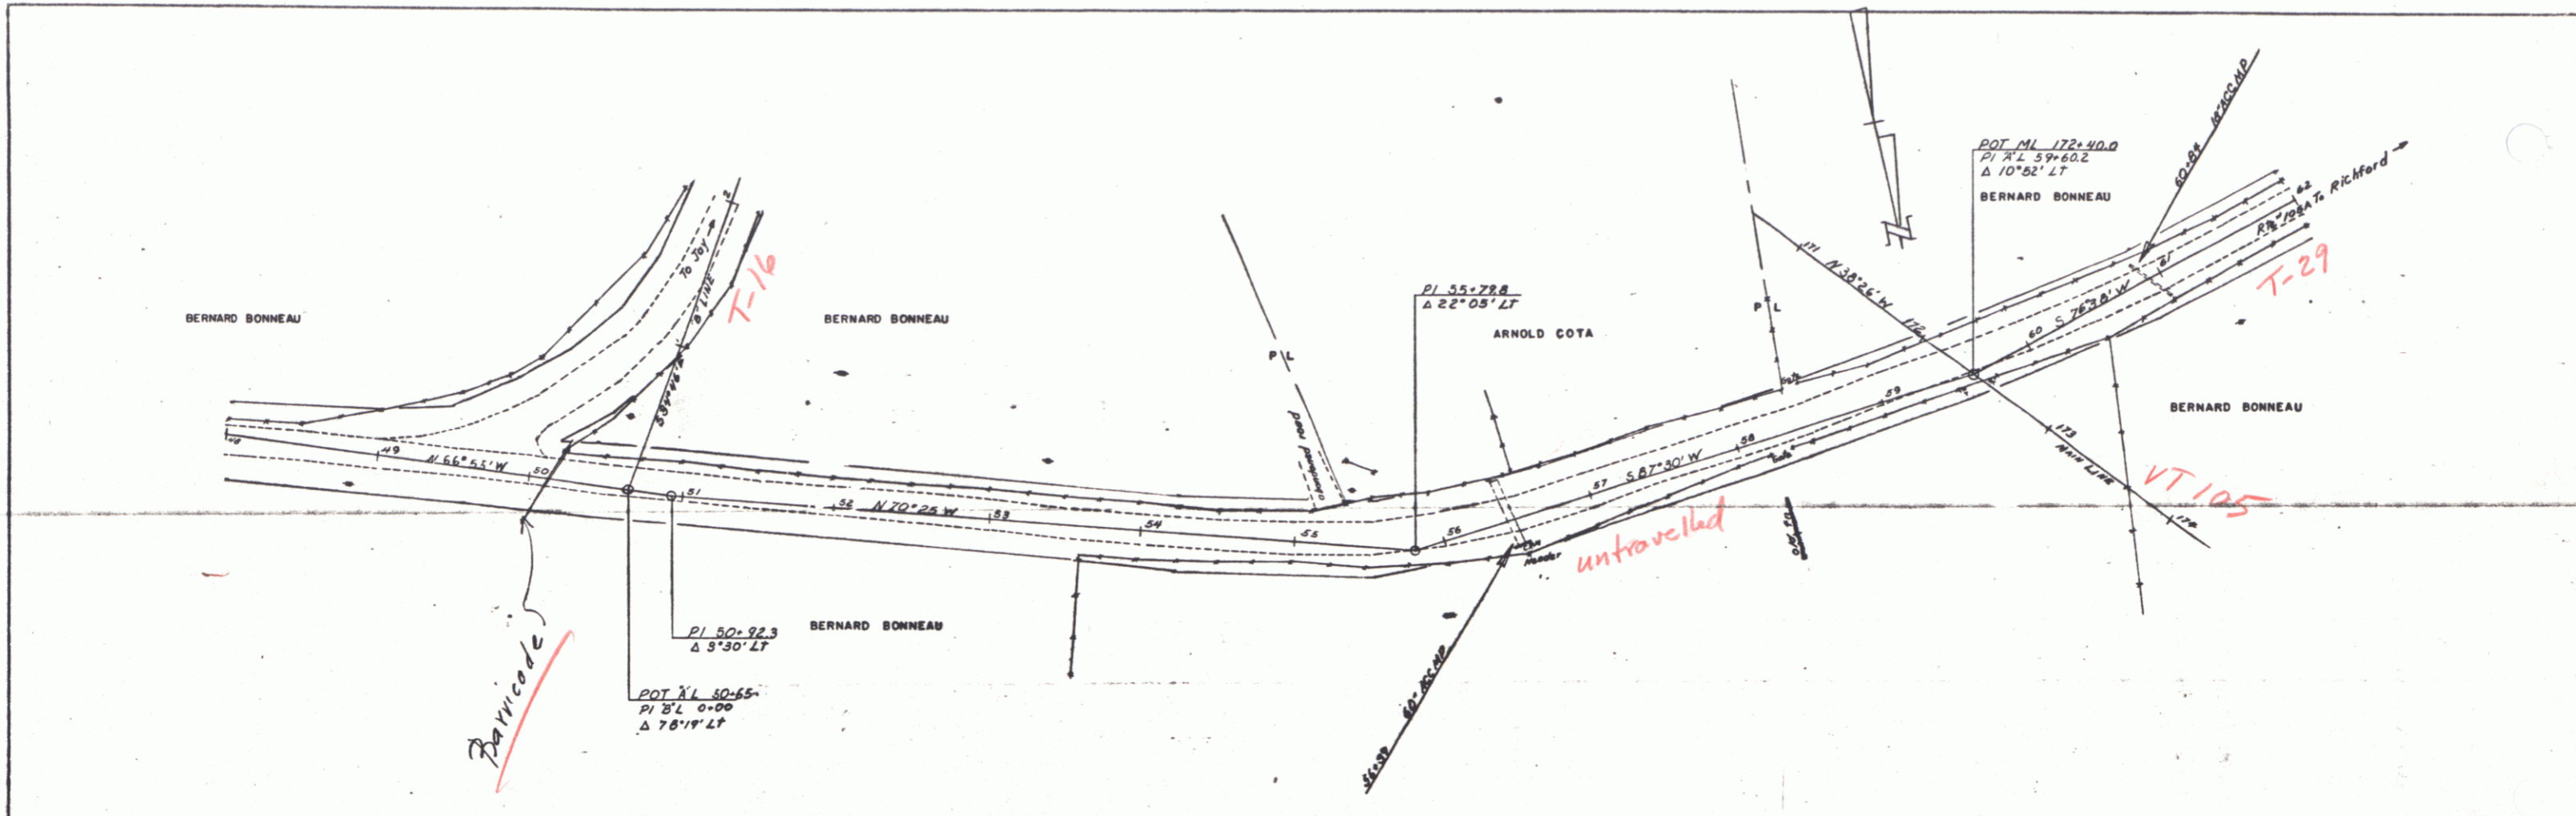


PLATE 1 - PLAN-PROFILE OF P. & R. E. STANDARD
 KEUFFEL & ESSER CO., NEW YORK
 K & E CO. NO. 348-C5
 PRINTED IN U.S.A.

TROY JAY
 PROJ. 137(6)
 Sheet 20 of

Road Tabern built to Town