

PLAN
 DATE: 11/20/30
 DRAWN BY: [illegible]
 CHECKED BY: [illegible]
 TITLE: [illegible]

PROF.
 DATE: 11/20/30
 DRAWN BY: [illegible]
 CHECKED BY: [illegible]
 TITLE: [illegible]

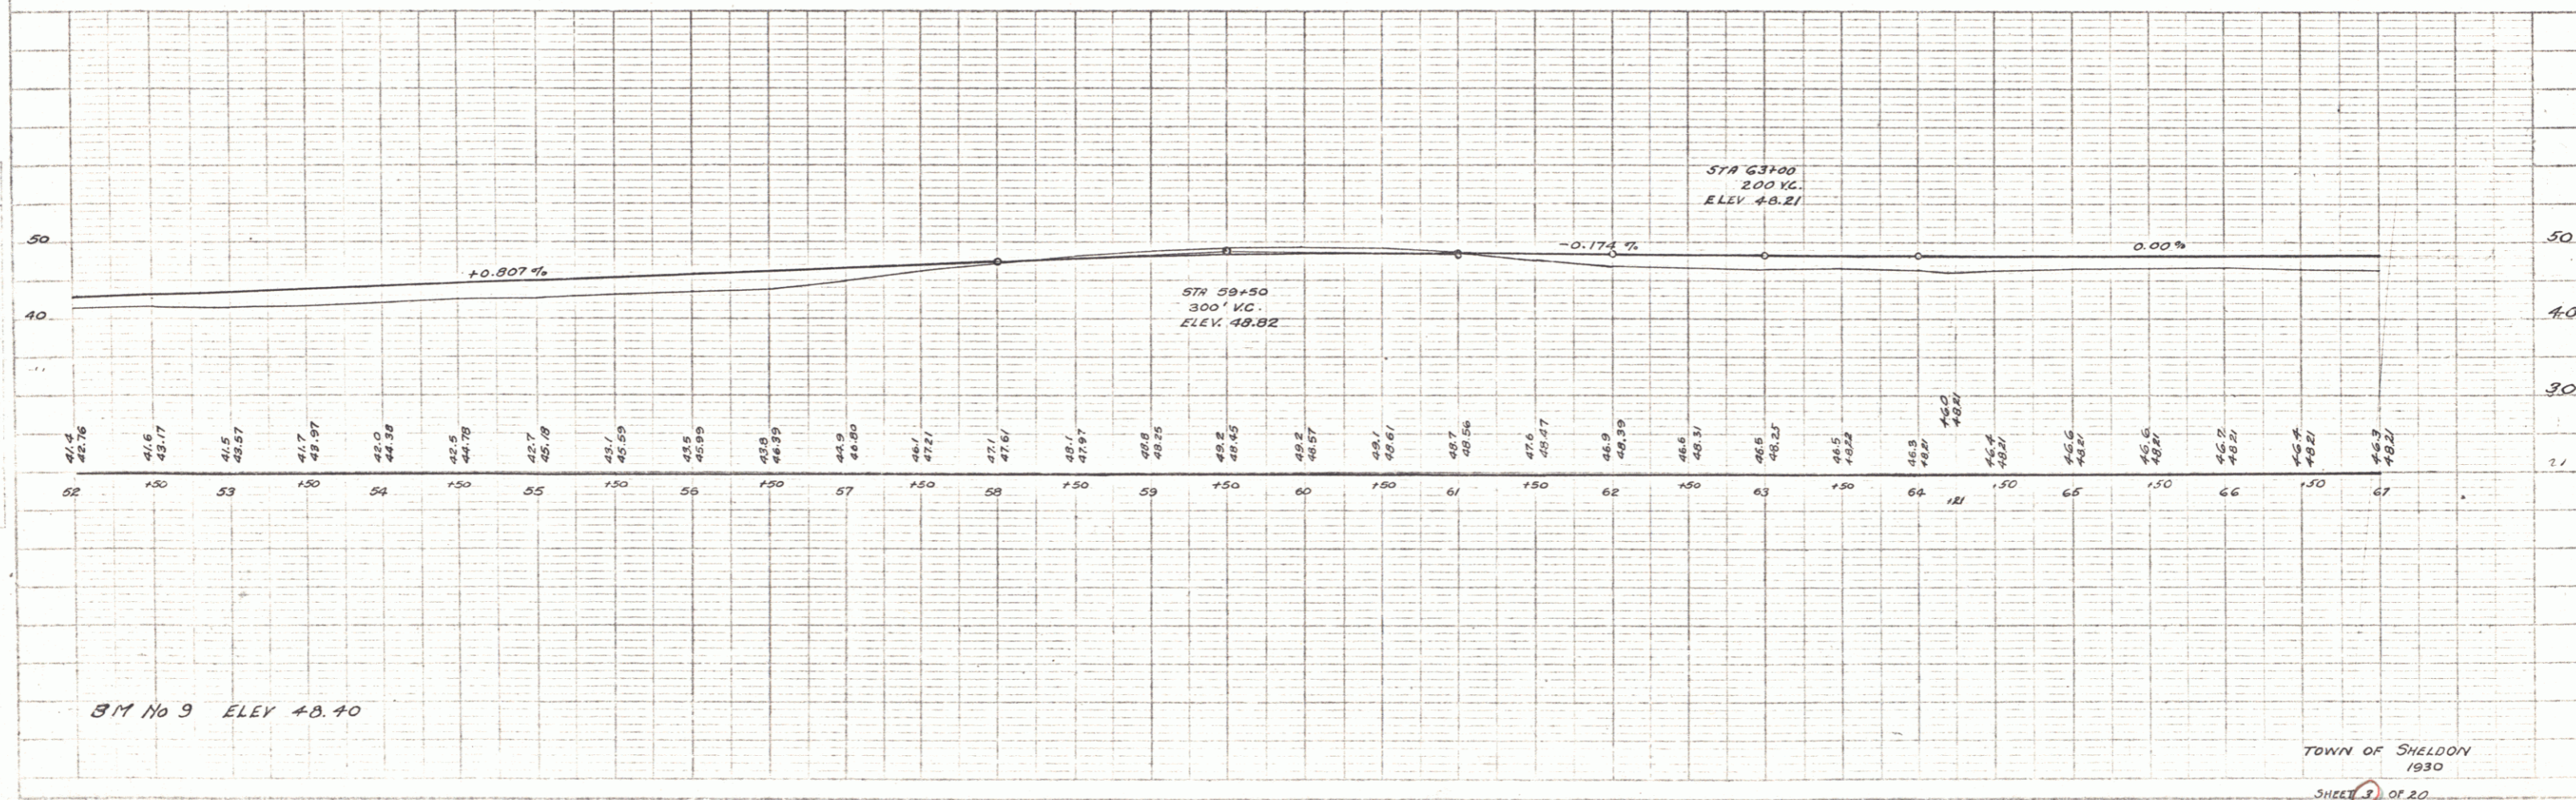
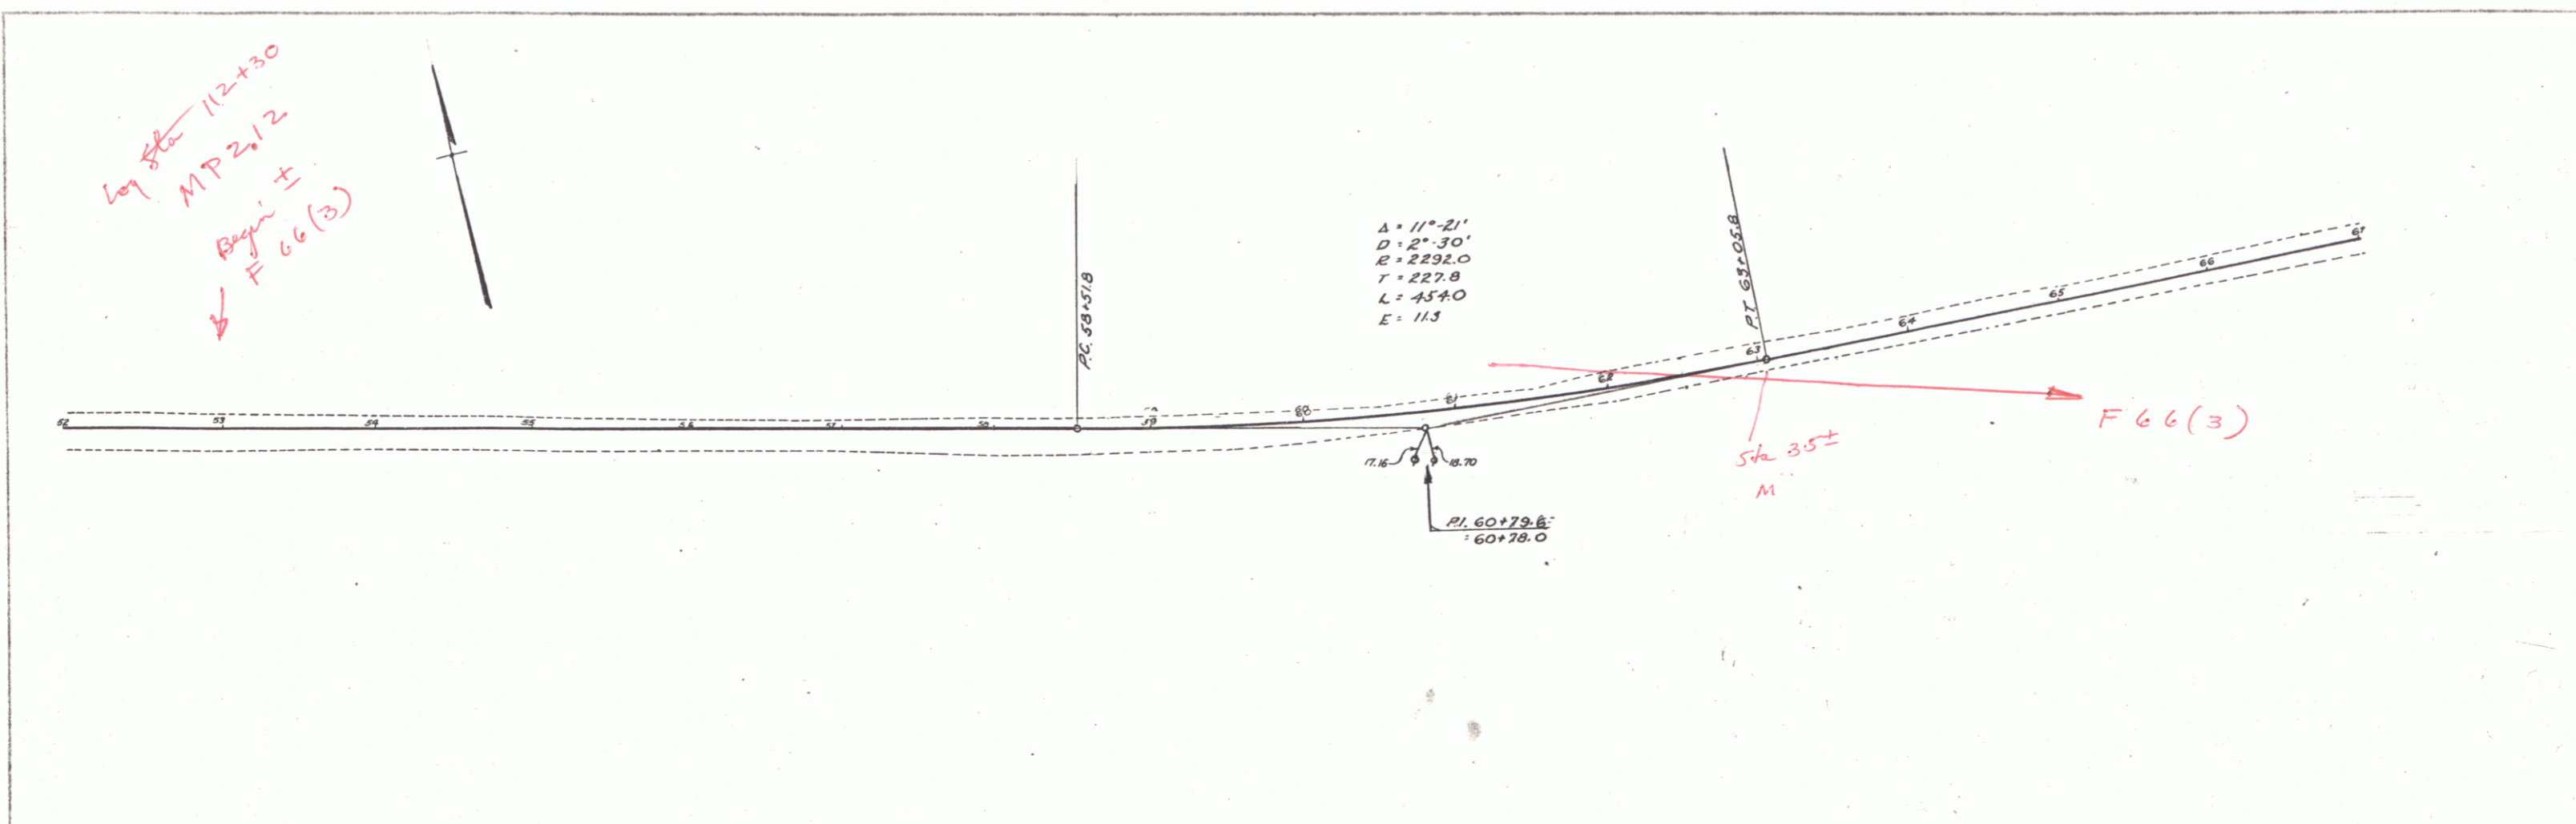


PLATE 1 - PLAN & PROFILE - C. P. & A. P. ENGINEERS, INC., BALTIMORE, MD., U.S.A.

TOWN OF SHELDON
 1930
 SHEET 3 OF 20