
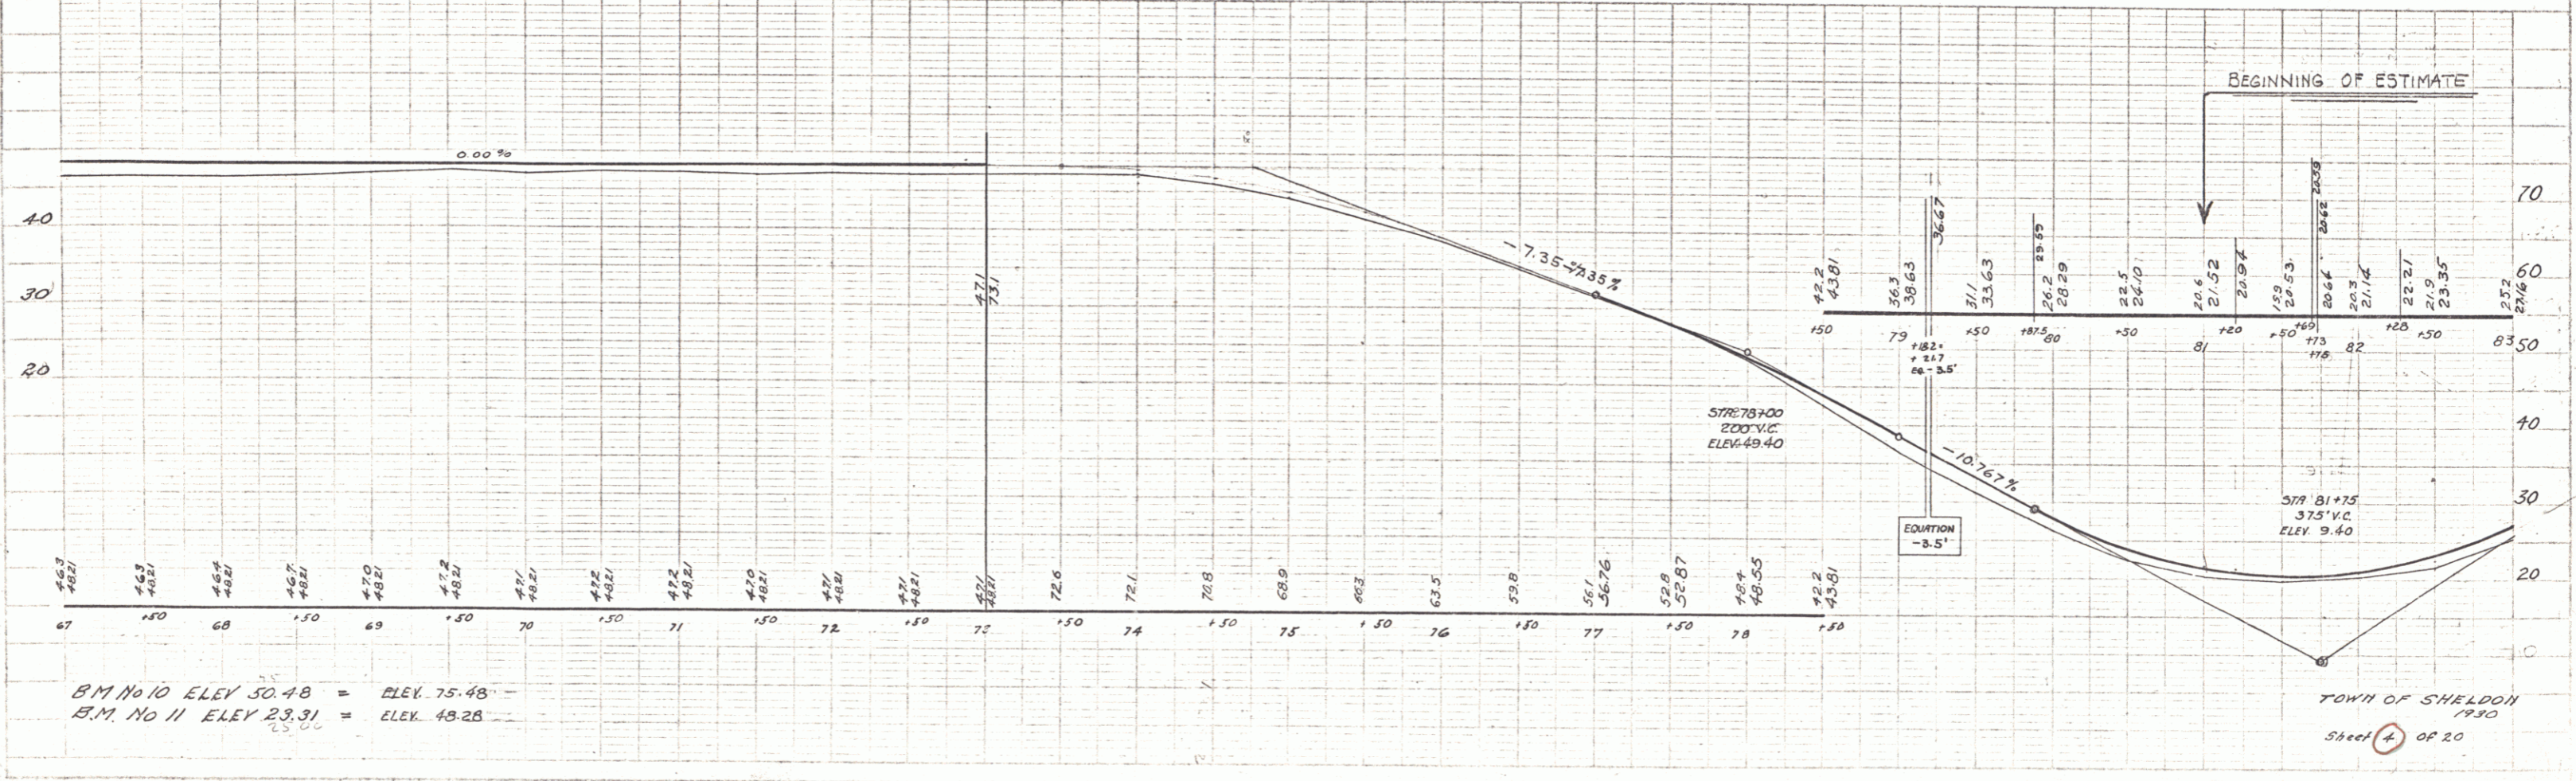


PLAN  
 RR DOE  
 REVISION  
 6-2-30

RR DOE  
 REVISION  
 6-2-30

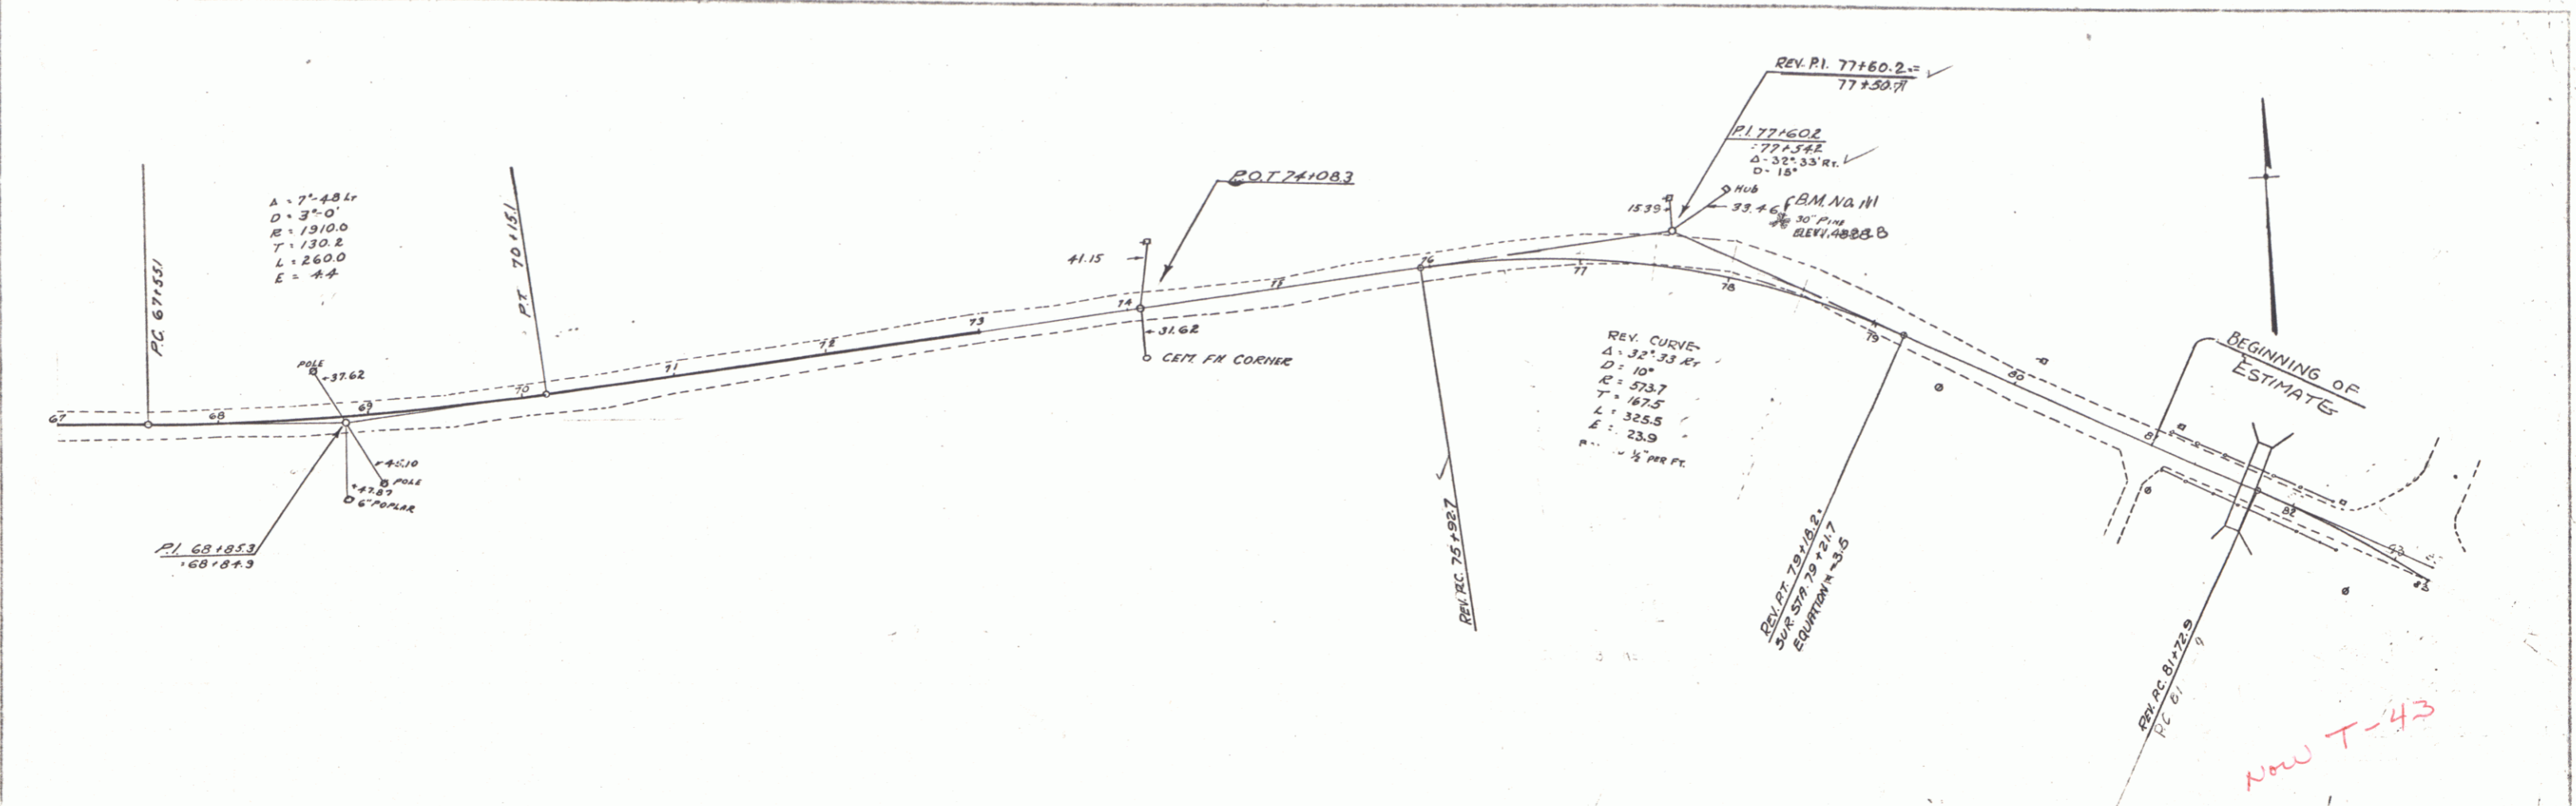

B.M. No 10 ELEV 50.48 = ELEV. 75.48  
 B.M. No 11 ELEV 23.31 = ELEV. 48.28

TOWN OF SHELDON  
 1930  
 Street 4 OF 20