
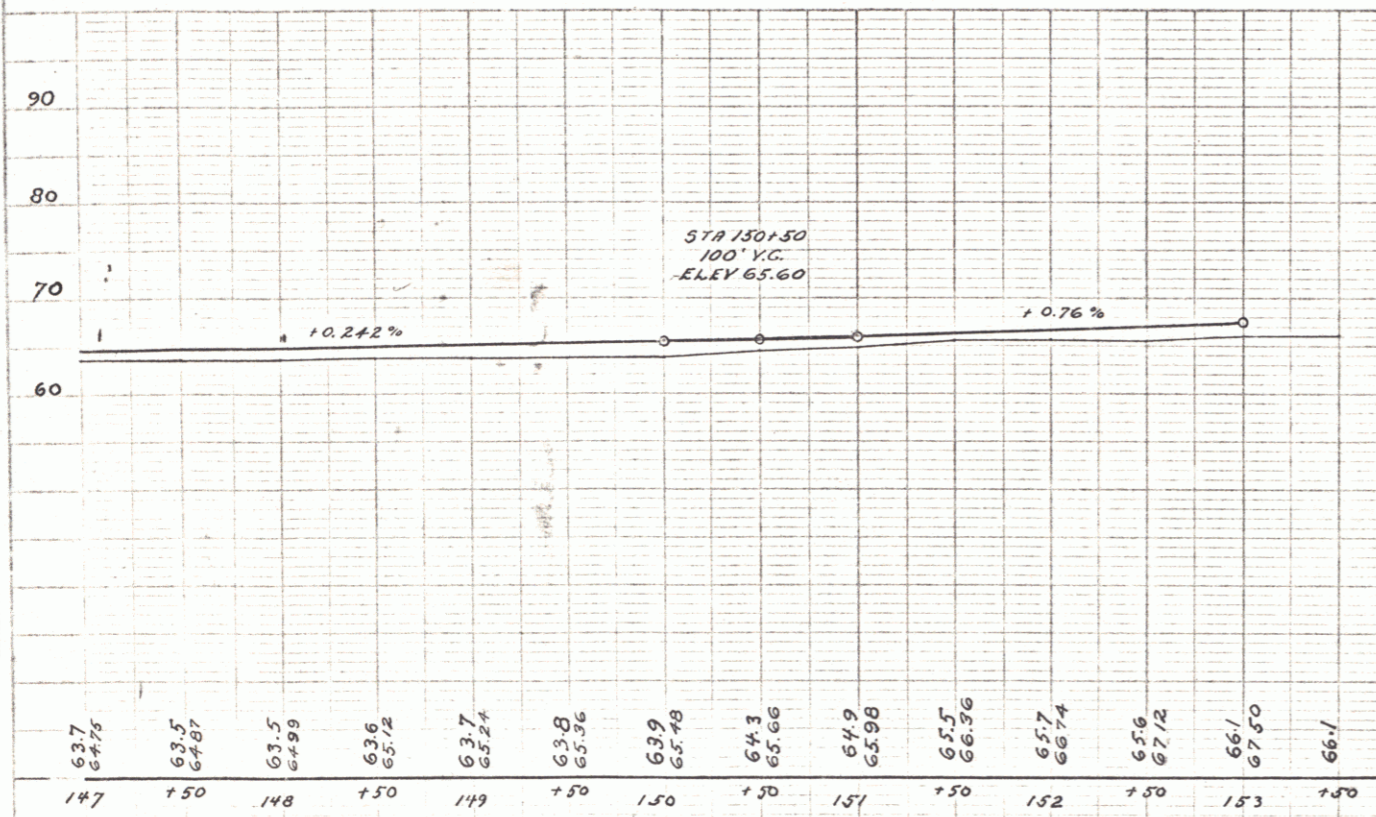


PLAN
 1/4" = 100'
 DATE 1930
 SHEET NO. 9 OF 20

6" x 10" SCALE
 DATE 1930
 SHEET NO. 9 OF 20

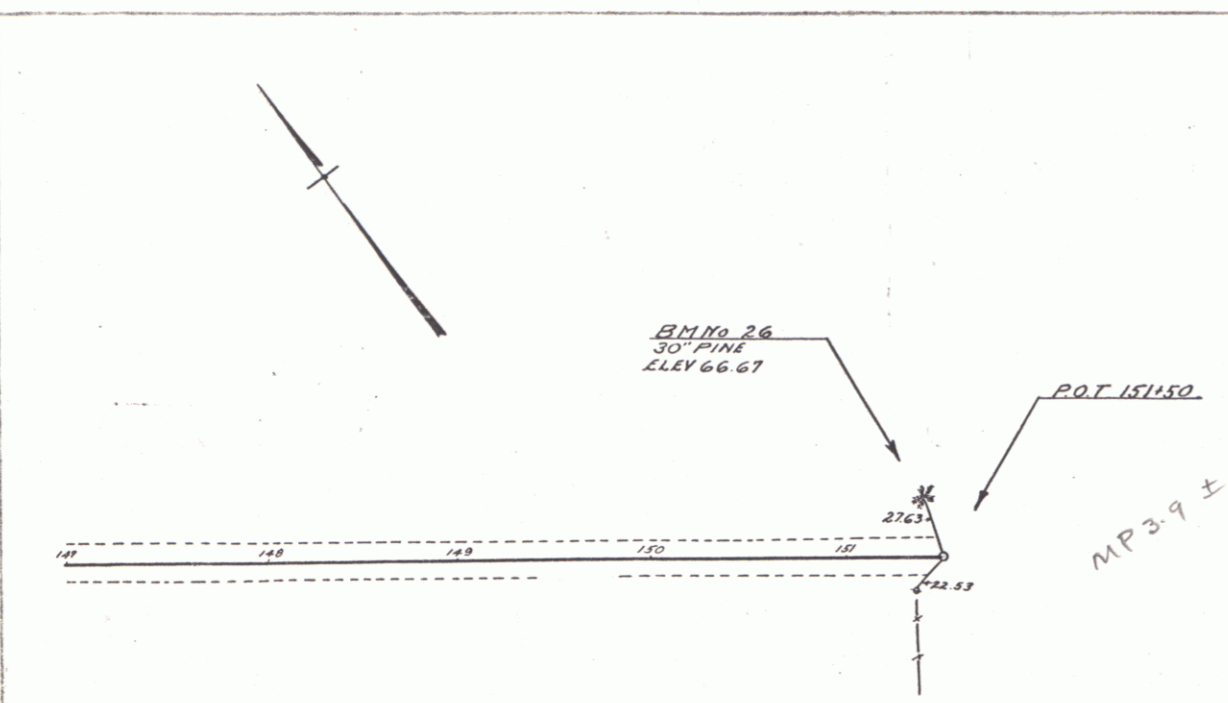

B.M. No 26 36" PINE 27' LEFT OF STR 151.41 ELEV 66.67