



PLAN
 SHEET NO. 1
 DATE: 1918
 BY: C. W. HARRIS
 CHECKED BY: J. W. HARRIS

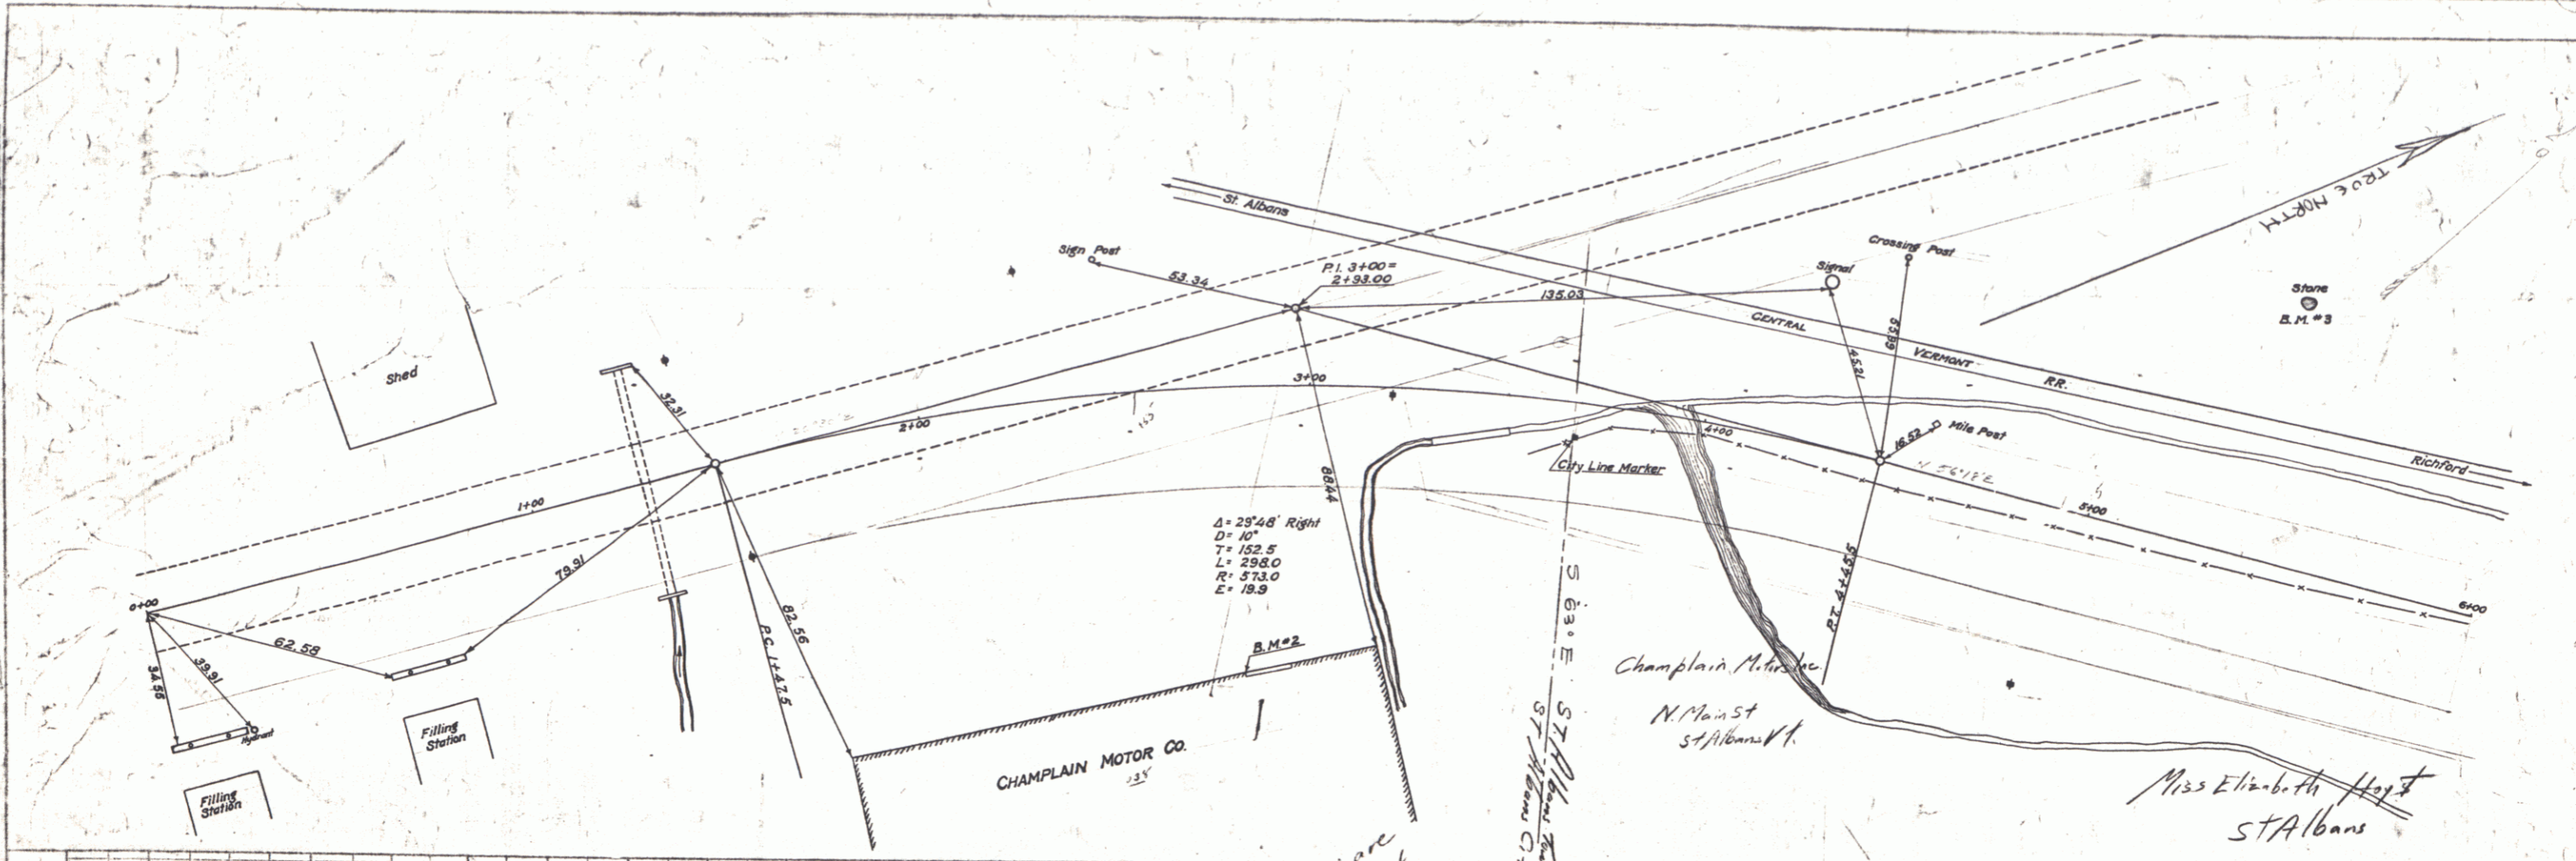

PROFILE
 SHEET NO. 1
 DATE: 1918
 BY: C. W. HARRIS
 CHECKED BY: J. W. HARRIS

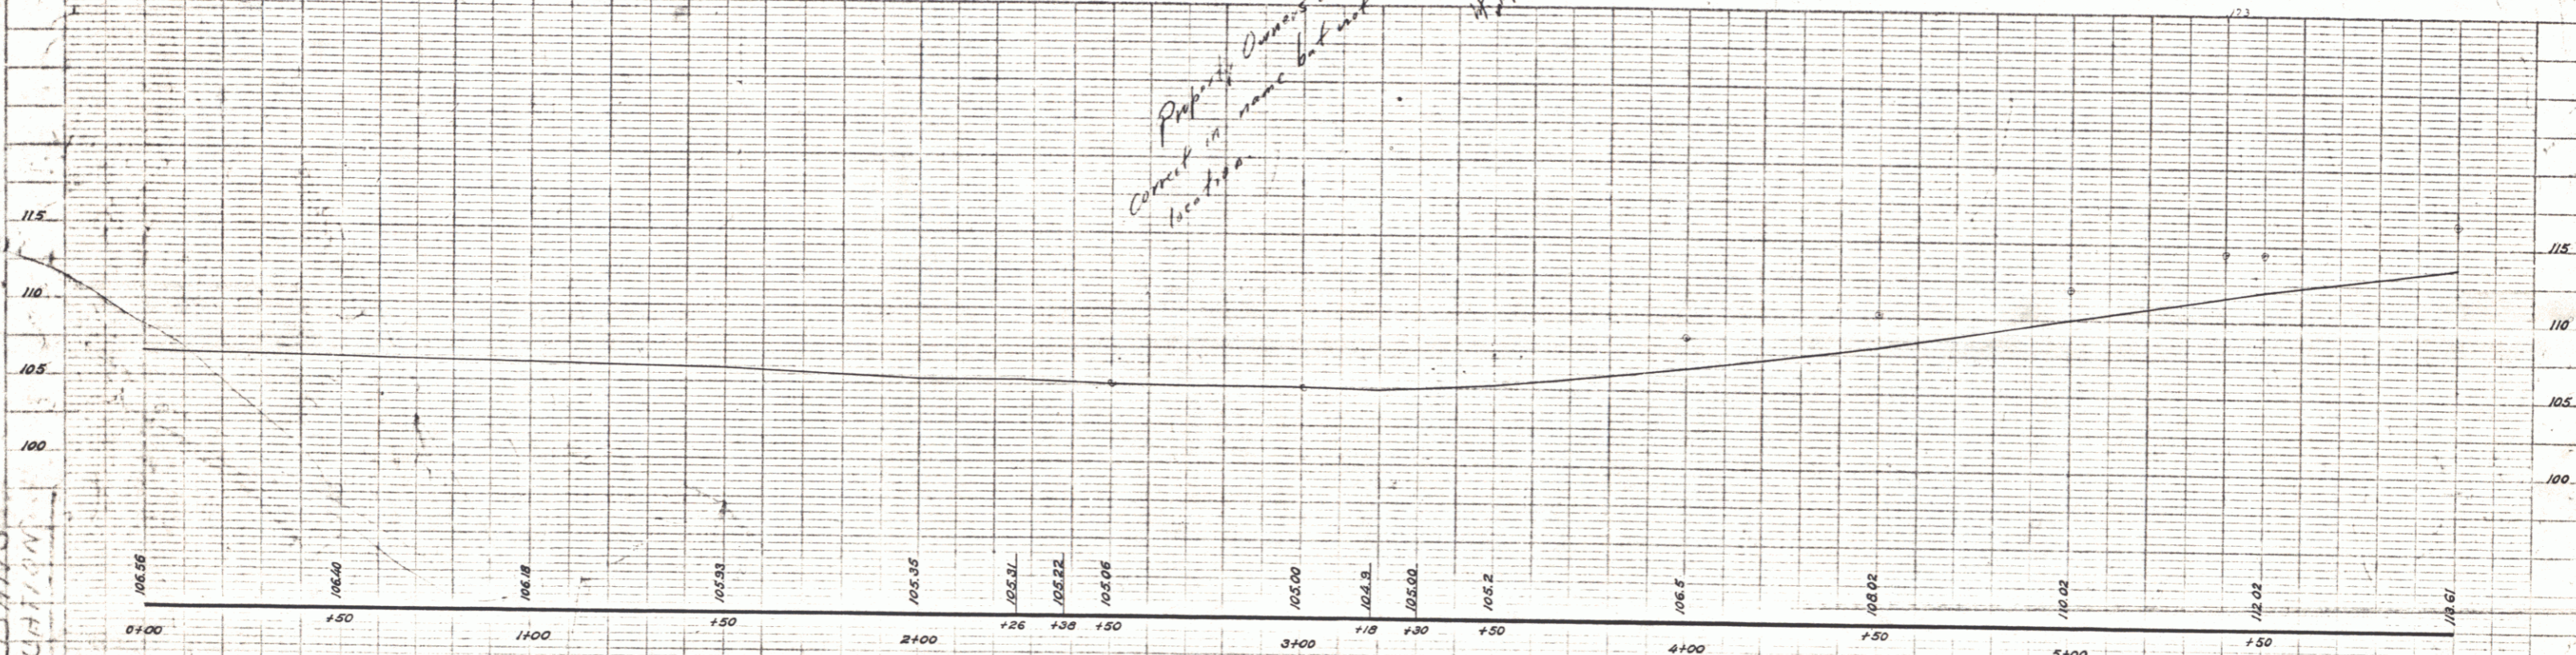

*Property Owners are
 correct in name but not
 location.*

ST. ALBANS
 VERMONT

B.M.#1 - Spike in Ash Tree West side of road 1' above ground - Elev. 100.00
 B.M.#2 - Right corner North 1/2 door of garage wood frame meeting brick - Elev. 107.45
 B.M.#3 - Top of boulder West side of R.R. 30' from rail - Elev. 103.315

SHEET 1

3