
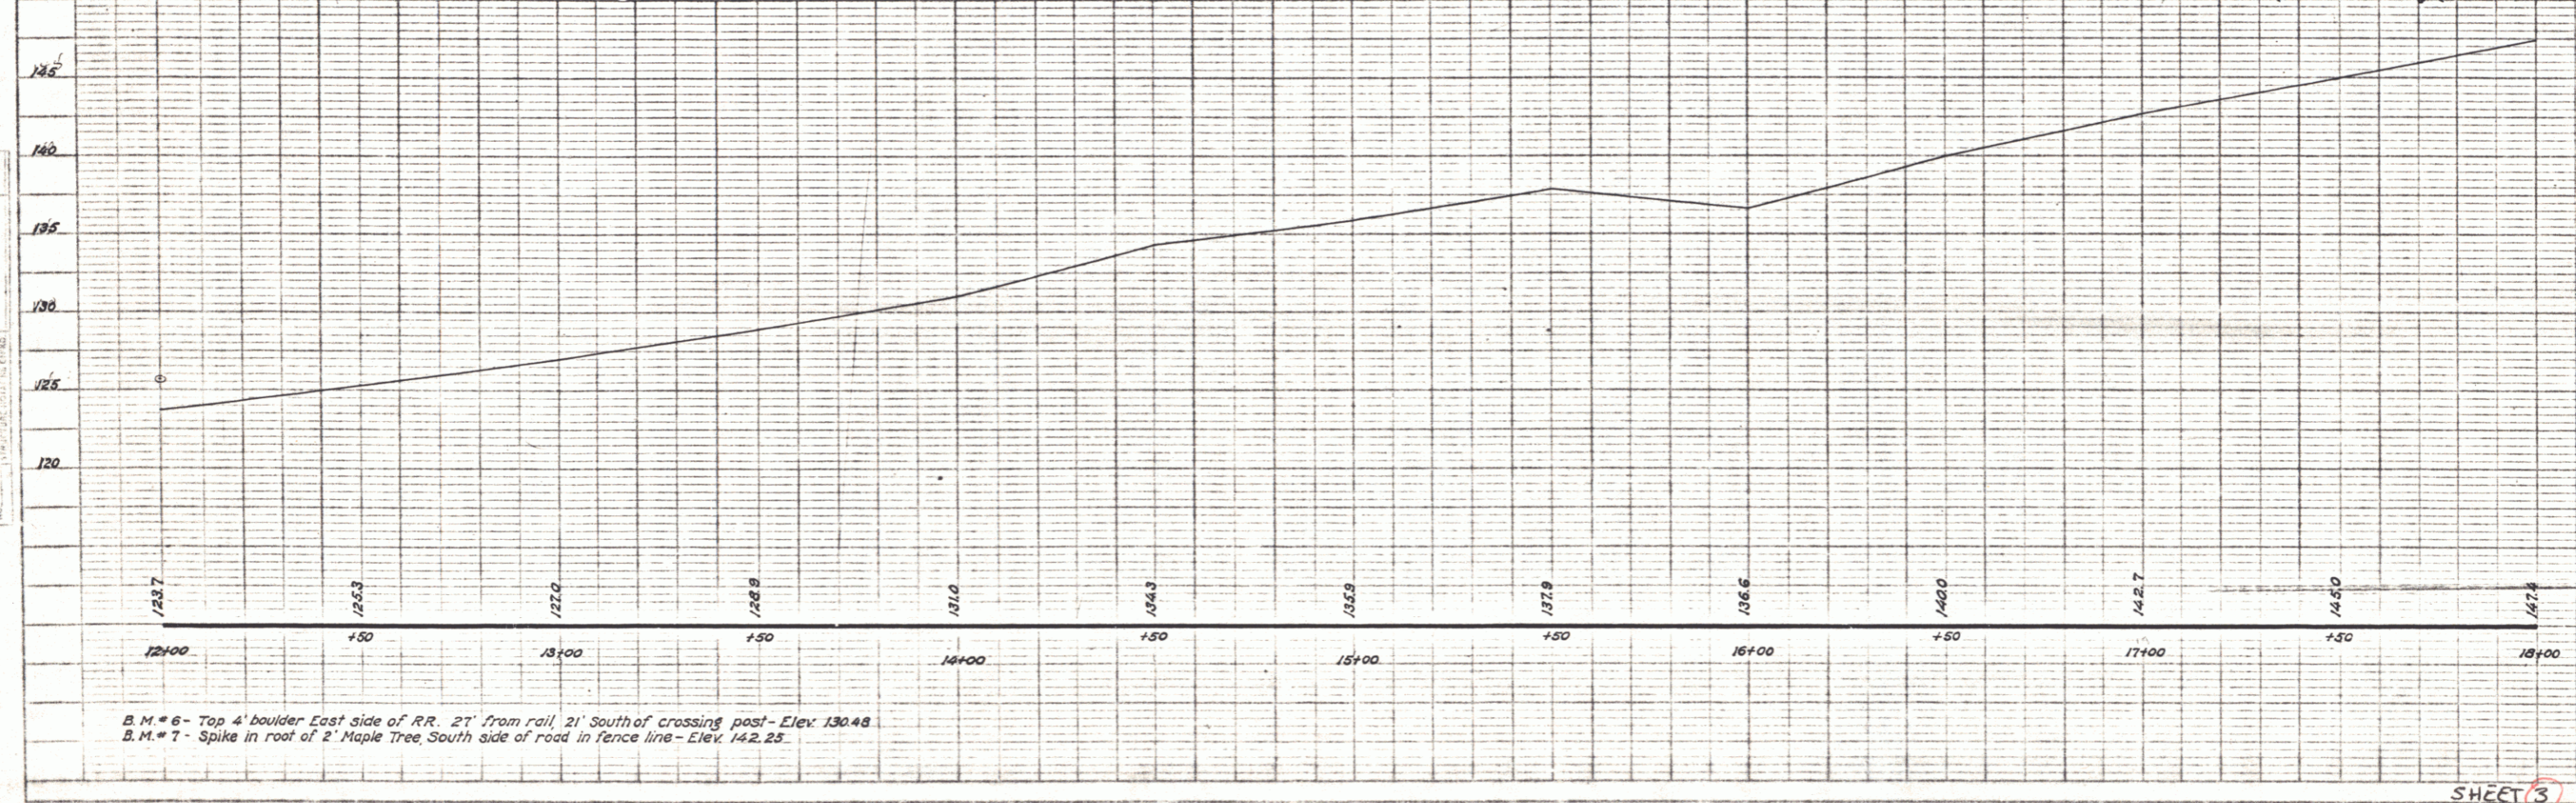


PLAN  
 DYNAMIC  
 GEANT

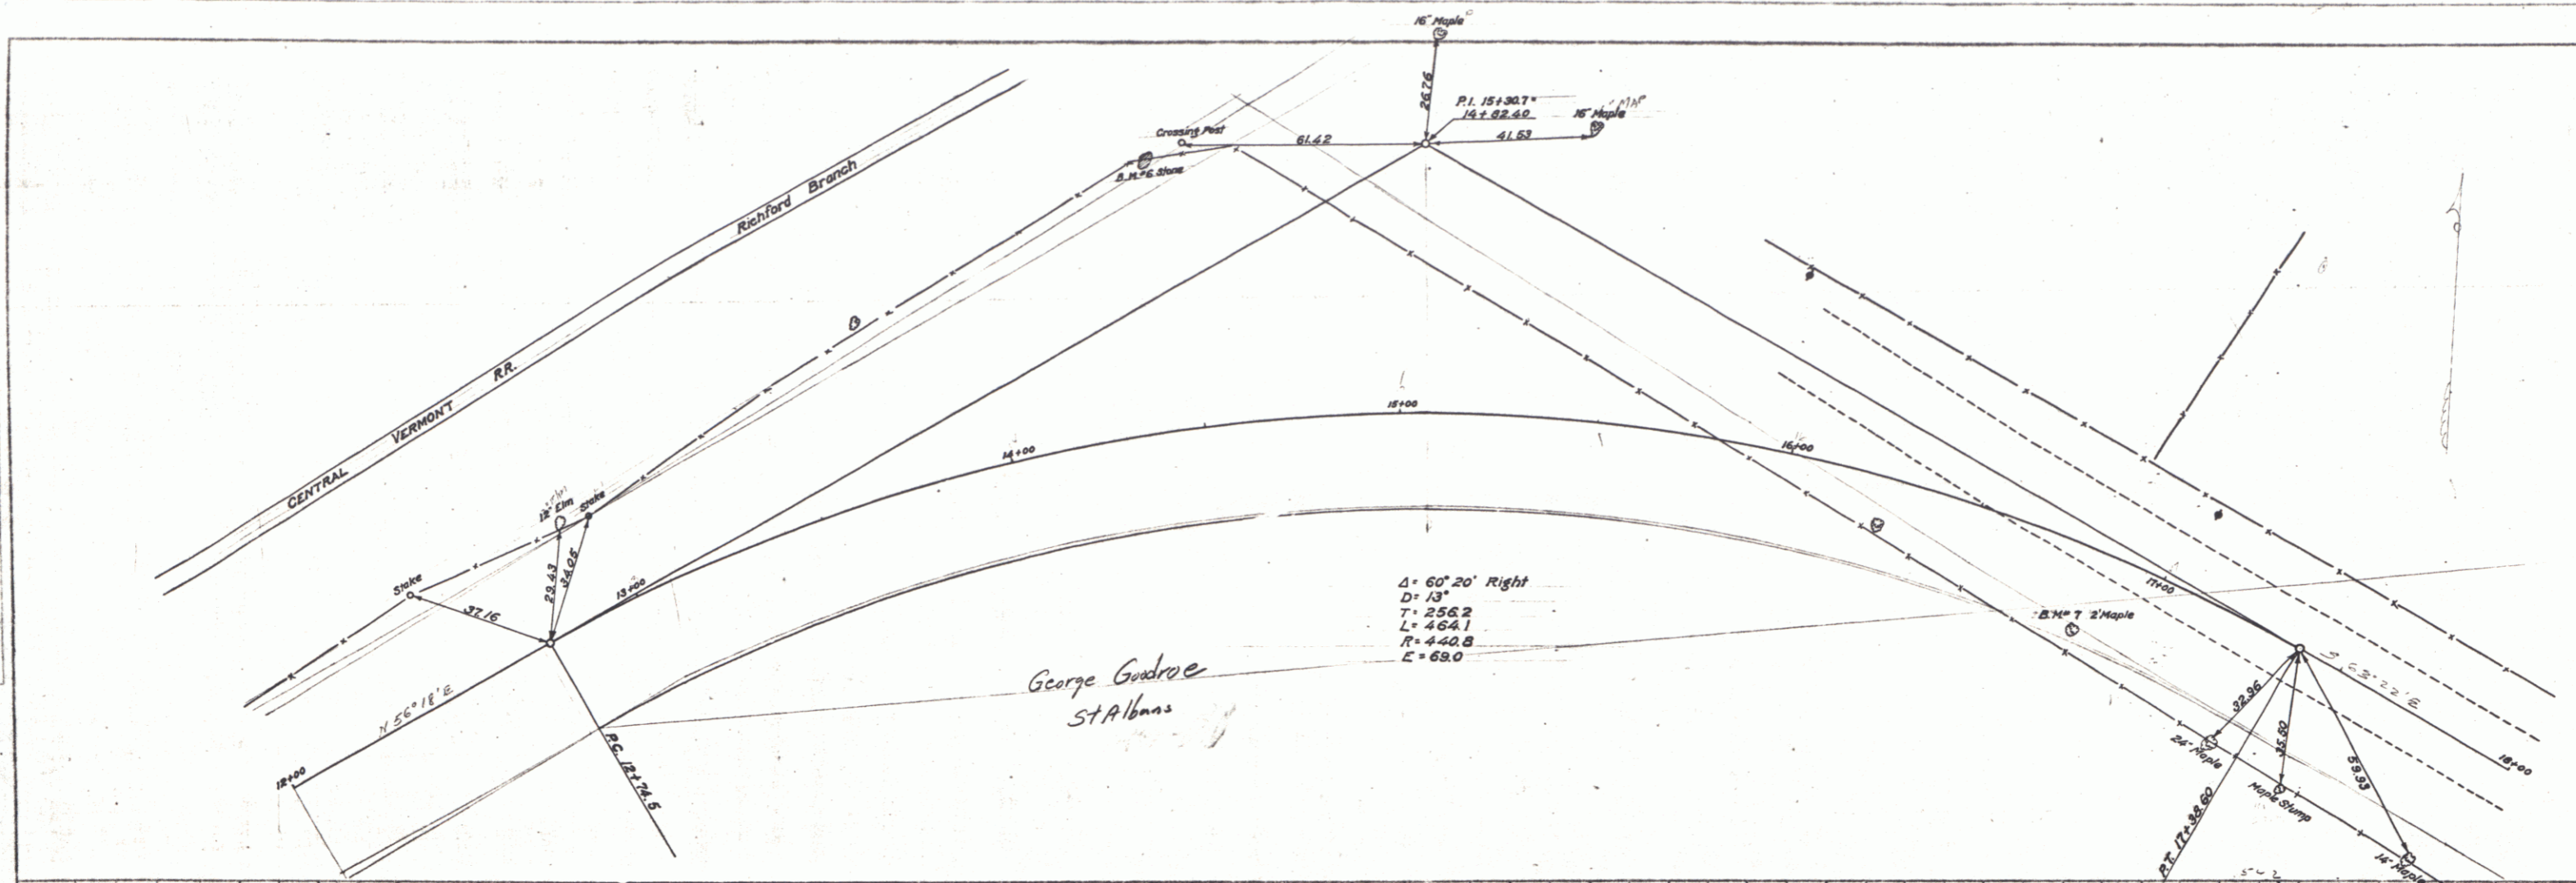

B.M. # 6 - Top 4' boulder East side of RR 21' from rail, 21' South of crossing post - Elev. 130.48  
 B.M. # 7 - Spike in root of 2' Maple Tree, South side of road in fence line - Elev. 142.25

PLATE 1-11-1907-2 C. F. A. & C. STANBROOK  
 CIVIL & ENGINEERING CO. ST. ALBANS, VT.

SHEET 3

5