

Not Built - see S139M

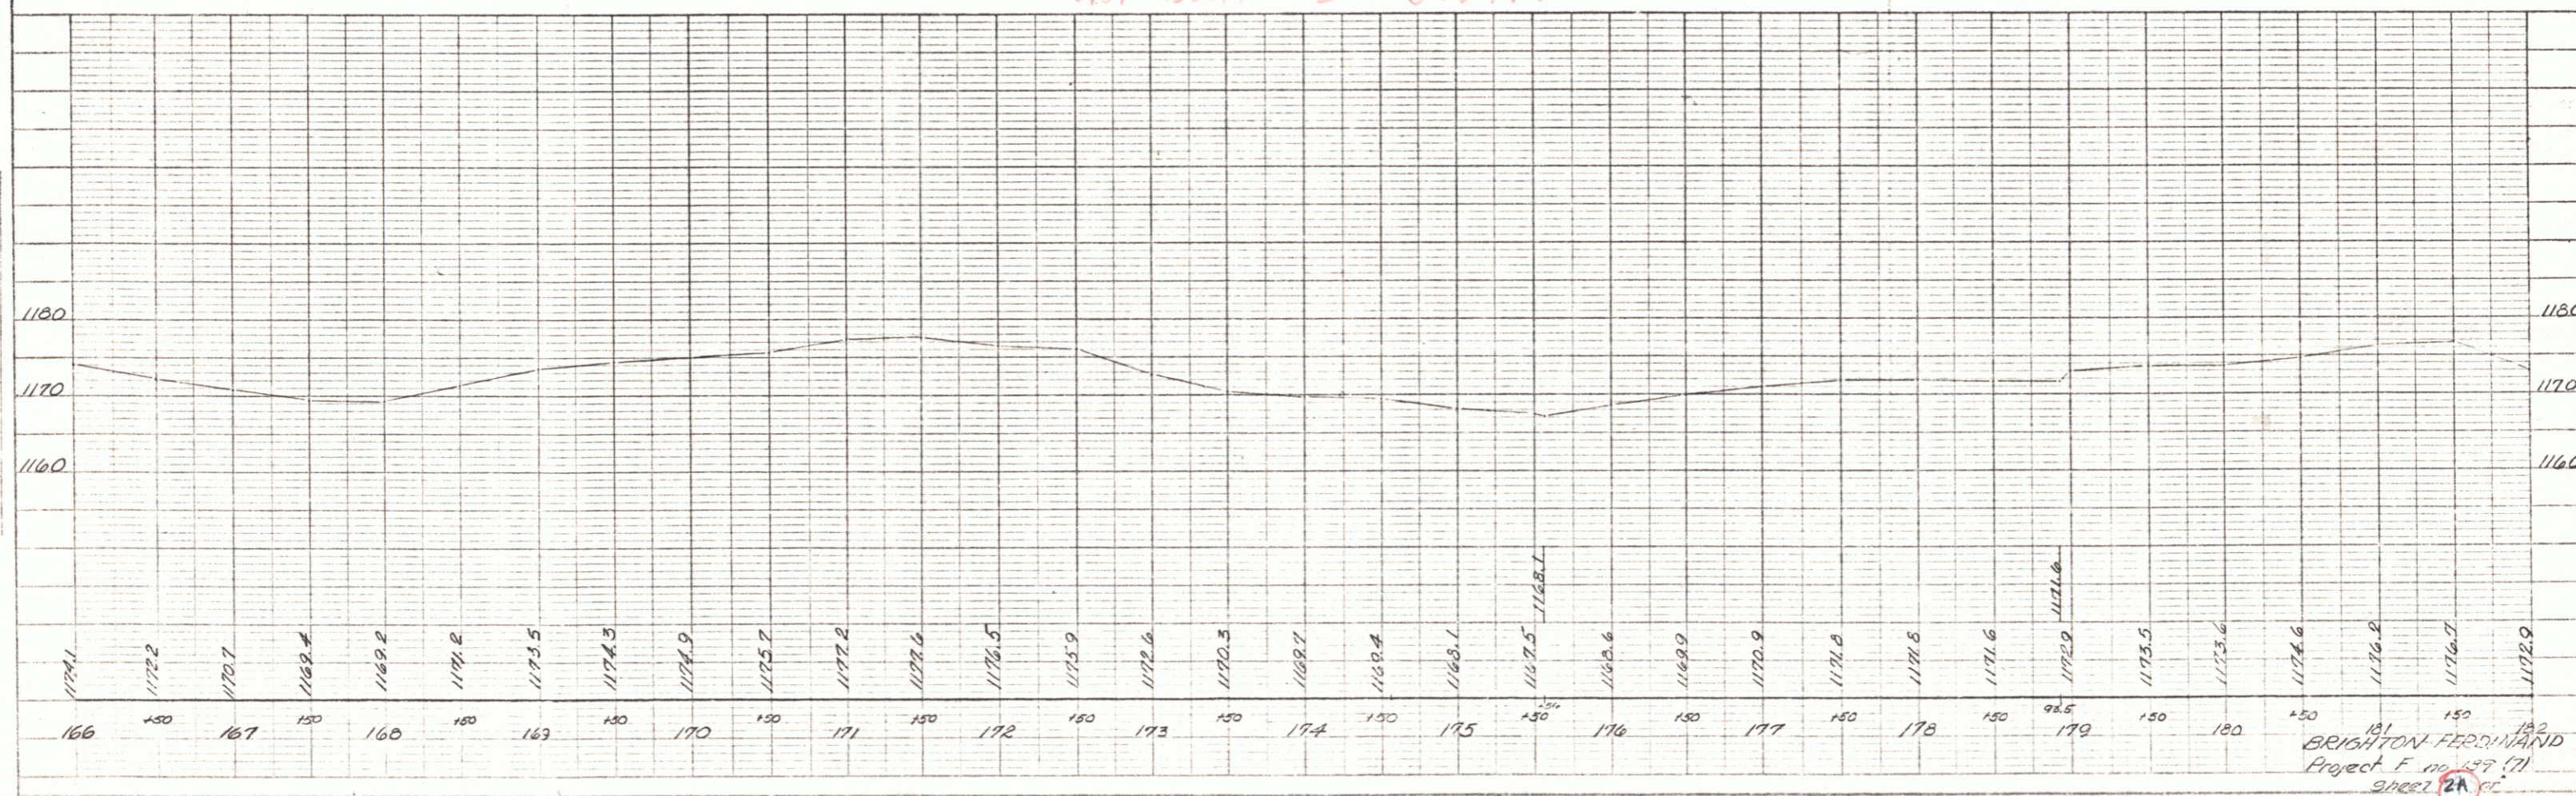


PLATE 1 - PLAN PROFILE & P & B BY STANDARD
 ARCHITECTURE CO. INC. 1958
 P & B CO. NO. 348-03