


PLAN
 CHECKED BY: _____
 DATE: _____
 NOTE BOOK NO. _____
 RE. OF WAY CHECKED: _____

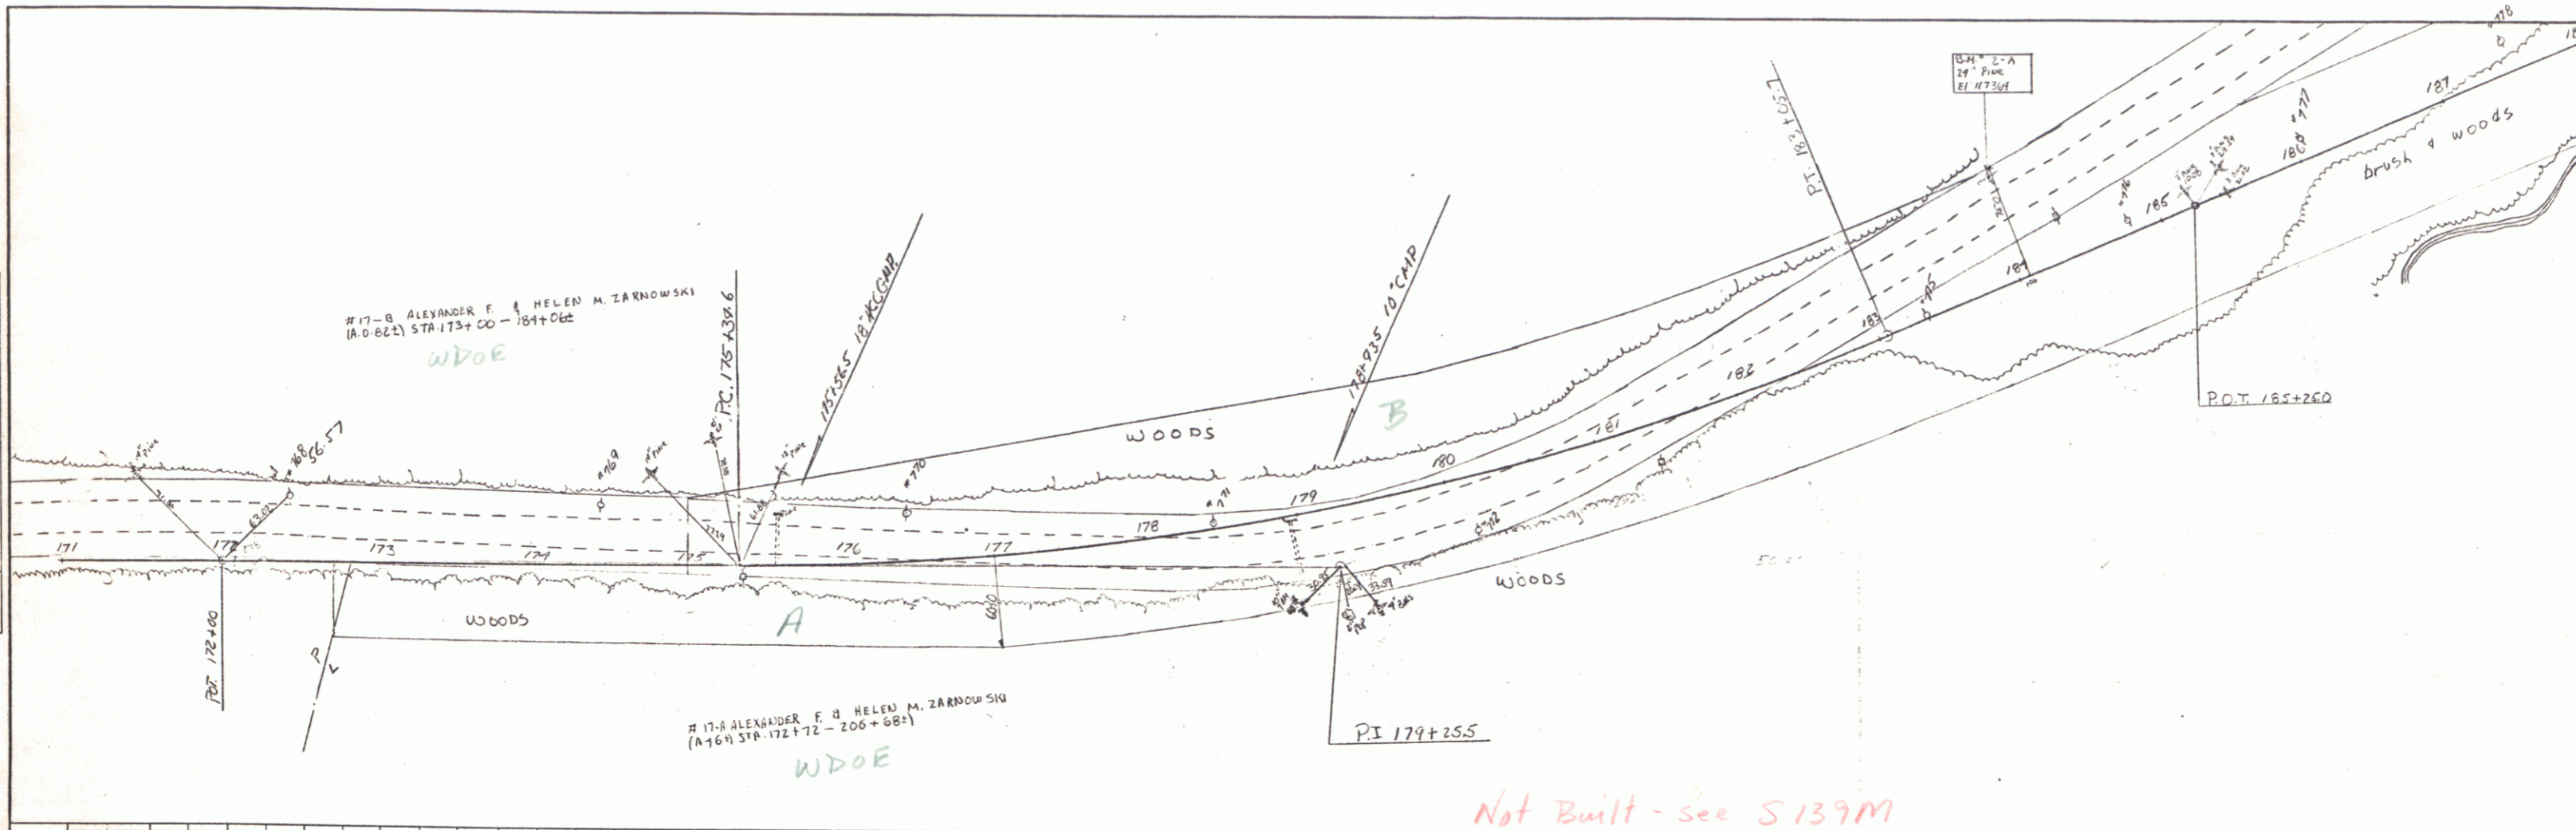

Not Built - see S 139M

PROFILE
 CHECKED BY: _____
 DATE: _____
 NOTE BOOK NO. _____
 RE. OF WAY CHECKED: _____

