


Not Built - see S 139M

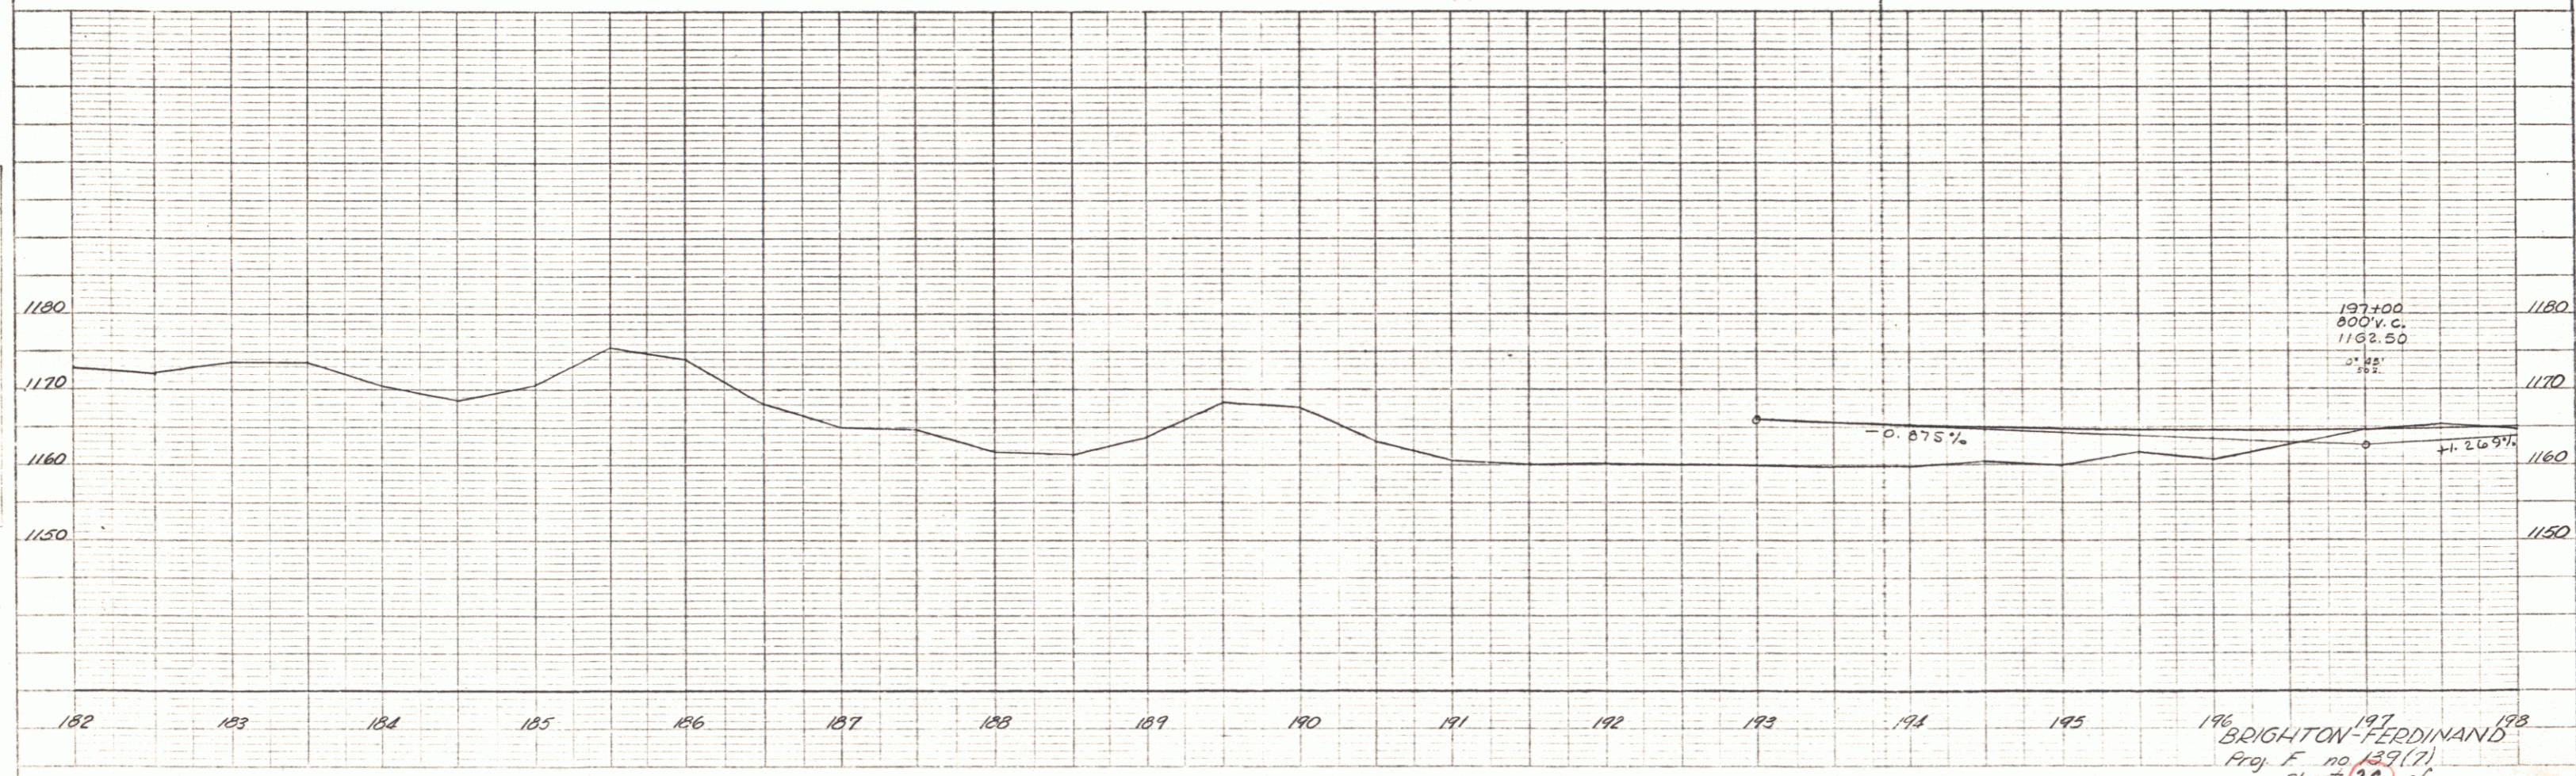

PLAN
 DATE: 11/1/54
 BY: A.F.Z.
 CHECKED: H.M.Z.
 NO. 1

PROFILE
 DATE: 11/1/54
 BY: A.F.Z.
 CHECKED: H.M.Z.
 NO. 1

PLATE 3 - PLAN PROFILE OF PARKWAY
 HOFFER & CO. INC., NEW YORK
 115 W. 40th St., New York 18, N.Y.