
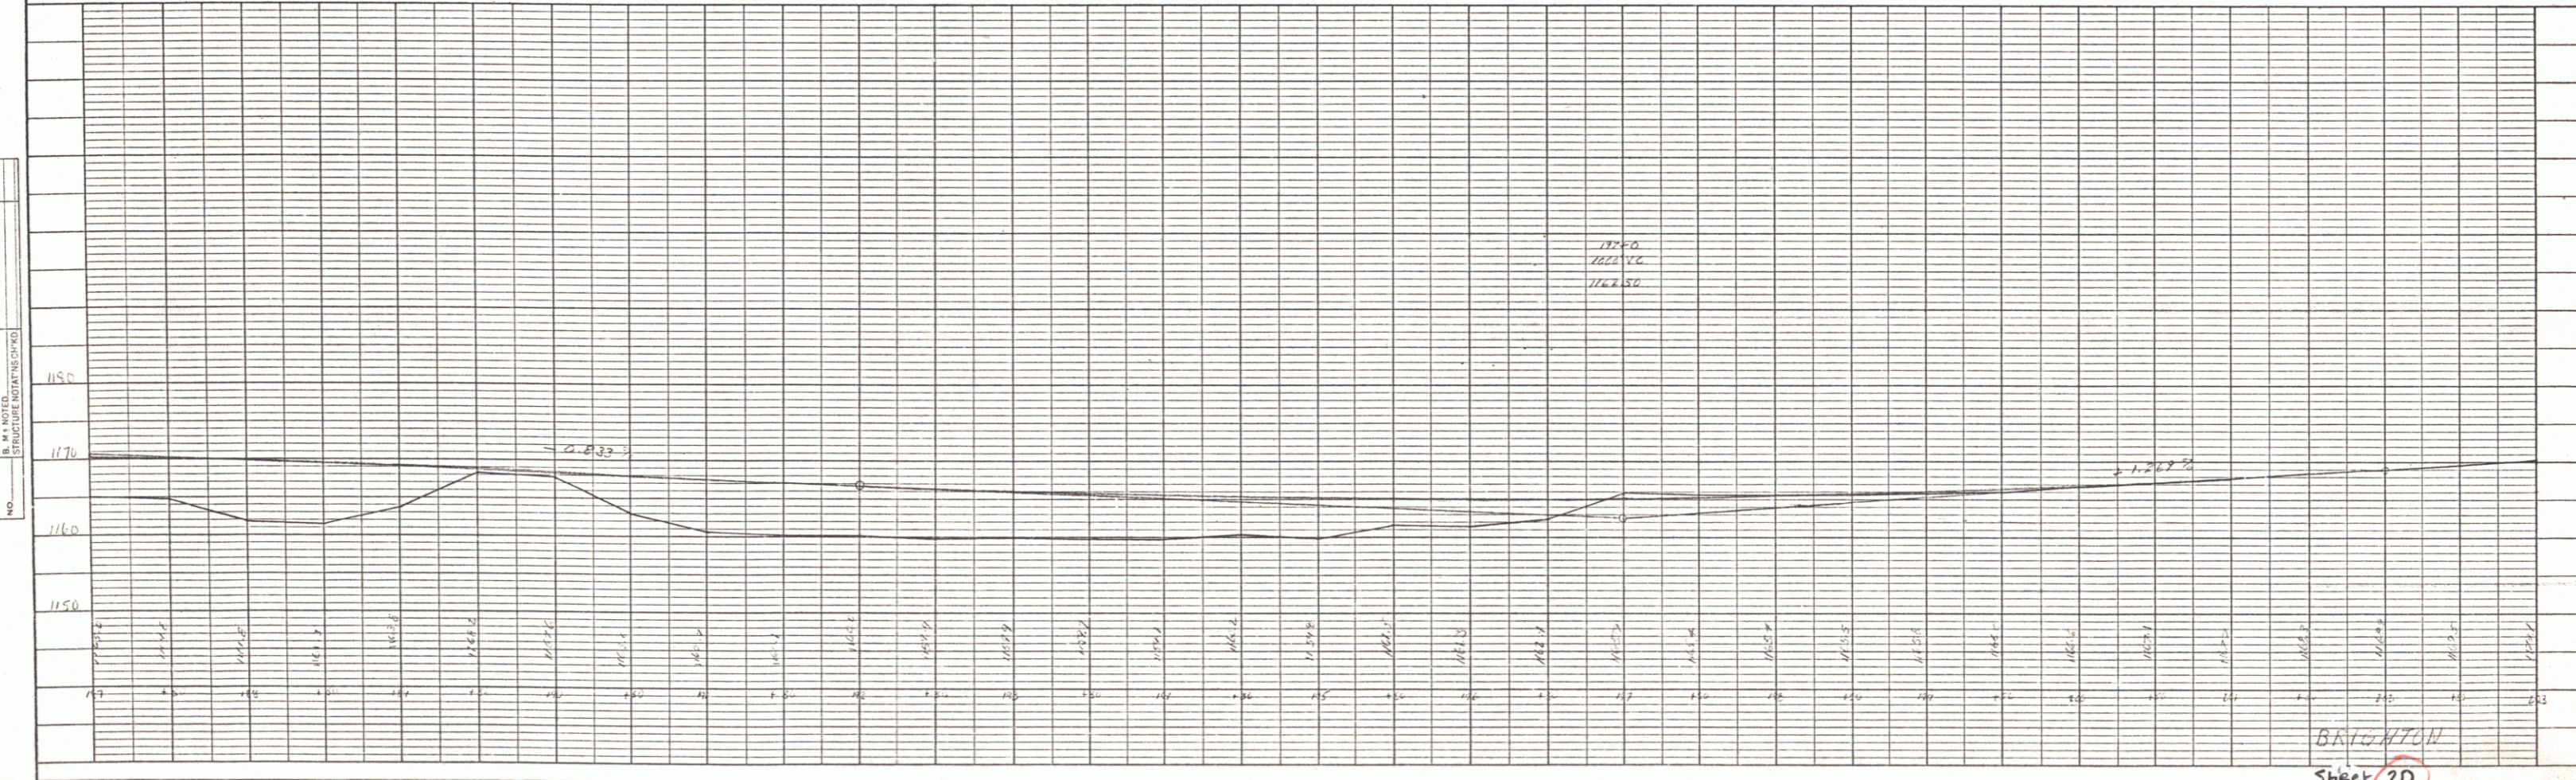


DATE: _____
 BY: Z.A.M./A.L.Z.
 CHECKED: _____
 NO. _____

DATE: _____
 BY: _____
 CHECKED: _____
 NO. _____

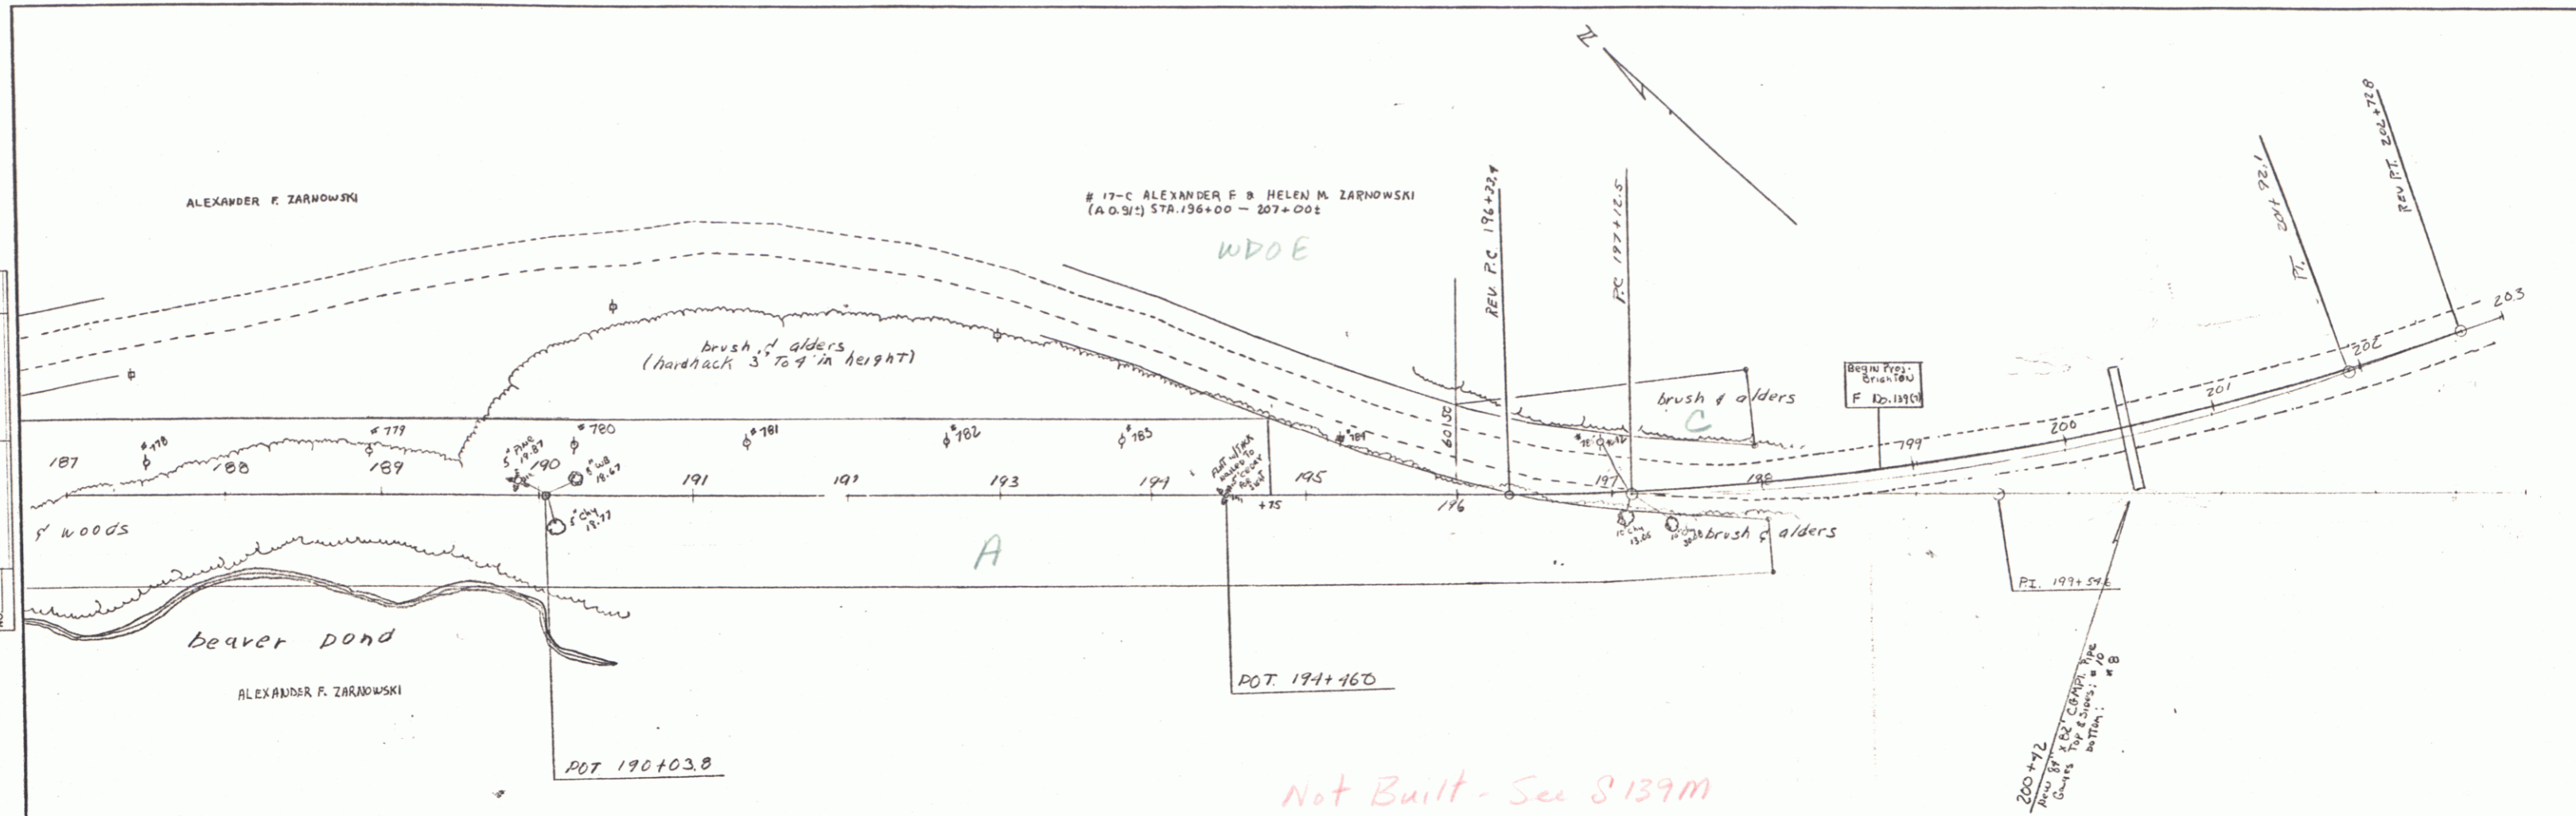

17-C ALEXANDER F B HELEN M ZARNOWSKI
 (A.O.S.) STA. 196+00 - 207+00

ALEXANDER F. ZARNOWSKI

ALEXANDER F. ZARNOWSKI

WDOE

A

brush of alders

Begin Field
 Erist. 760
 F 12.1100

POT 191+460

Not Built - See S 139M

200+72
 Area of
 1.26%
 1.26%
 1.26%