

THREE CABLE GUARD RAIL WITH STEEL POSTS
Sta. 288+19-290+75 Lt Rt 25'


STEEL GUIDE POSTS
Sta. Lt Rt
288+00 1 1
290+50 1 1
293+00 1 1
296+17 2 2

CONSTRUCT DRIVE
283+00 E


EXCAVATION & REMOVAL OF SURFACE ON DISCONTINUED ROADWAYS
284+00-284+35 Lt
287+00-288+00 Lt
291+00-294+00 Rt

PLANK GUARD RAIL
Sta. 291+25-291+45 Lt Rt 24'

PLAN
DATE 2/6/58
BY [Signature]
CHECKED [Signature]

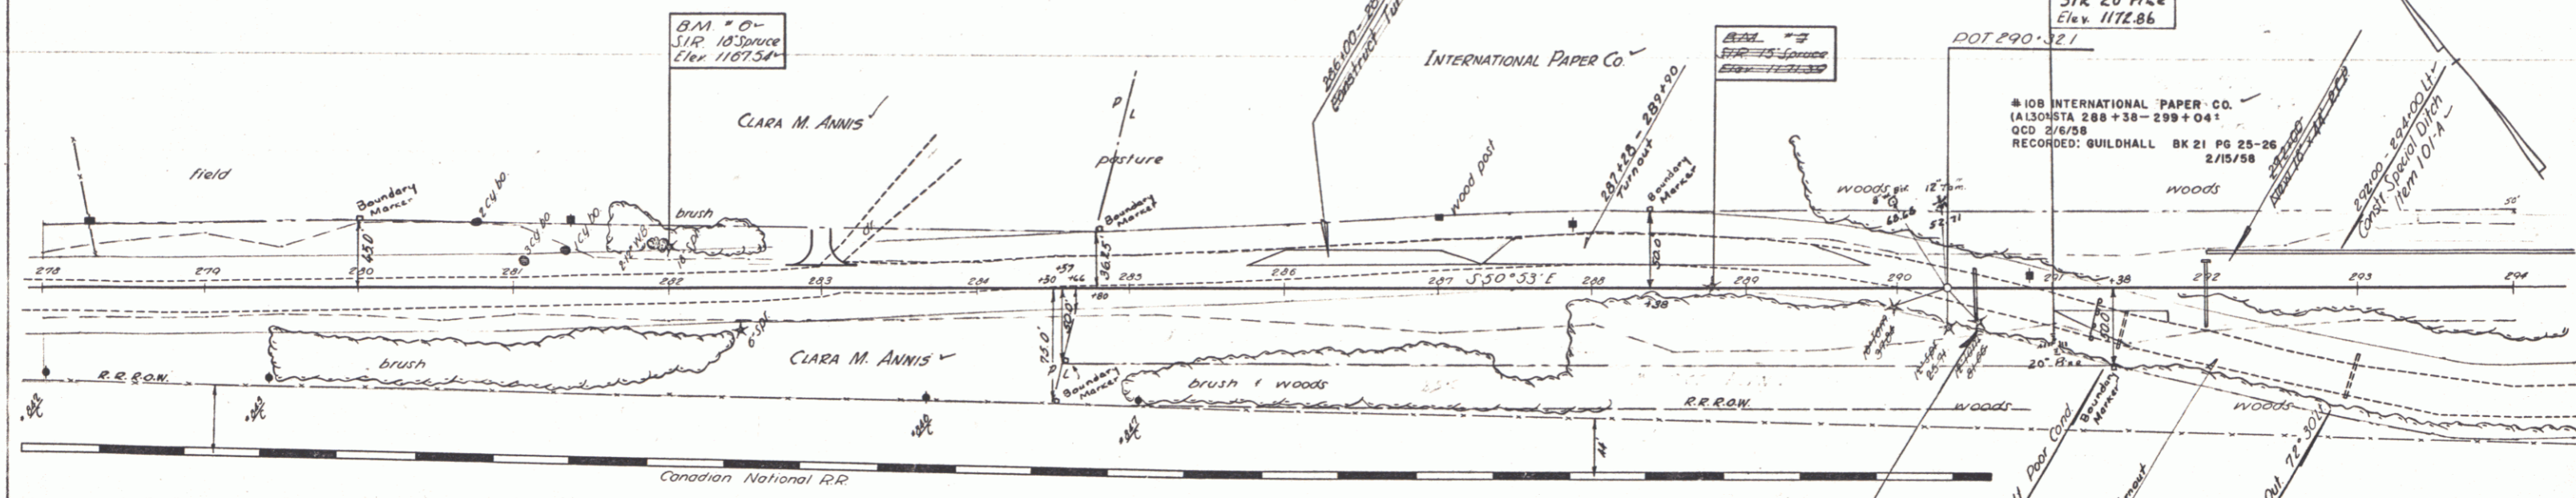

PROFILE
DATE 2/6/58
BY [Signature]
CHECKED [Signature]

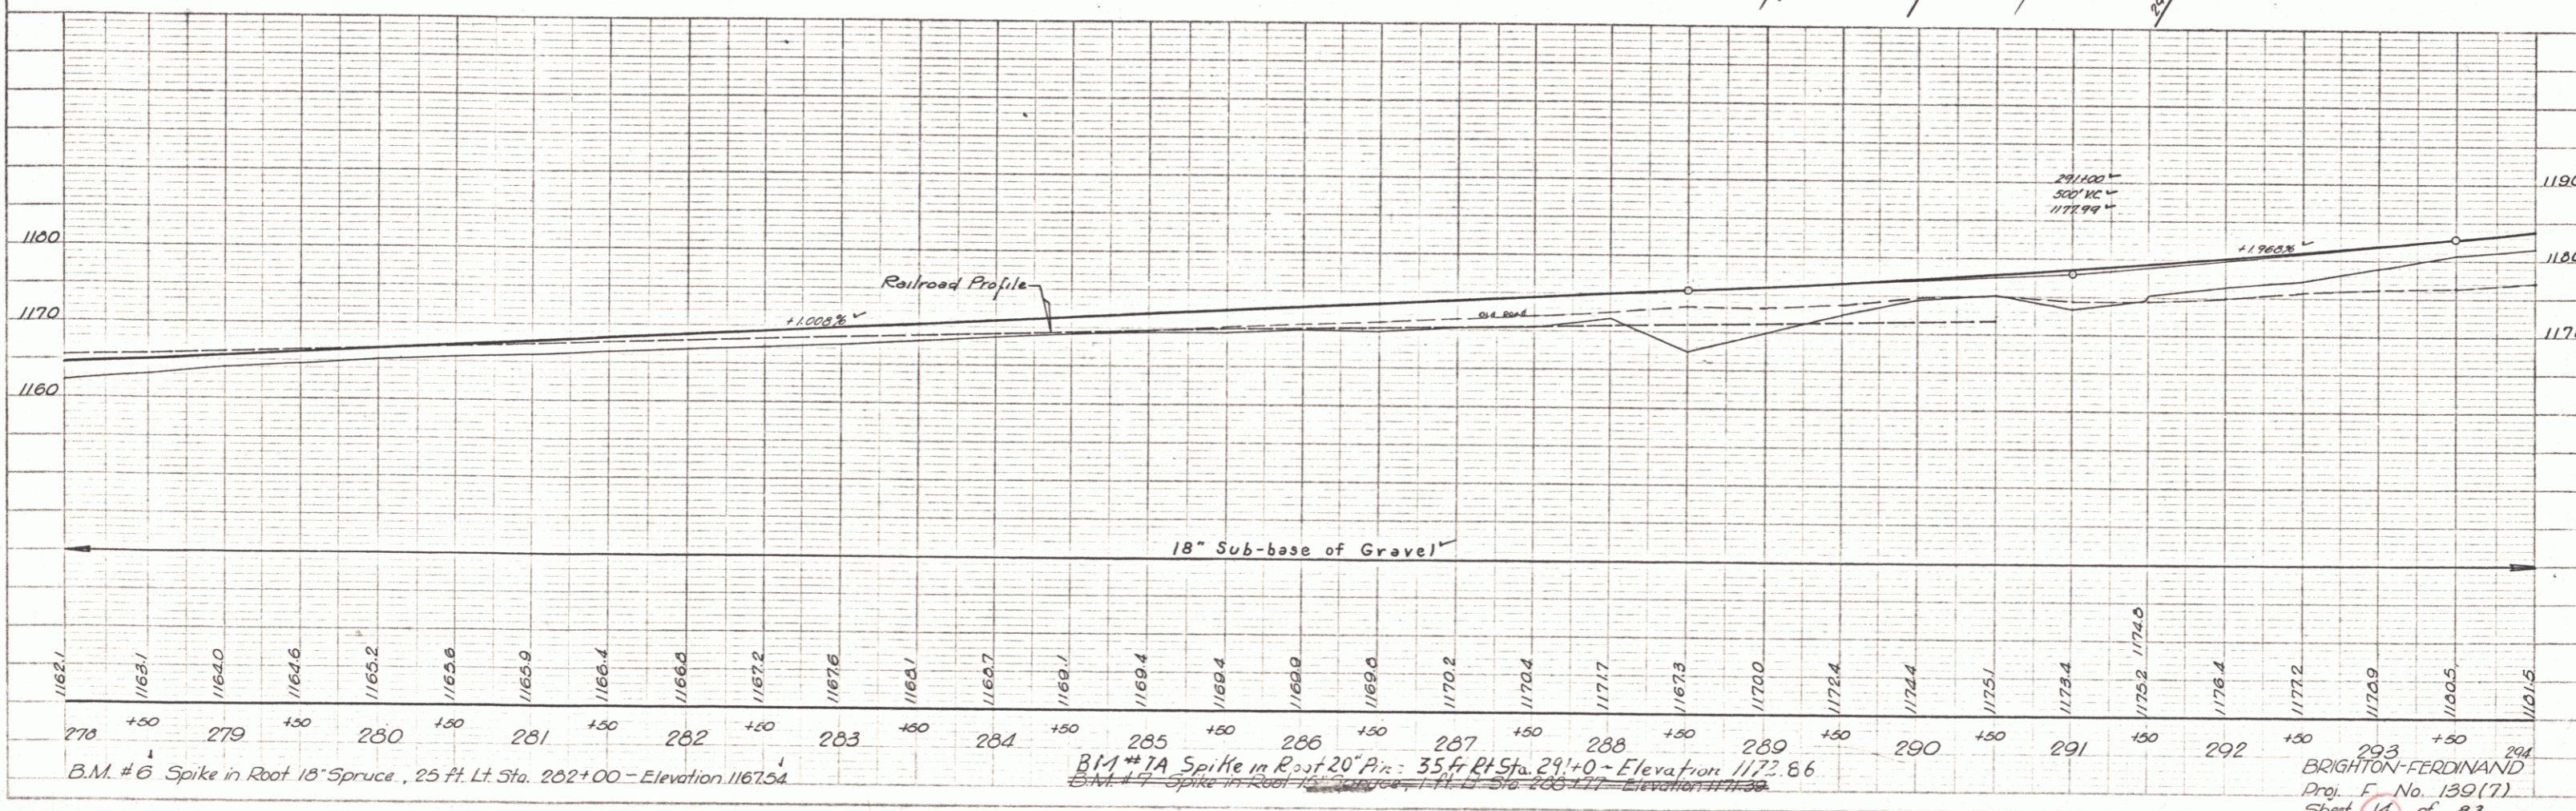

BRIGHTON-FERDINAND
Proj. No. 139(7)
Sheet 14 of 23