
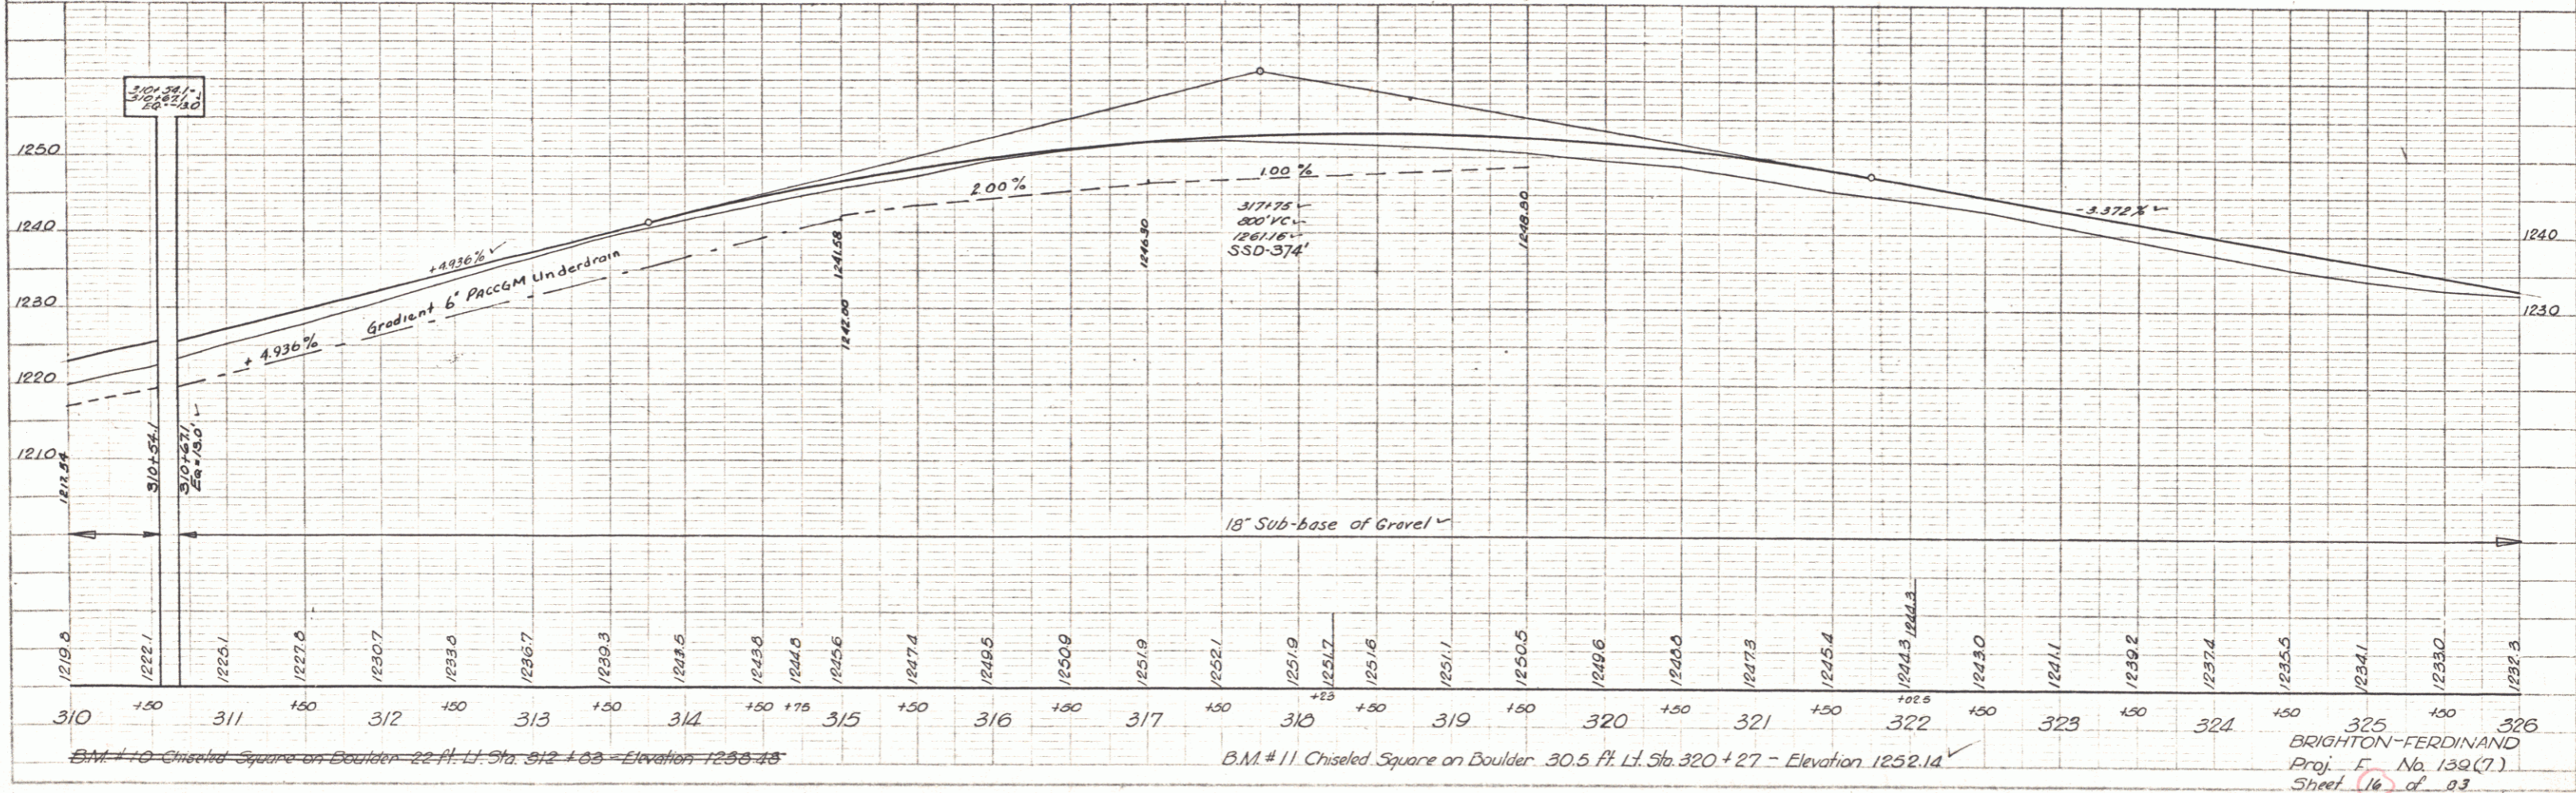


THREE CABLE GUARD RAIL WITH STEEL POSTS
Sta 310+00 - 310+96

CONSTRUCT DRIVES
314+75 Lt
314+75 Rt
318+10 Lt
318+50 Lt

STEEL GUIDE POSTS
Sta Lt Rt
314+96 1 1
316+00 1 1
322+05 1 1
320+82-321+74 5

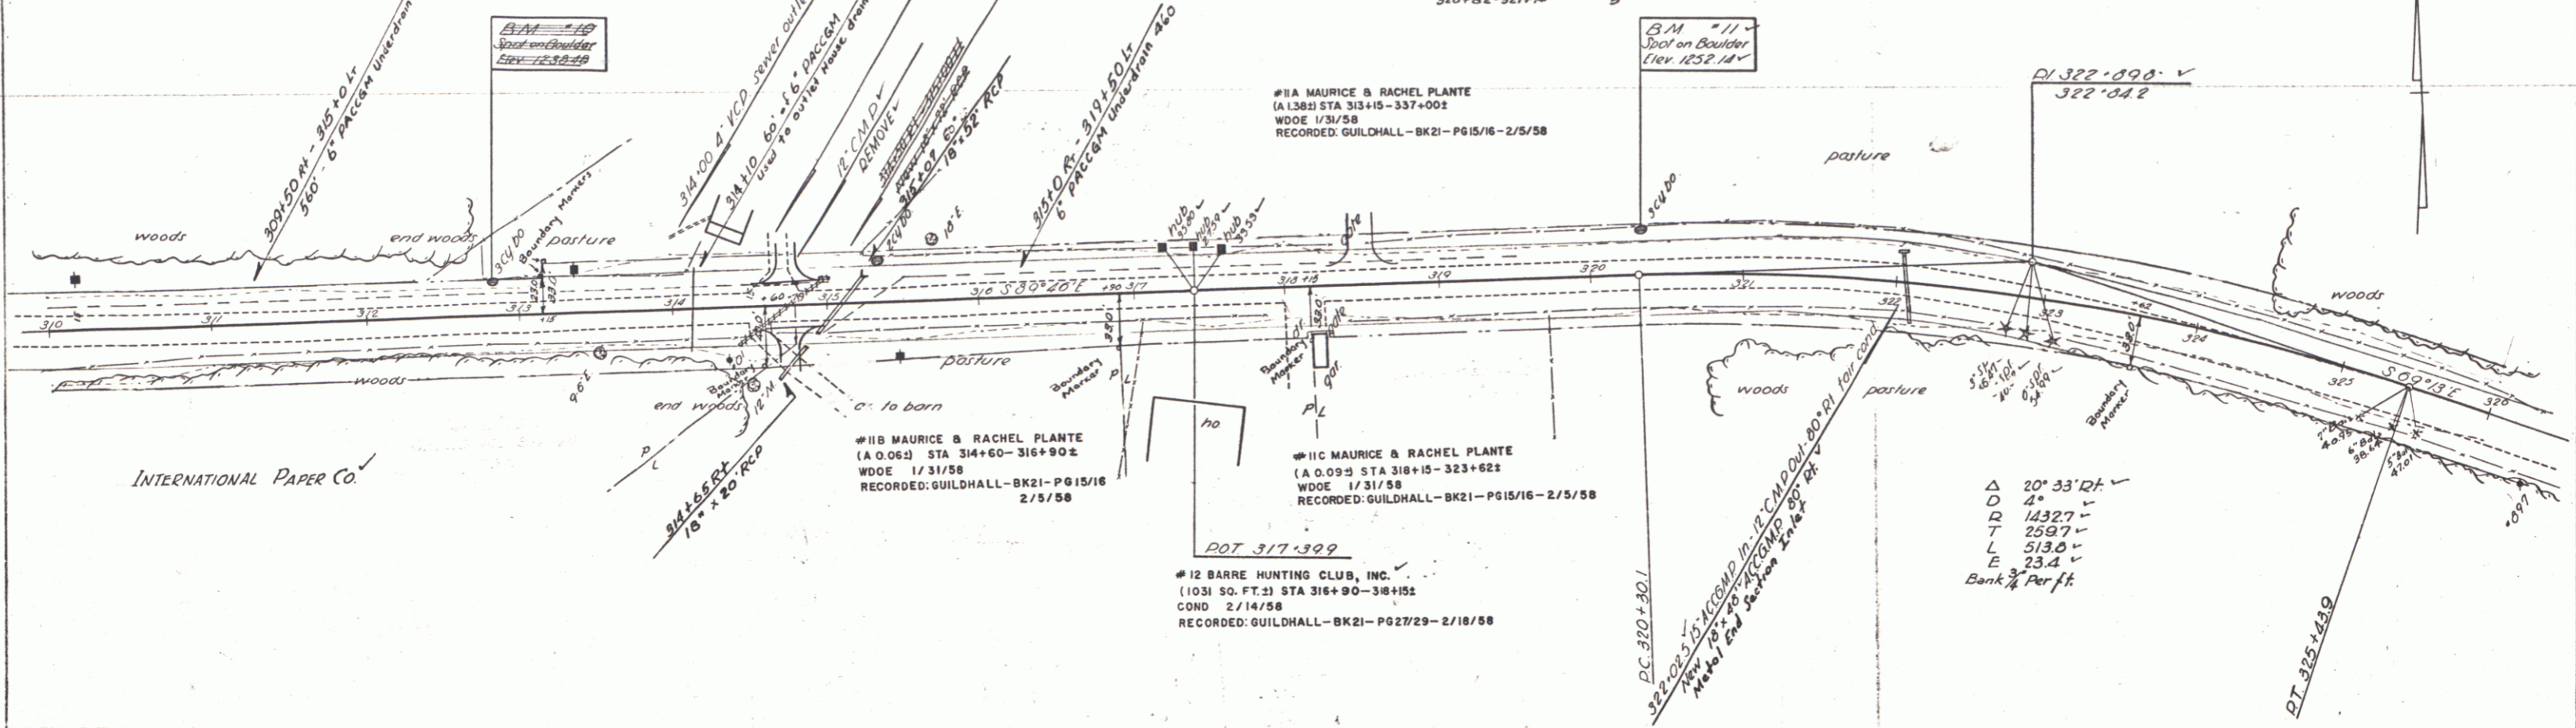

PLAN
DATE: 1/31/58
BY: [Signature]
CHECKED: [Signature]

Checked by [Signature]
DATE: 1/31/58
BY: [Signature]
CHECKED: [Signature]

PLATE 1 - [Signature]
DATE: 1/31/58
BY: [Signature]
CHECKED: [Signature]

BRIGHTON-FERDINAND
Proj. No. 132(7)
Sheet 16 of 23

14