

THREE CABLE GUARD RAIL WITH STEEL POSTS  
 353+52 Lt Rt  
 364+00-357+48 368' 368' 402'  
 357+0-358+30 130'



STEEL GUIDE POSTS  
 Lt Rt  
 346+08 1- 1-  
 354+00 353+50 1- 1-  
 354+71 357+10 1- 1-  
 343+23 1- 1-

CONSTRUCT DRIVE  
 Lt 346+50 Rt

EXCAVATION & REMOVAL OF SURFACE ON DISCONTINUED ROADWAYS  
 346+25-348+50 Rt

STATE-MERCHANTABLE PULP TIMBER CUT 4'0" - DRIVE  
 TIMBER SLED LENGTH, BOTH PROPERTY OF GRANTOR

PLAN  
 DATE BOOK  
 SHEET NO.  
 PROJECT NO.

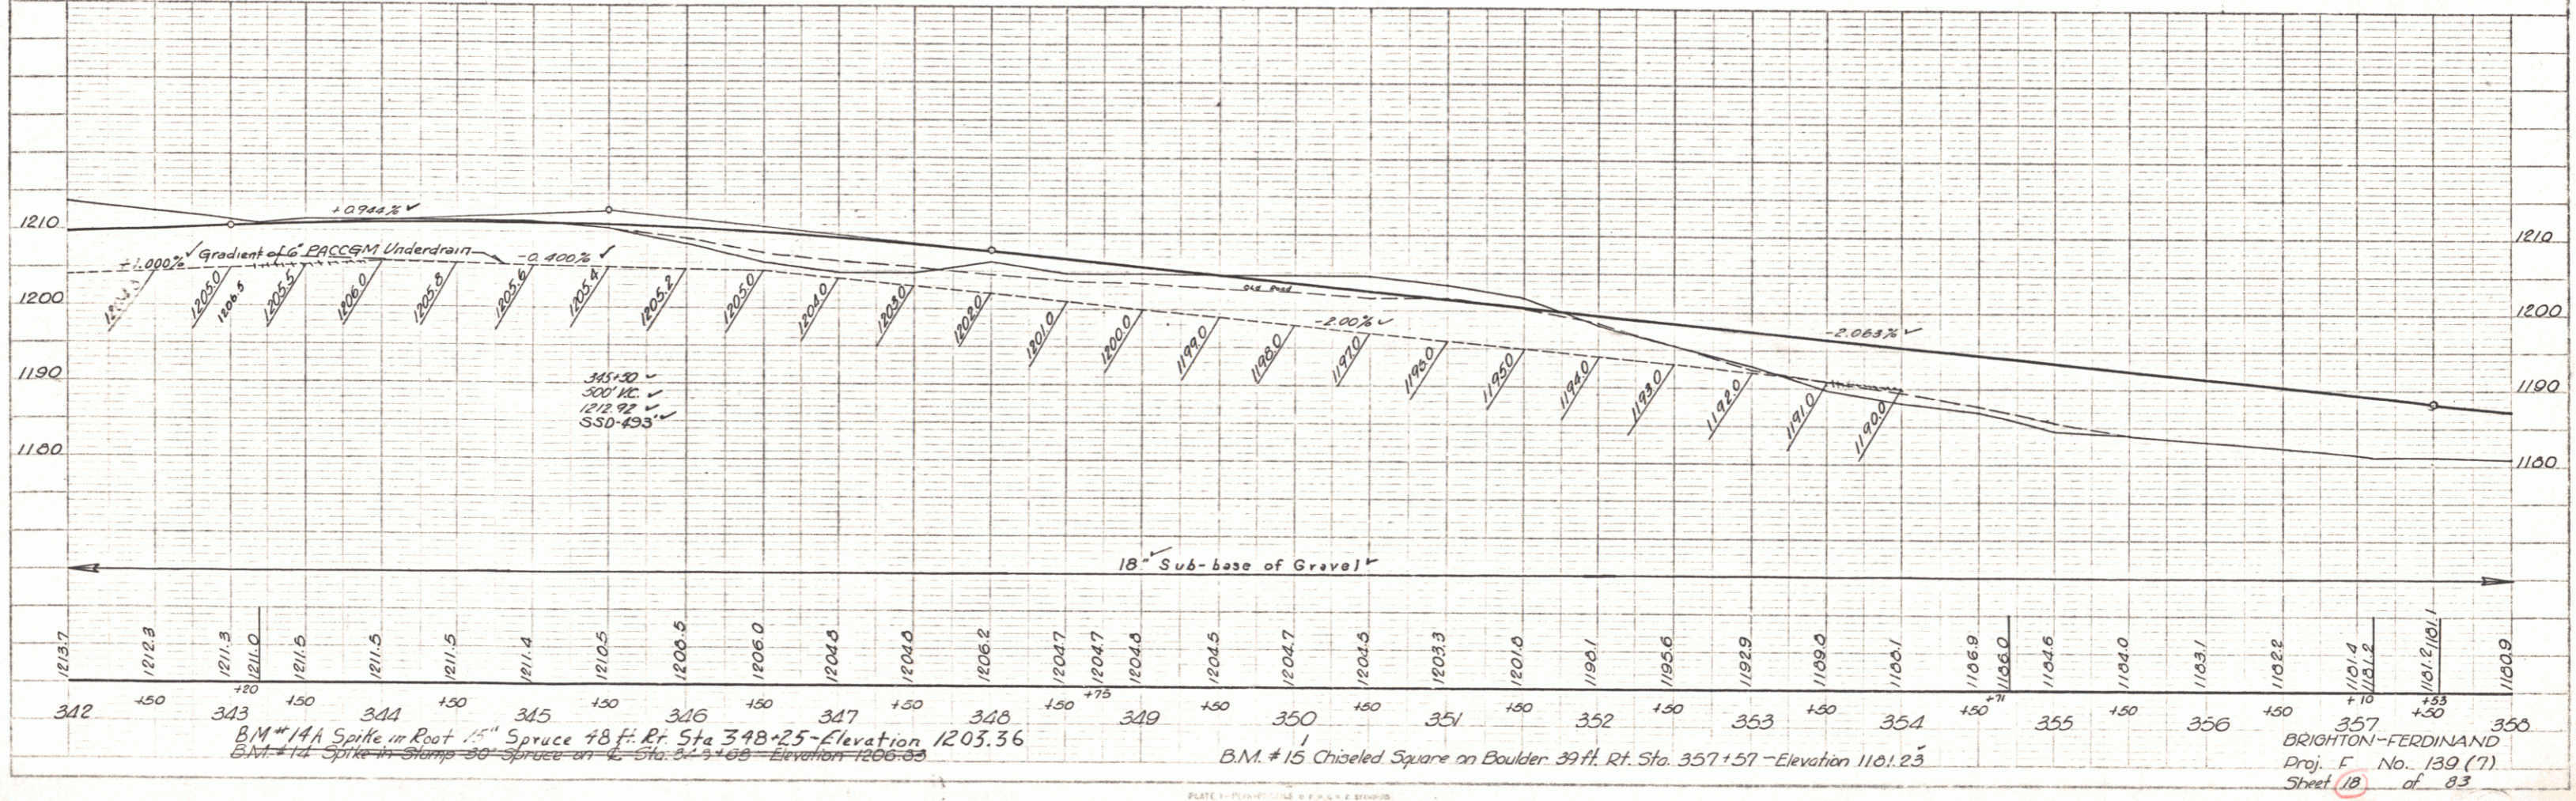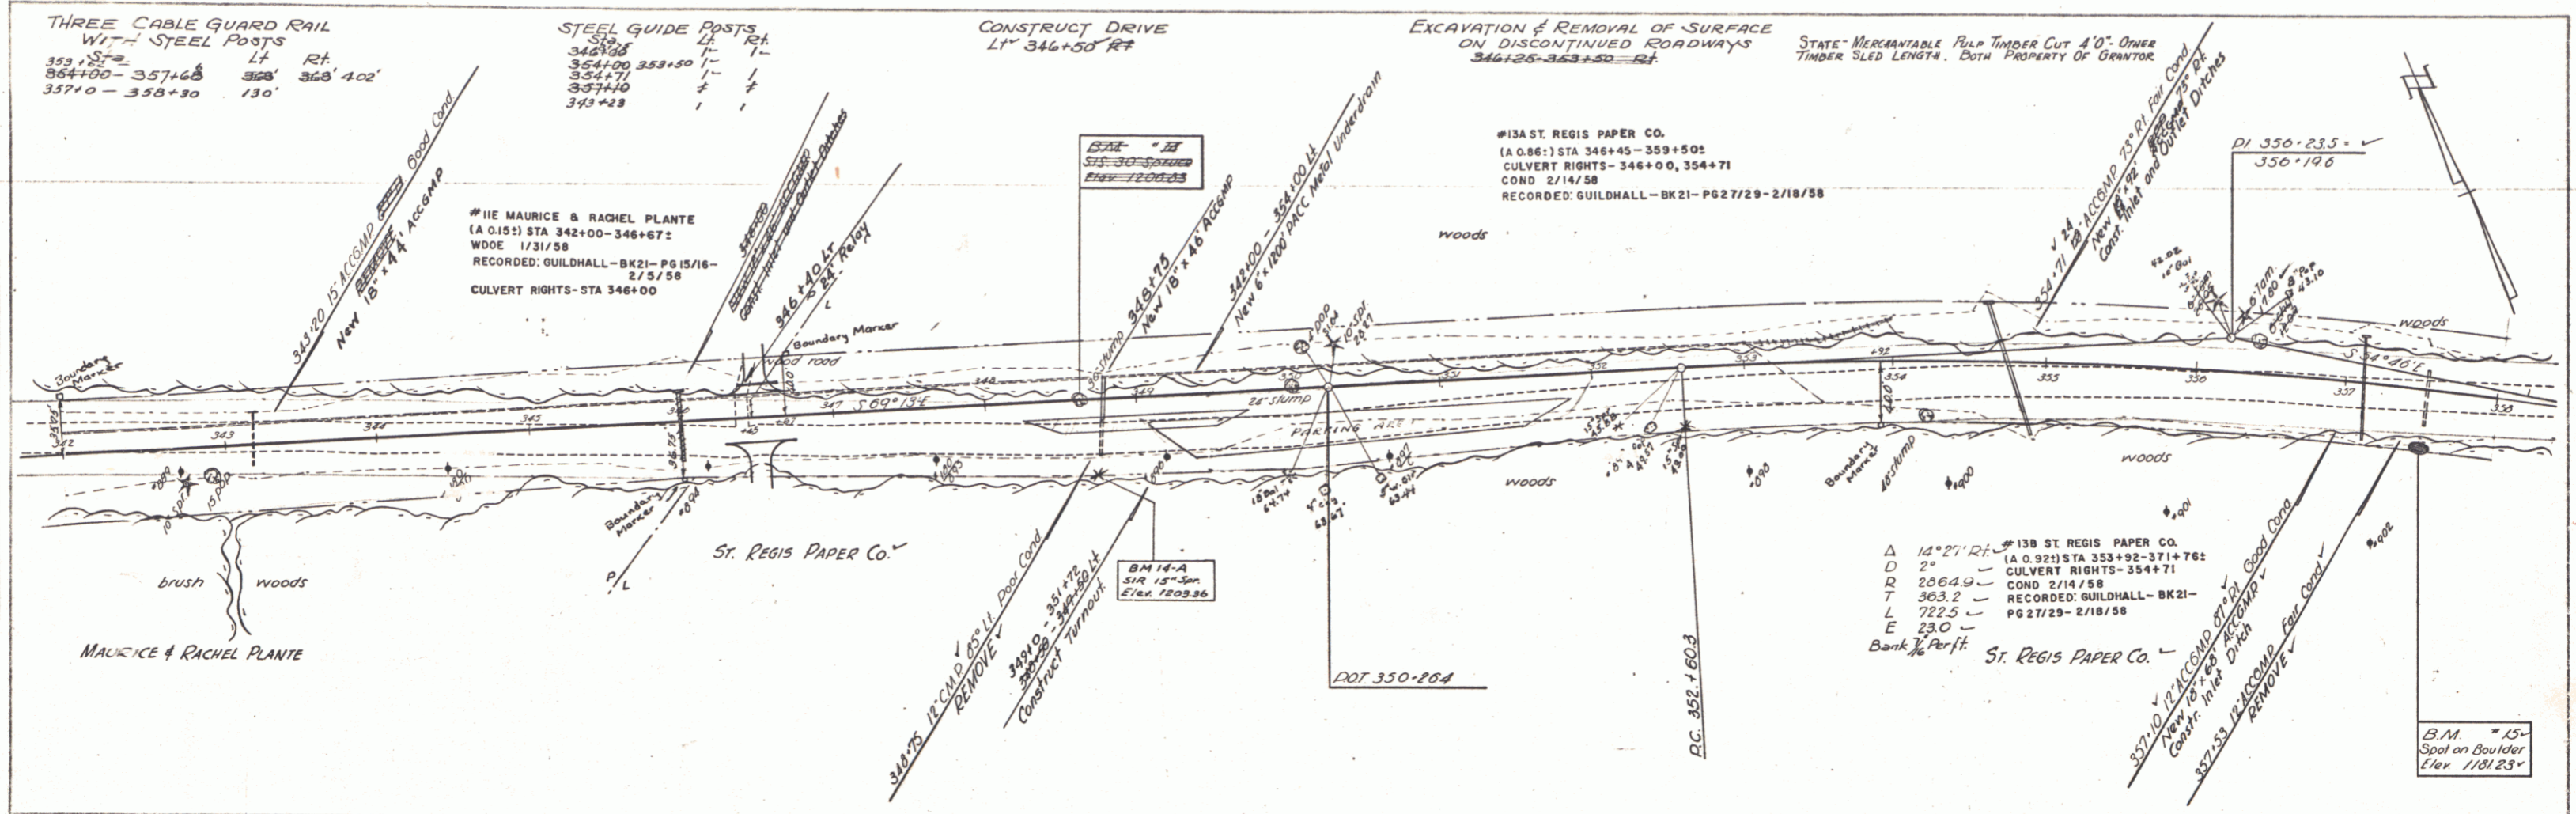

Vertical Curve  
 100' Length  
 1.000% Grade  
 0.400% Grade

PLATE 11 - PROFILE VIEW  
 BRIGHTON-FERDINAND  
 Proj. F. No. 139 (7)  
 Sheet 18 of 83