
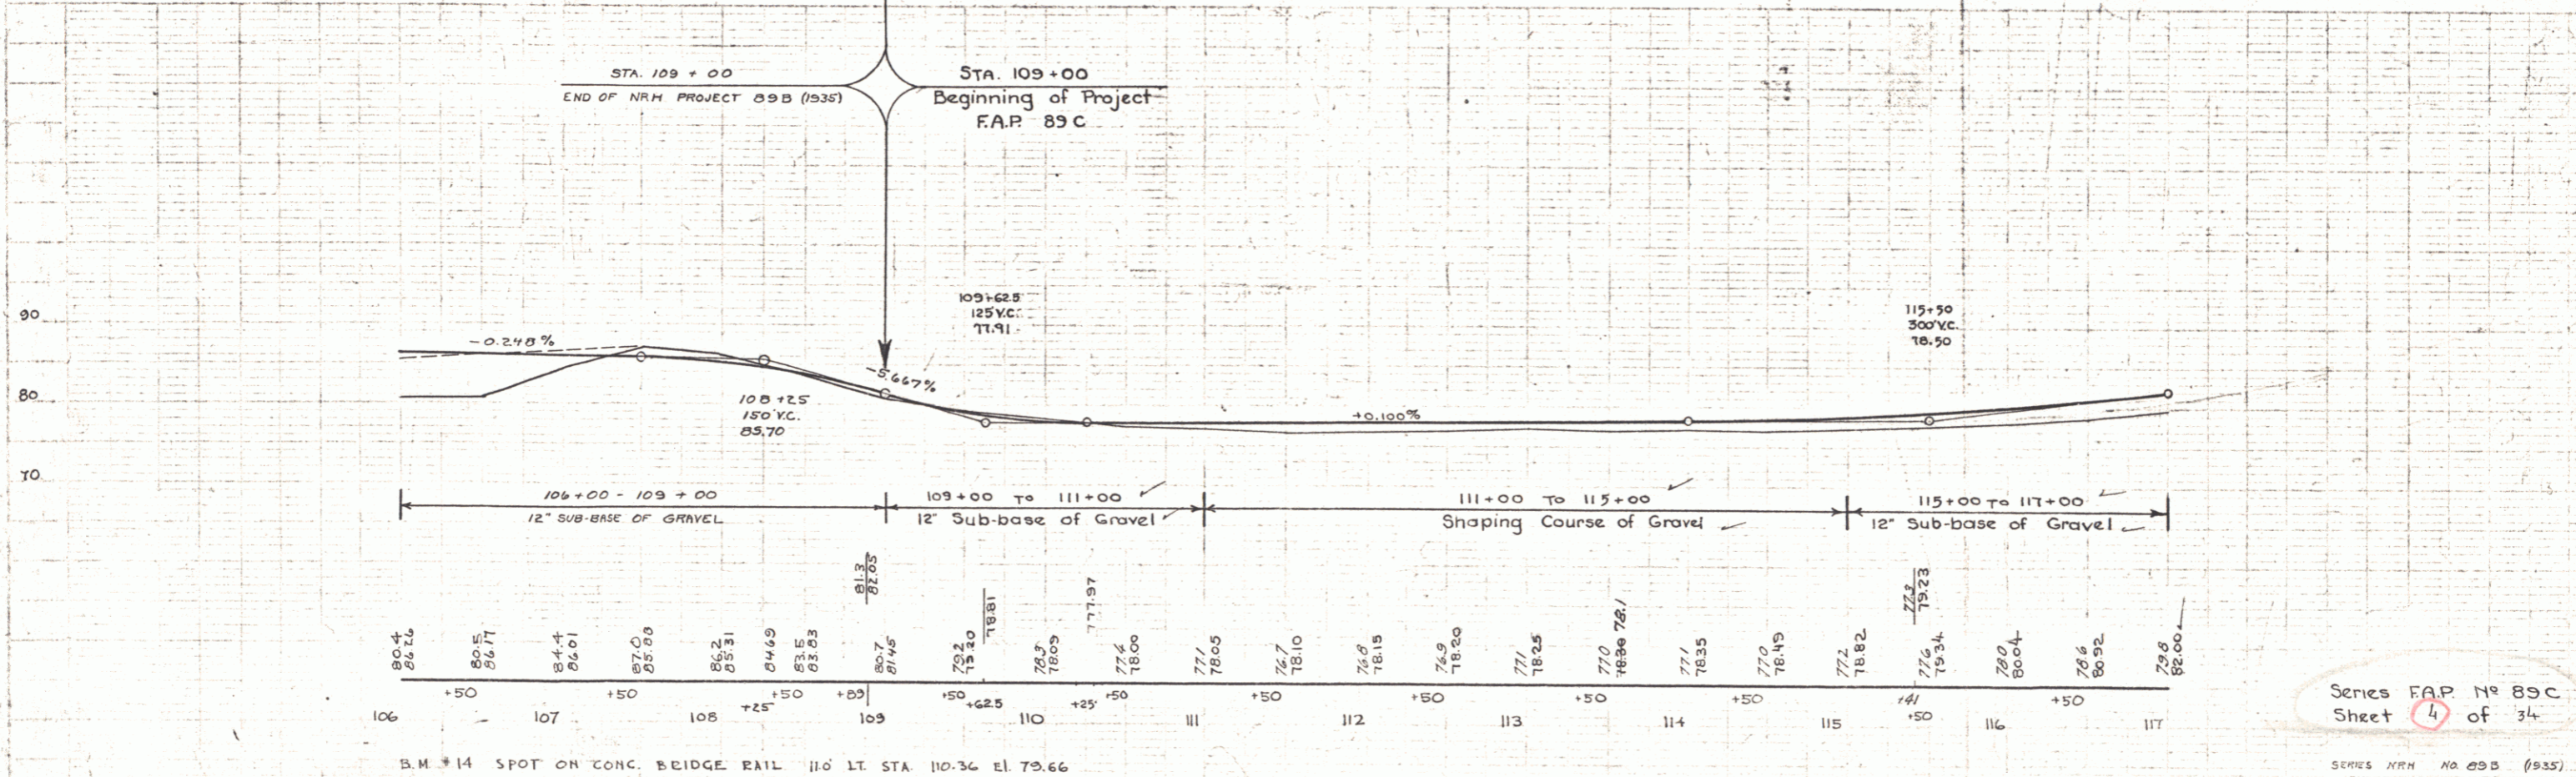


Parcel	Kind of Instrument	Date of Instrument	Grantor	Grantee	Recorded Description	Remarks
B	G.D.	11-21-34	FF Ufford	Stofvt	19 218 12-11-34	
C	W.D.	8-14-35	Wm Morris		19 288 8-14-35	

FED. ROAD DIST. NO.	STATE	FED. AID PROJ. NO.	FISCAL YEAR	SHEET NO.	TOTAL SHEETS
9	VT	NRH 89B	1934	10	36

FED. ROAD DIST. NO.	STATE	FED. AID PROJ. NO.	FISCAL YEAR	SHEET NO.	TOTAL SHEETS
				89C	1934 4

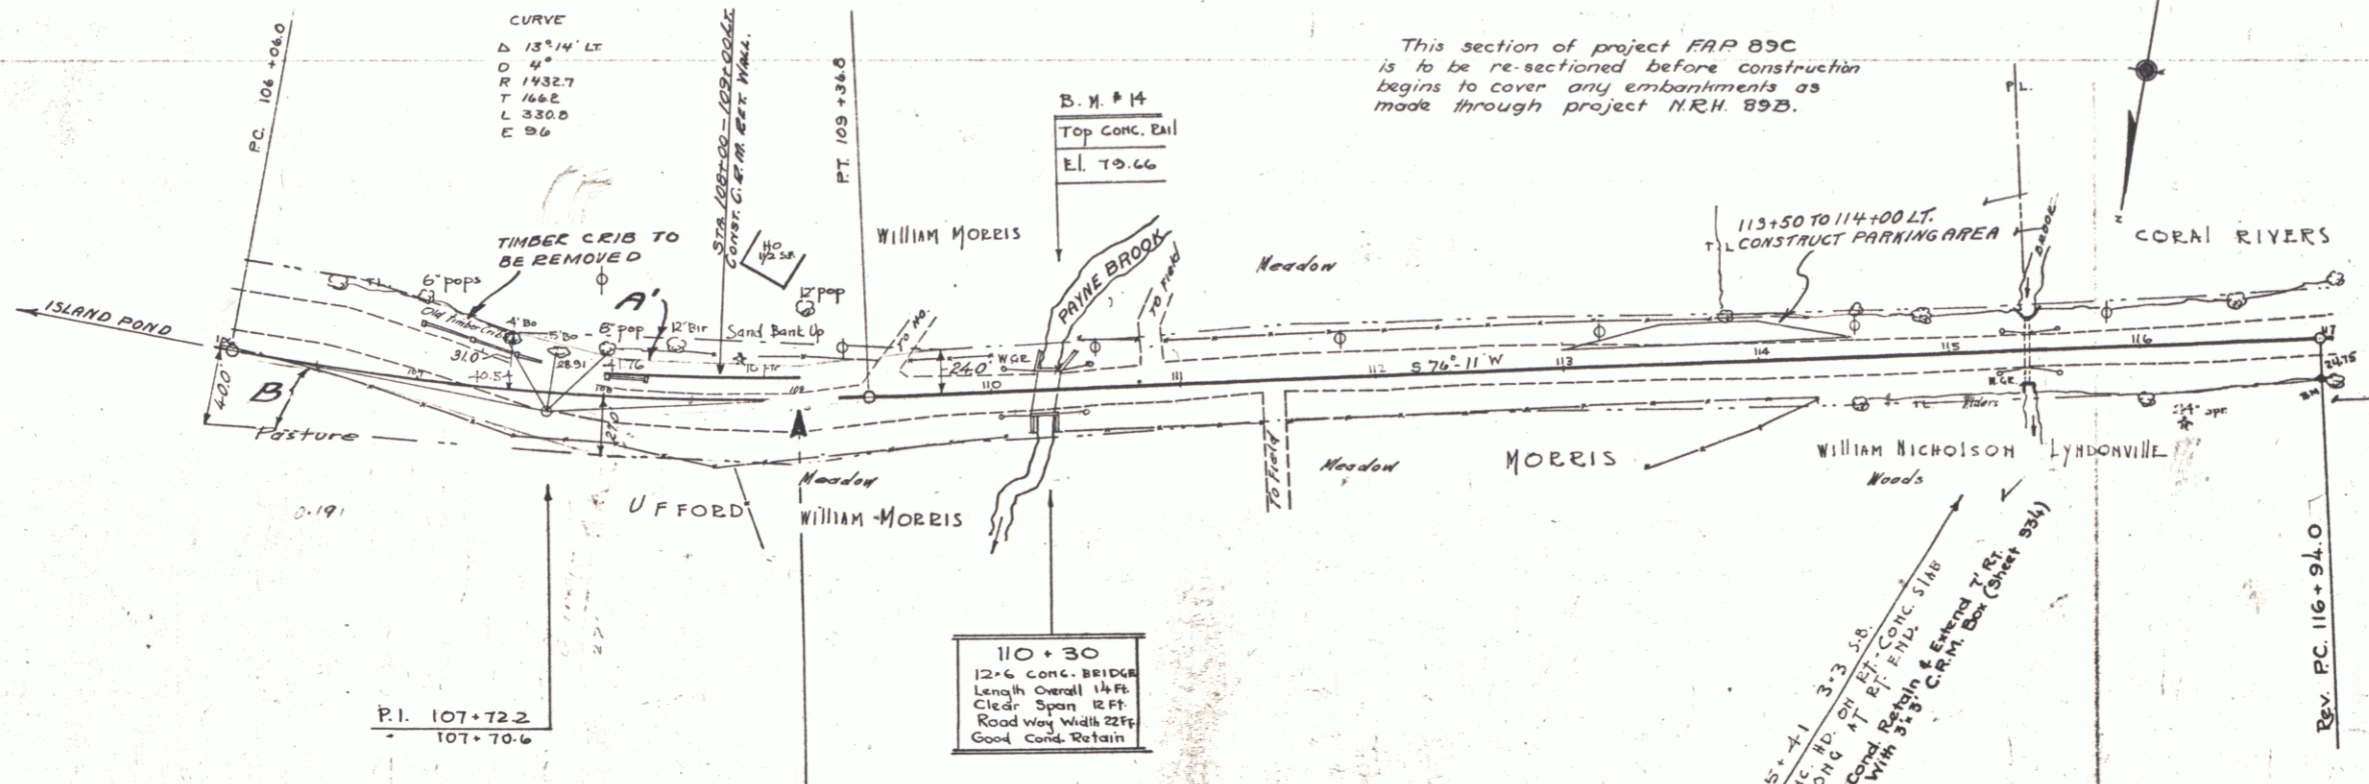

Series FAP No 89C
Sheet 4 of 34

SERIES NRH NO 89B (1935)
SHEET 10 OF 36