
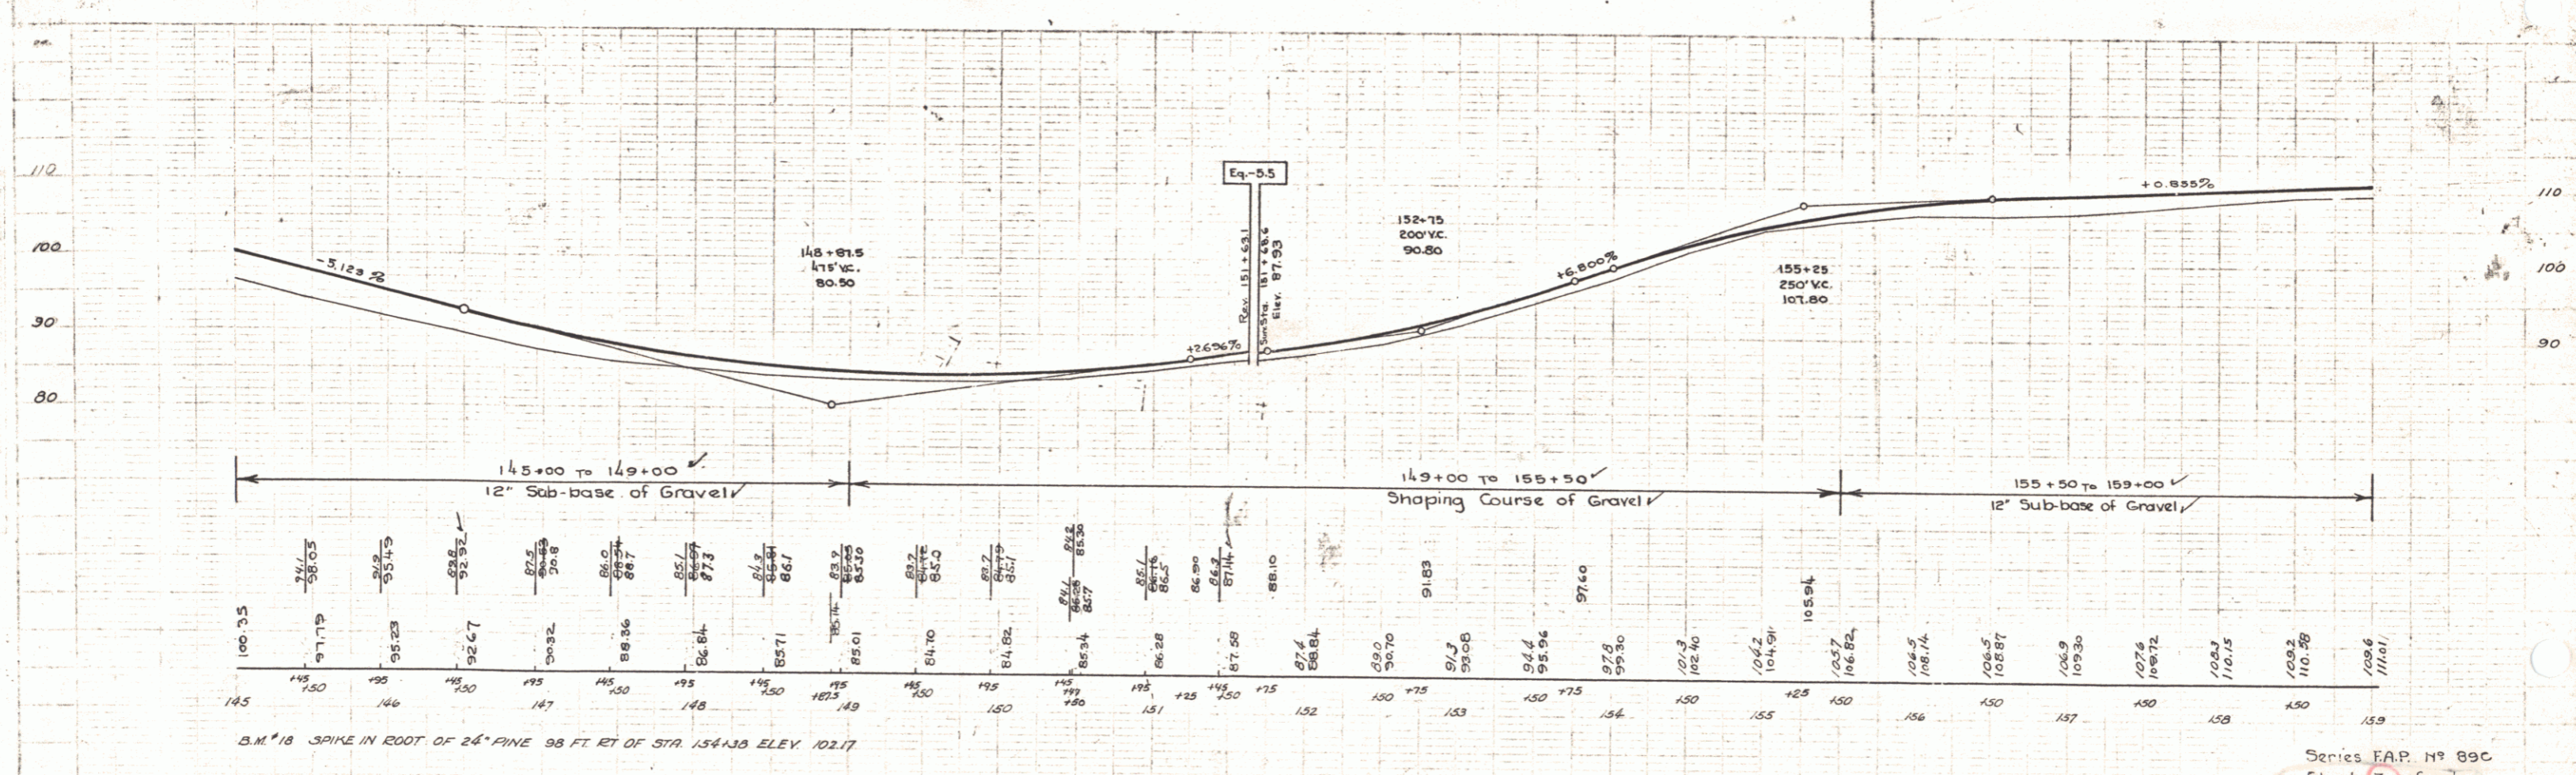


Parcel	Kind of Instrument	Date of Grant	Grantor	Grantee	Recorded Brighton	Remarks
C	N.D.	9-17-35	W.D. Allen	St. of Vt.	19 353-4	9-17-35
A.B.	"	9-17-35	B.M. Farmer	"	19 359-10	9-17-35

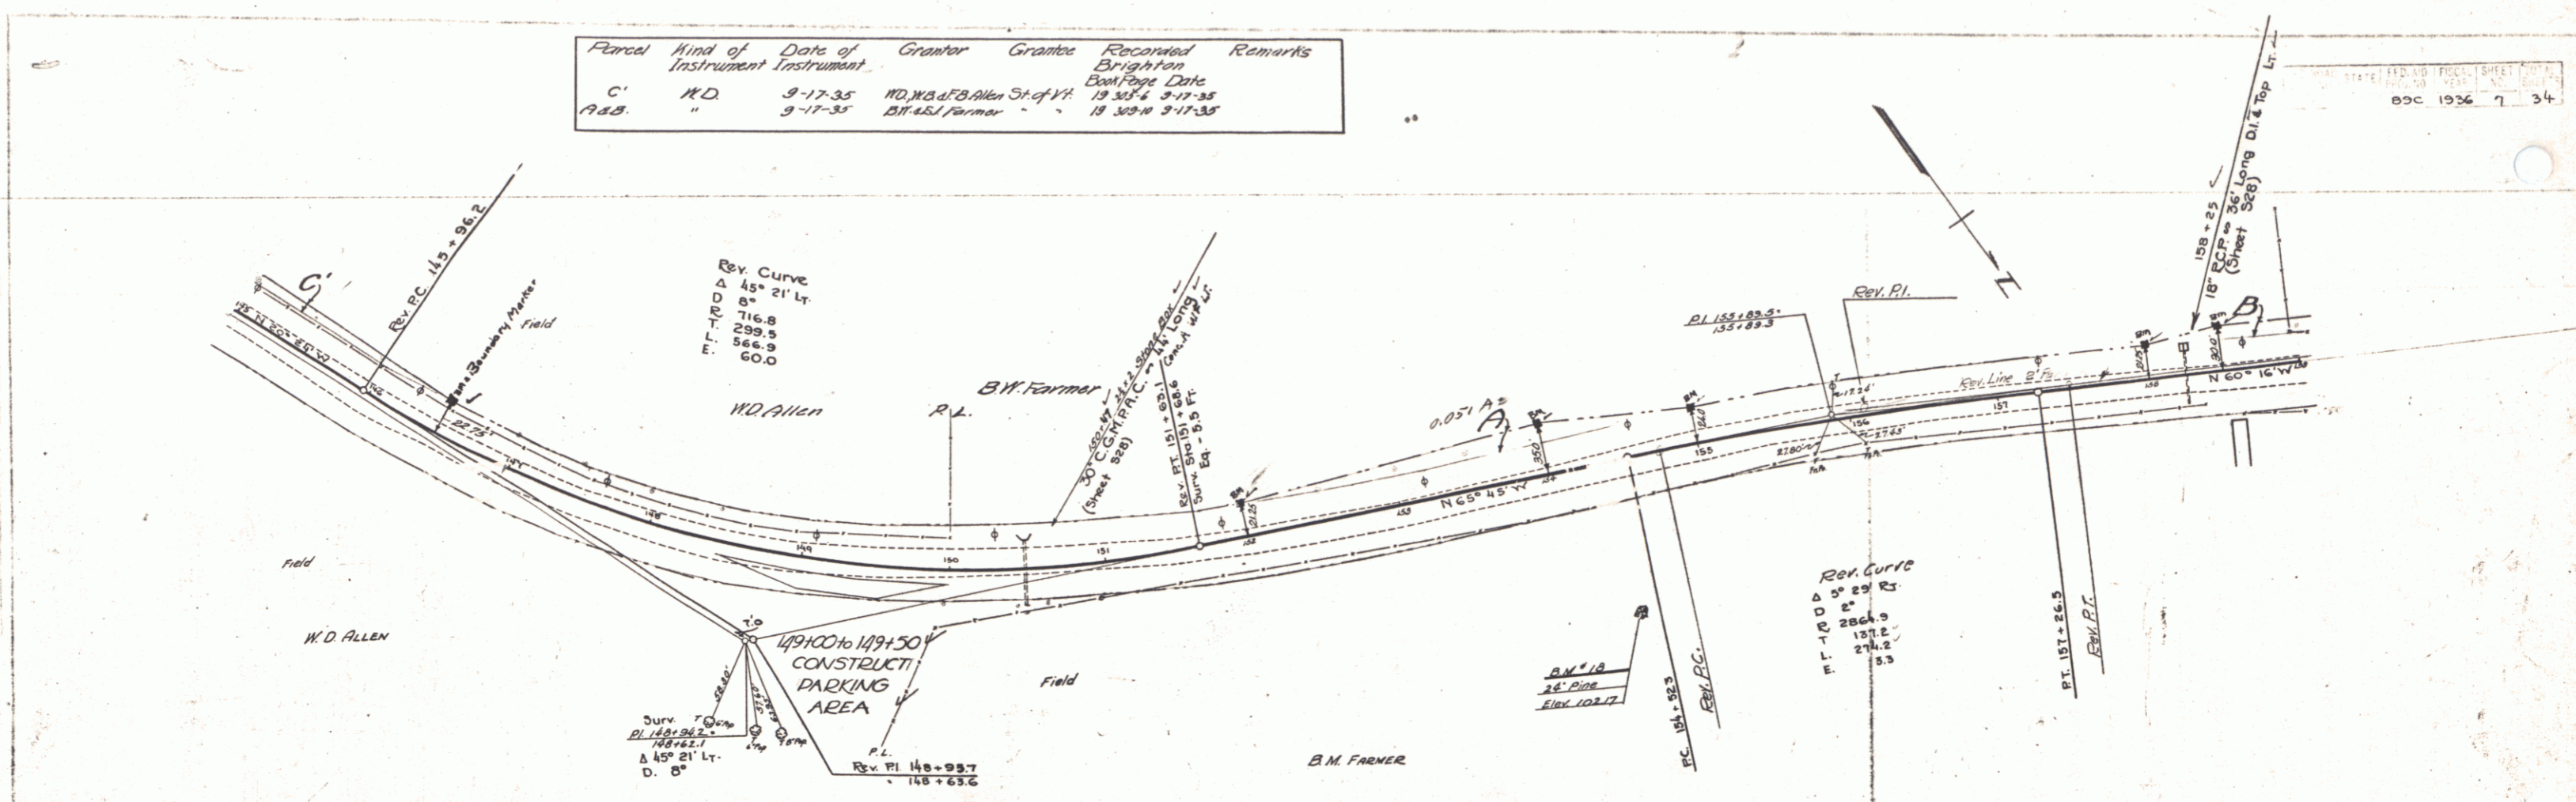

Scale
1" = 100'
1" = 10'

Scale
1" = 100'
1" = 10'

5