
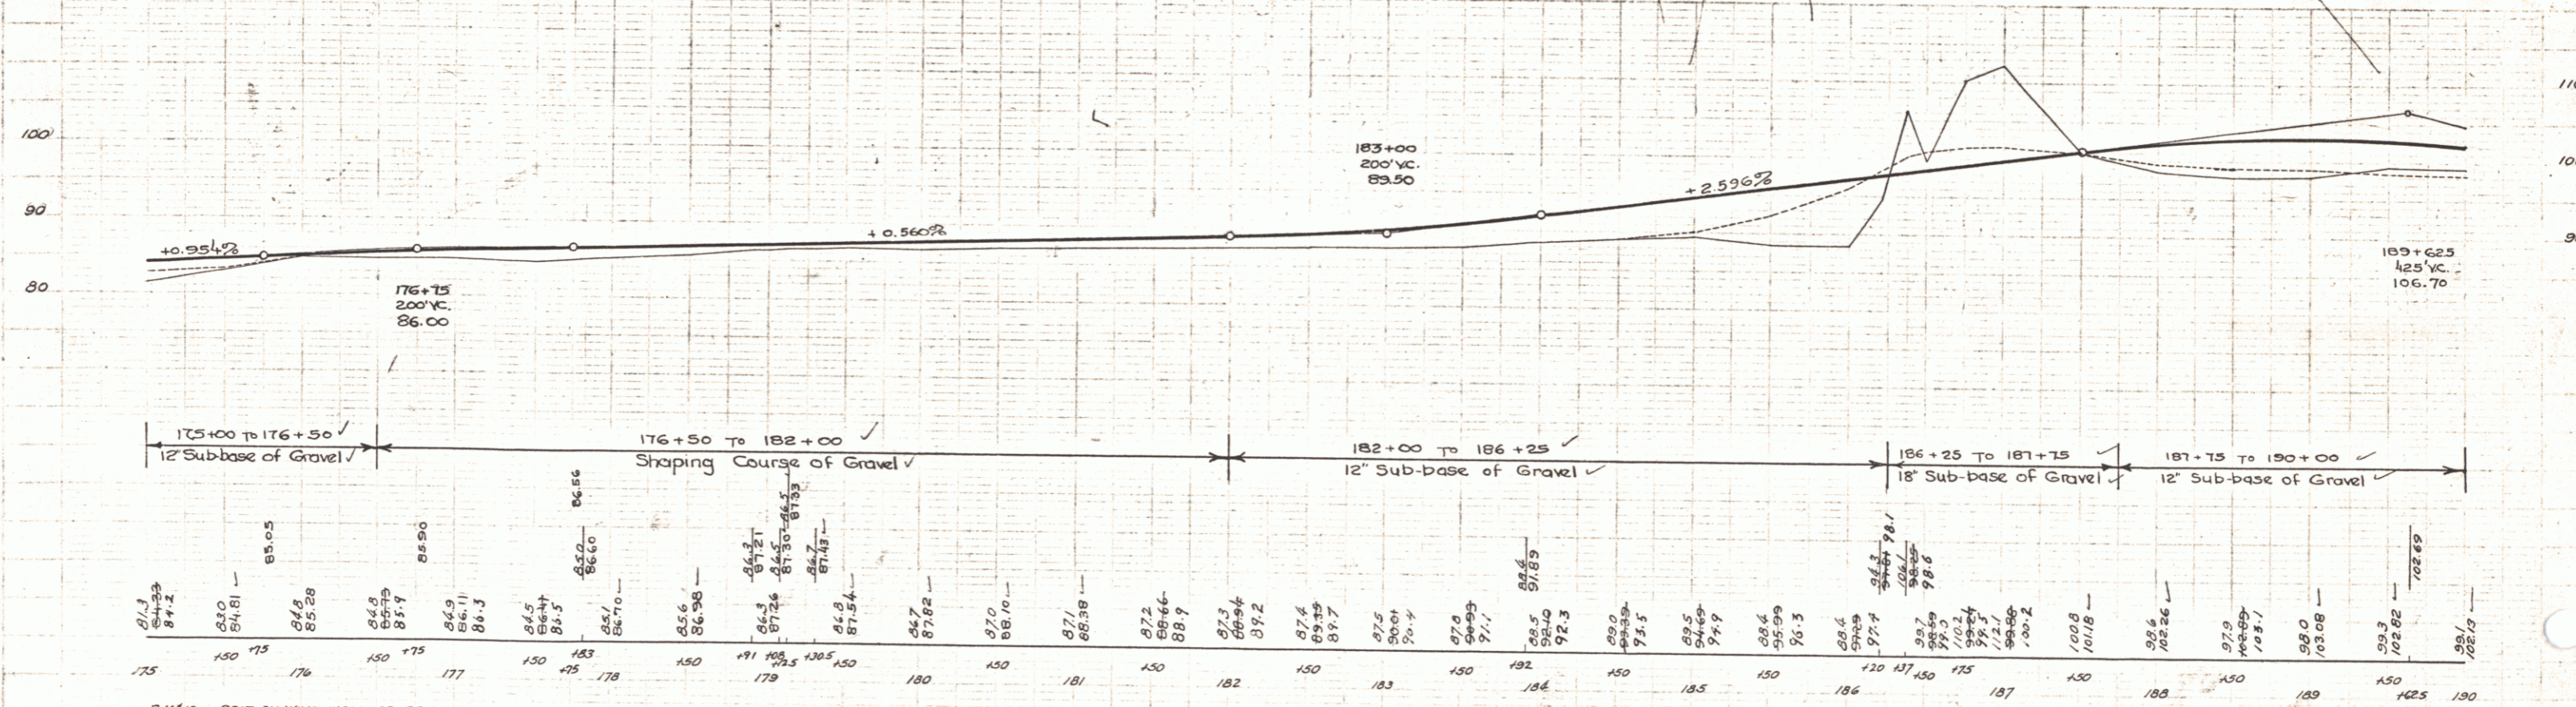


Parcel	Kind of Instrument	Date of Instrument	Grantor	Grantee	Recorded	Remarks
A, B, C, D	W.D.	9-27-35	Moses & Payne	Shoff	19 314 9 27 35	
		9-17-35	H. & M. Coe		19 317 9 17 35	

STATE ROAD FIELD NO. 1000 SHEET NO. 9
 89C 1936 9 34

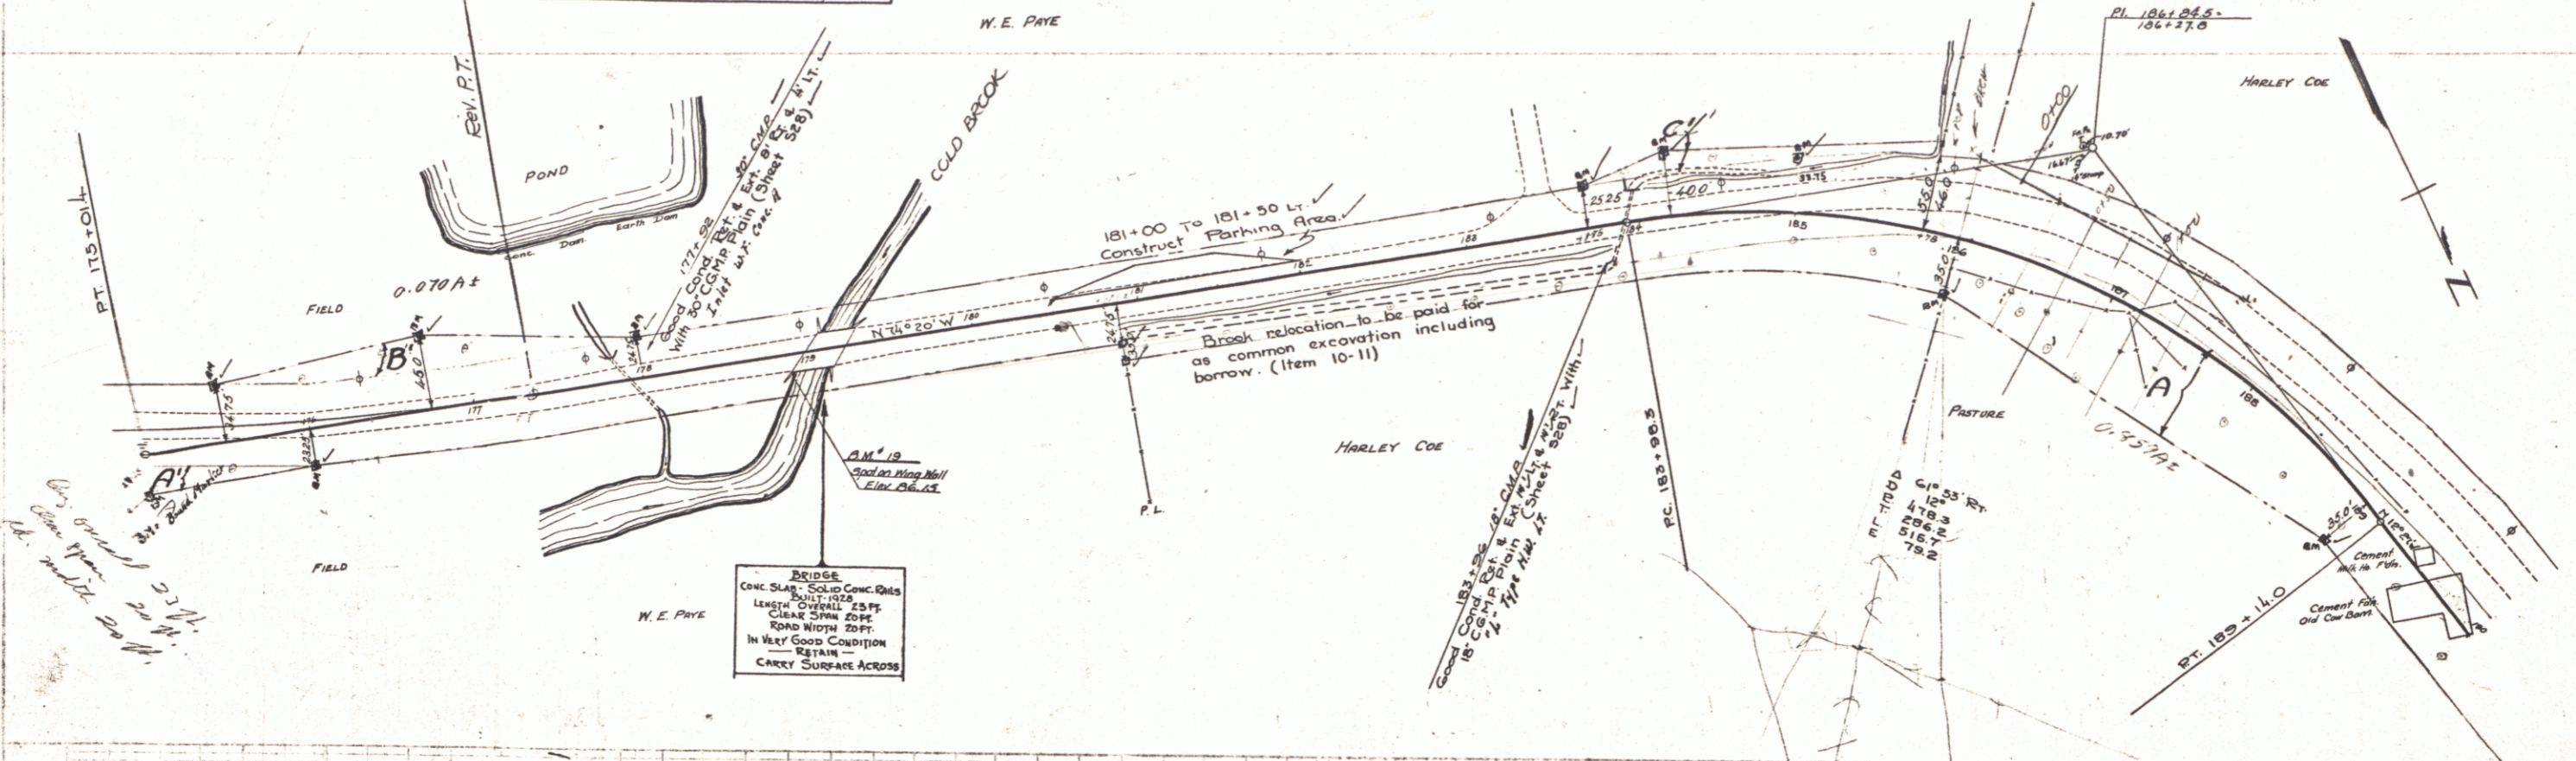

B.M. 19 SPOT ON WING WALL OF BRIDGE 11 FT. RT. STA. 175+89 ELEV. 86.15