
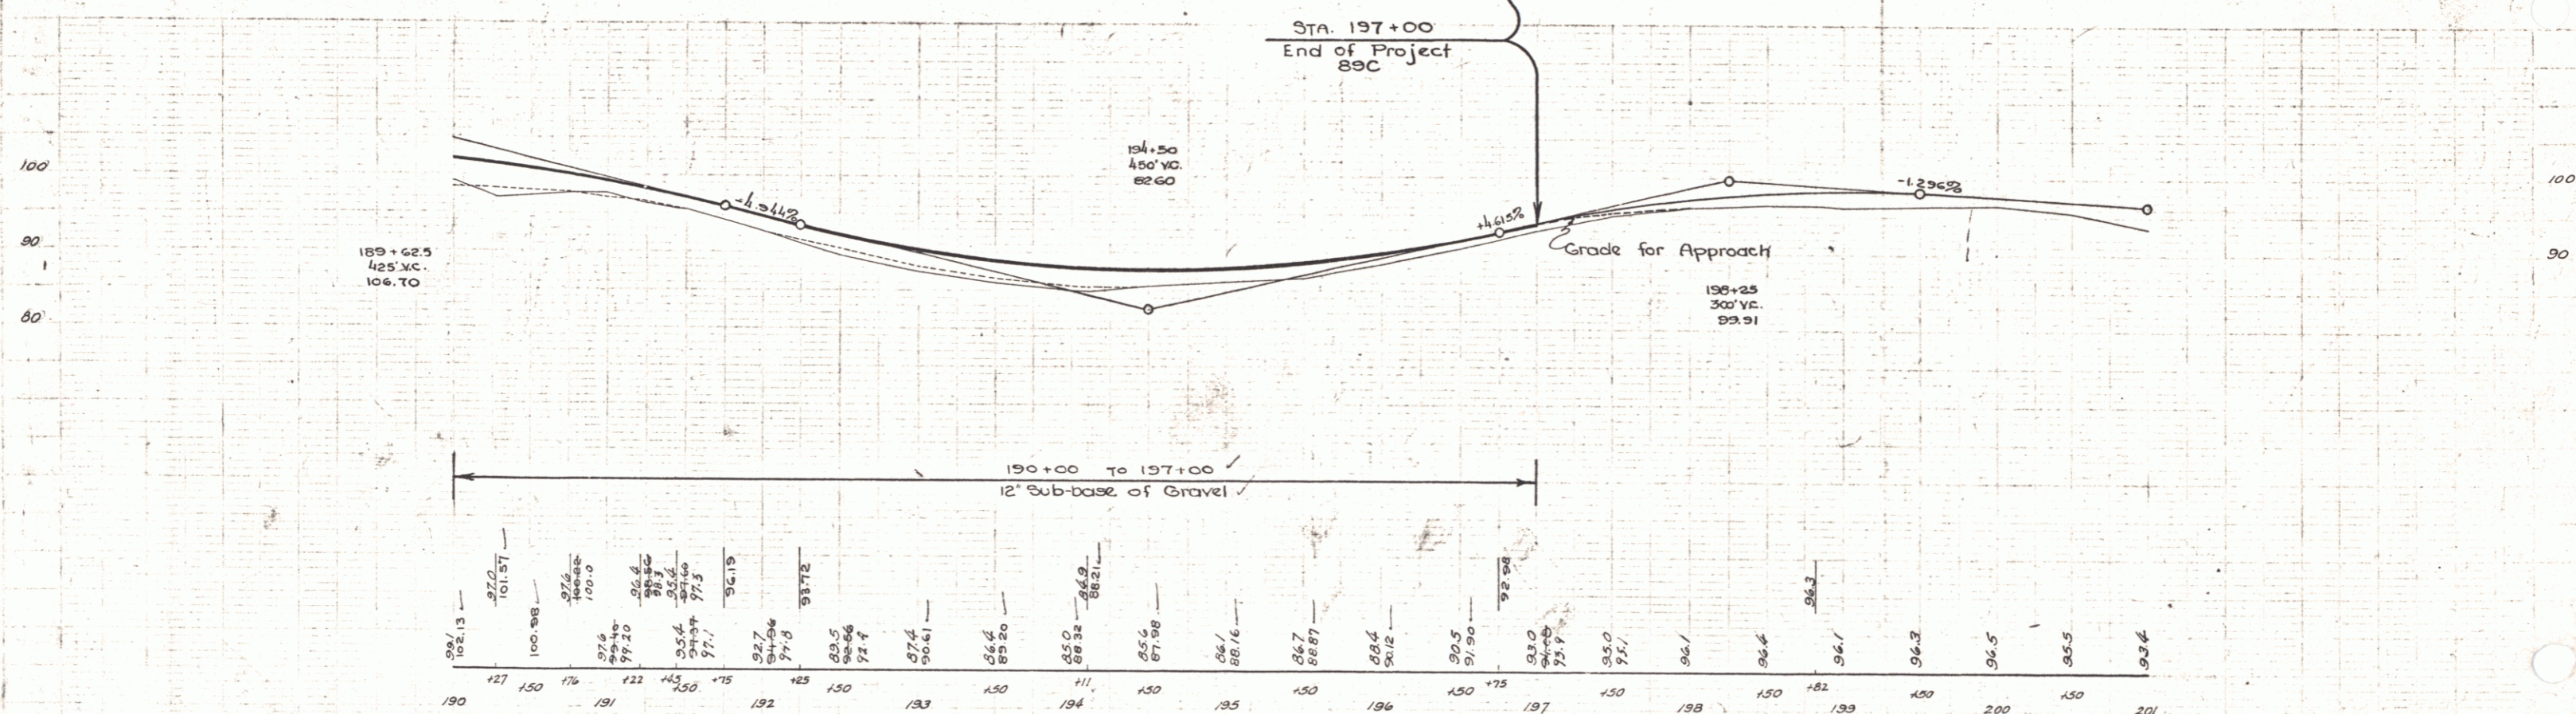


Parcel	Kind of Instrument	Date of Instrument	Grantor	Grantee	Recorded	Remarks
A & B	WD	9-17-35	HE & WD COE	Staph. H. H. 19 307-4 3-17-35		

DATE	YEAR	SHEET NO.	TOTAL SHEETS
1936	10	34	

A 40° 25' Lt
D 4° 20'
E 1279.6
T 170.4
L 201.1
E 84.1

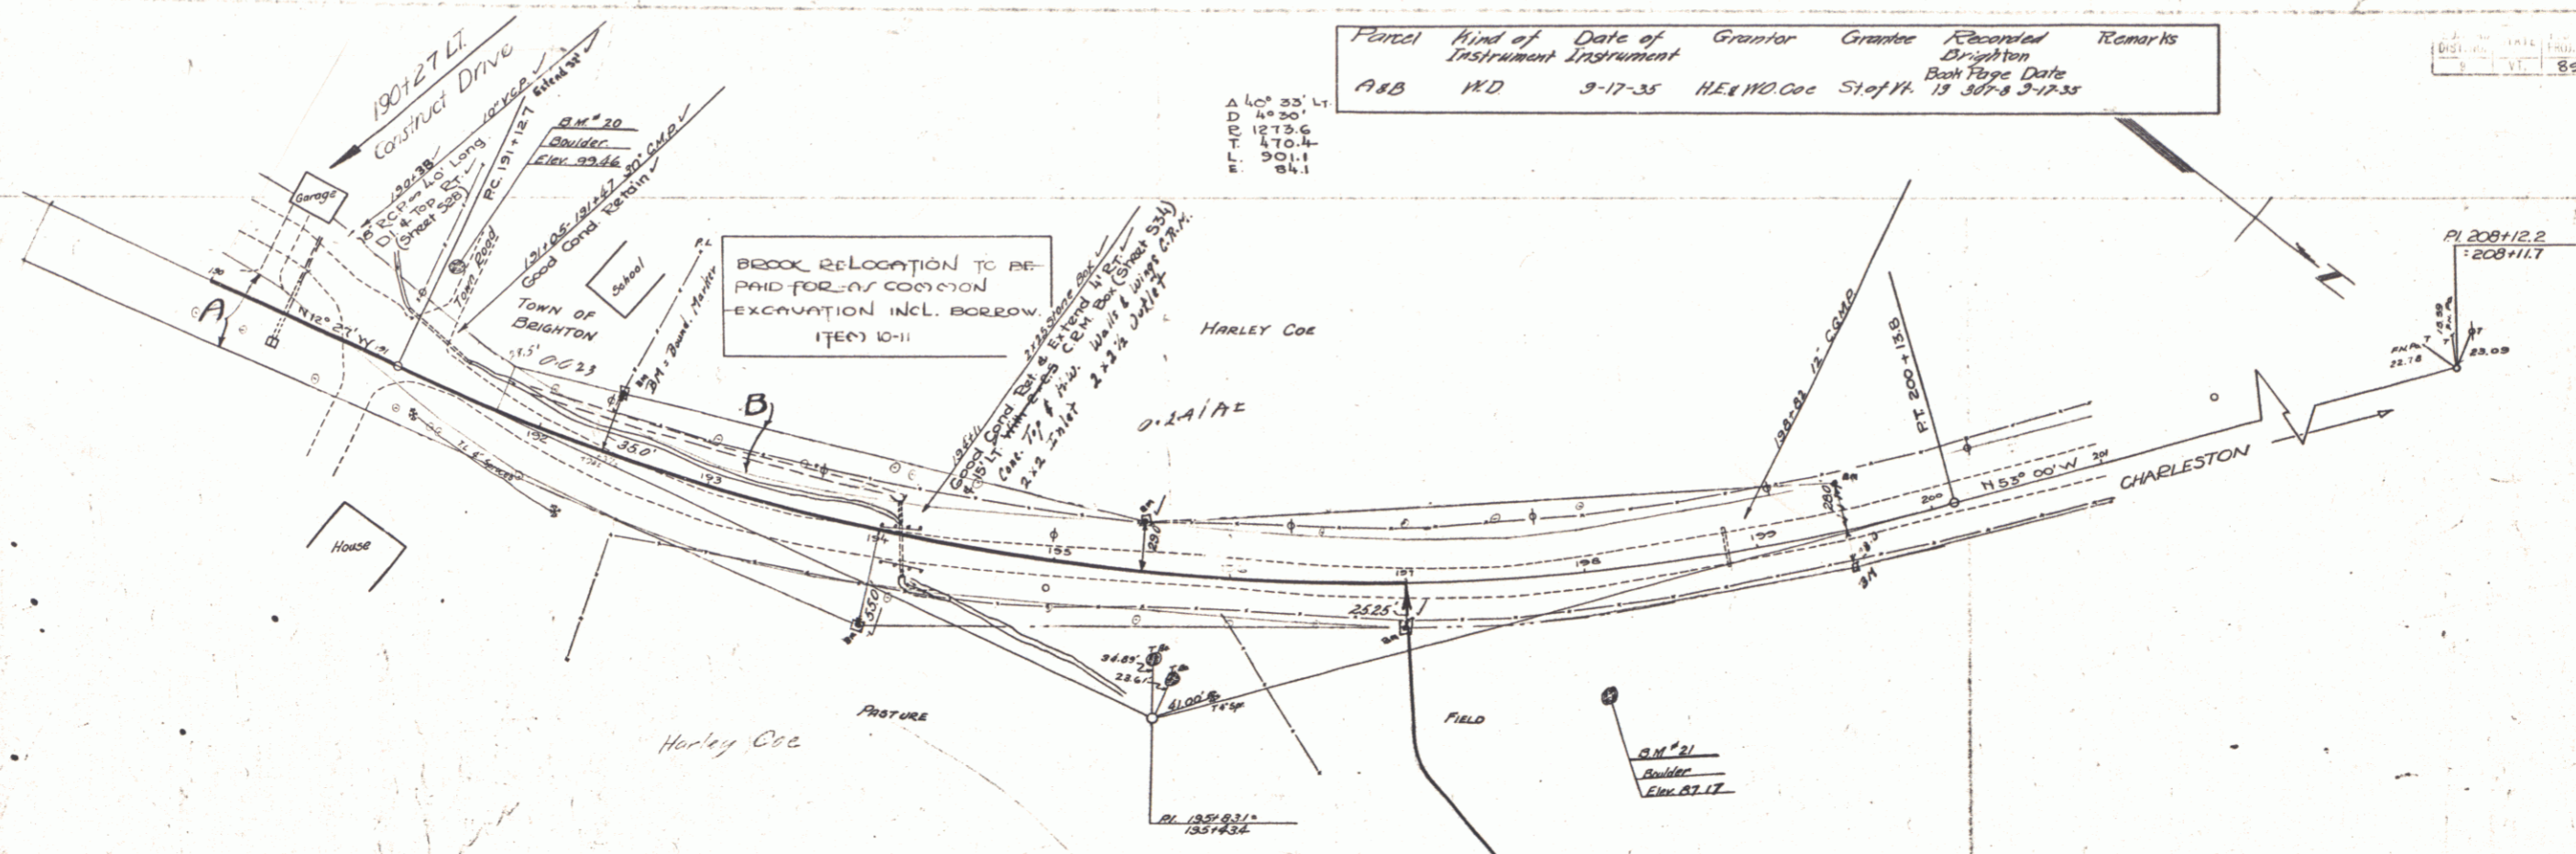

B.M. 20 SPOT ON BOULDER 67 FT LT. STA 191+18 ELEV 93.46
B.M. 21 72 FT LT. STA 198+06 ELEV 87.17

Series F.A.P. No 89C
Sheet 10 of 34

B. A.