
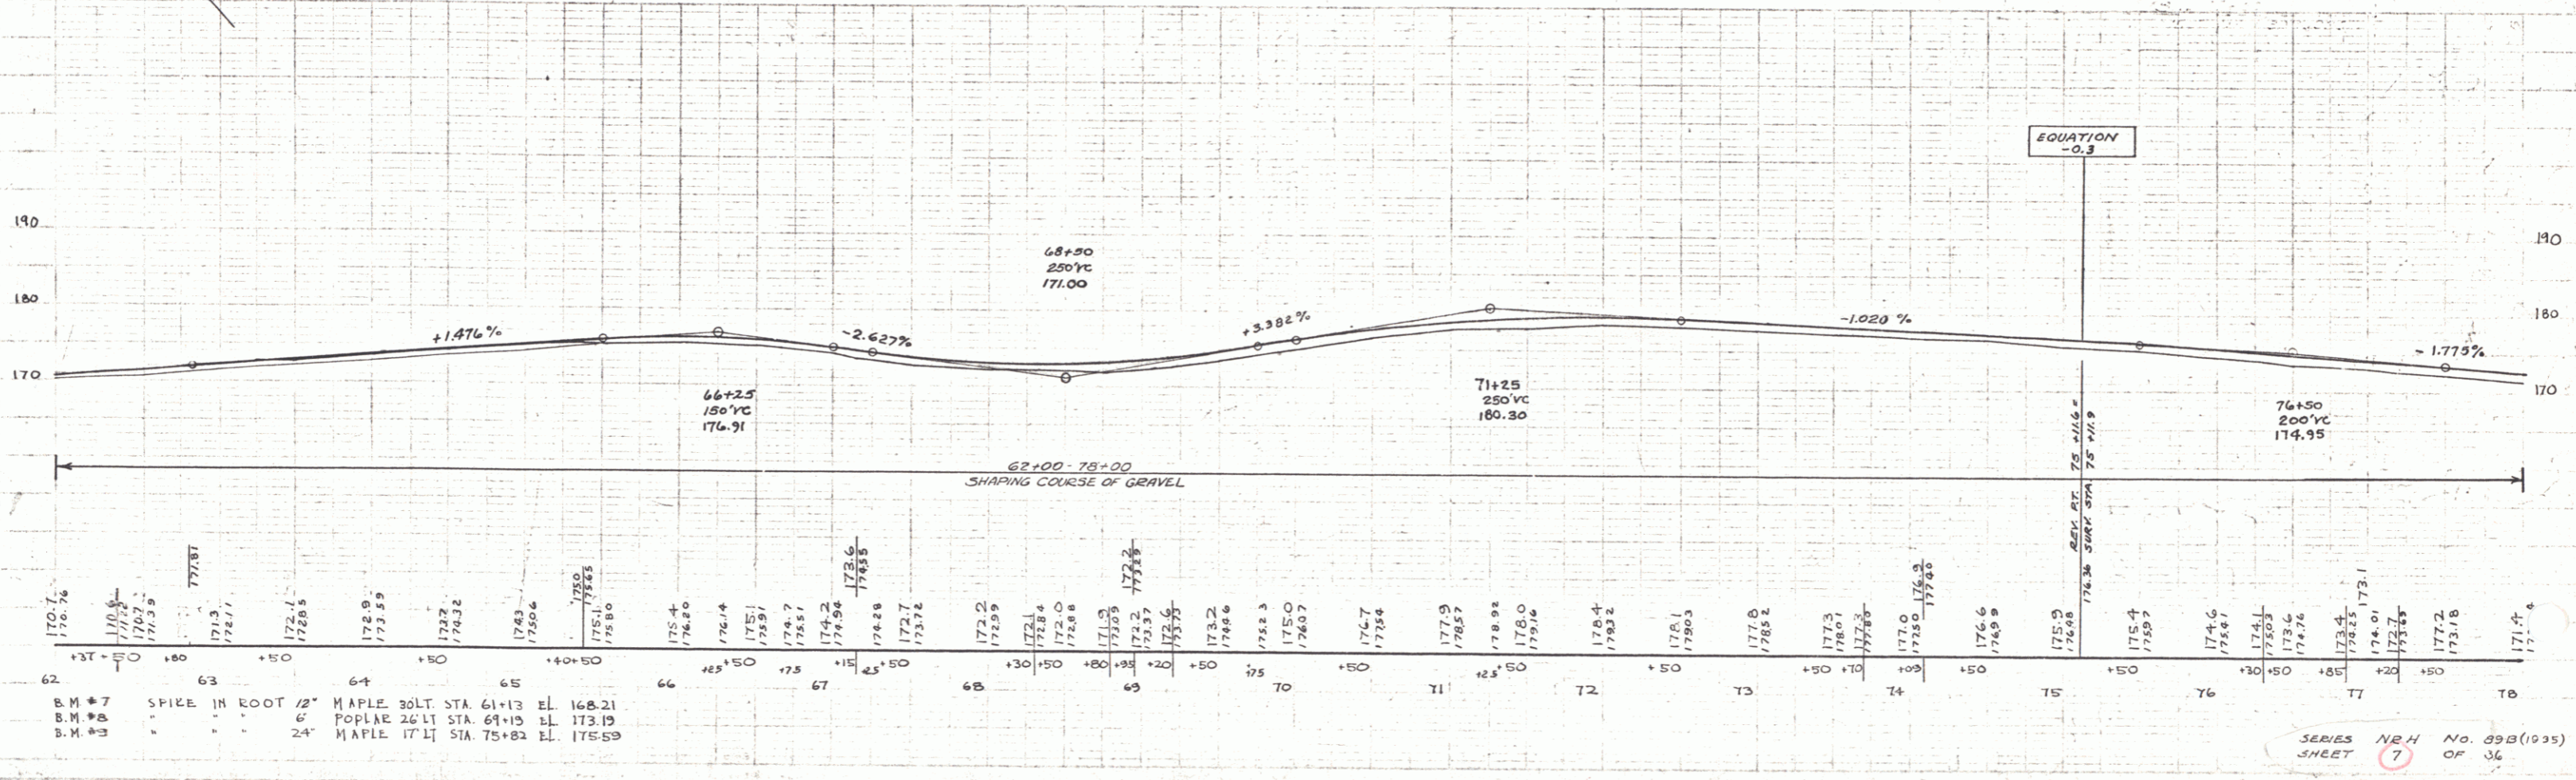


PUTNAM
B. MACCHI
7/34
D. MACCHI

PUTNAM
B. MACCHI
7/34

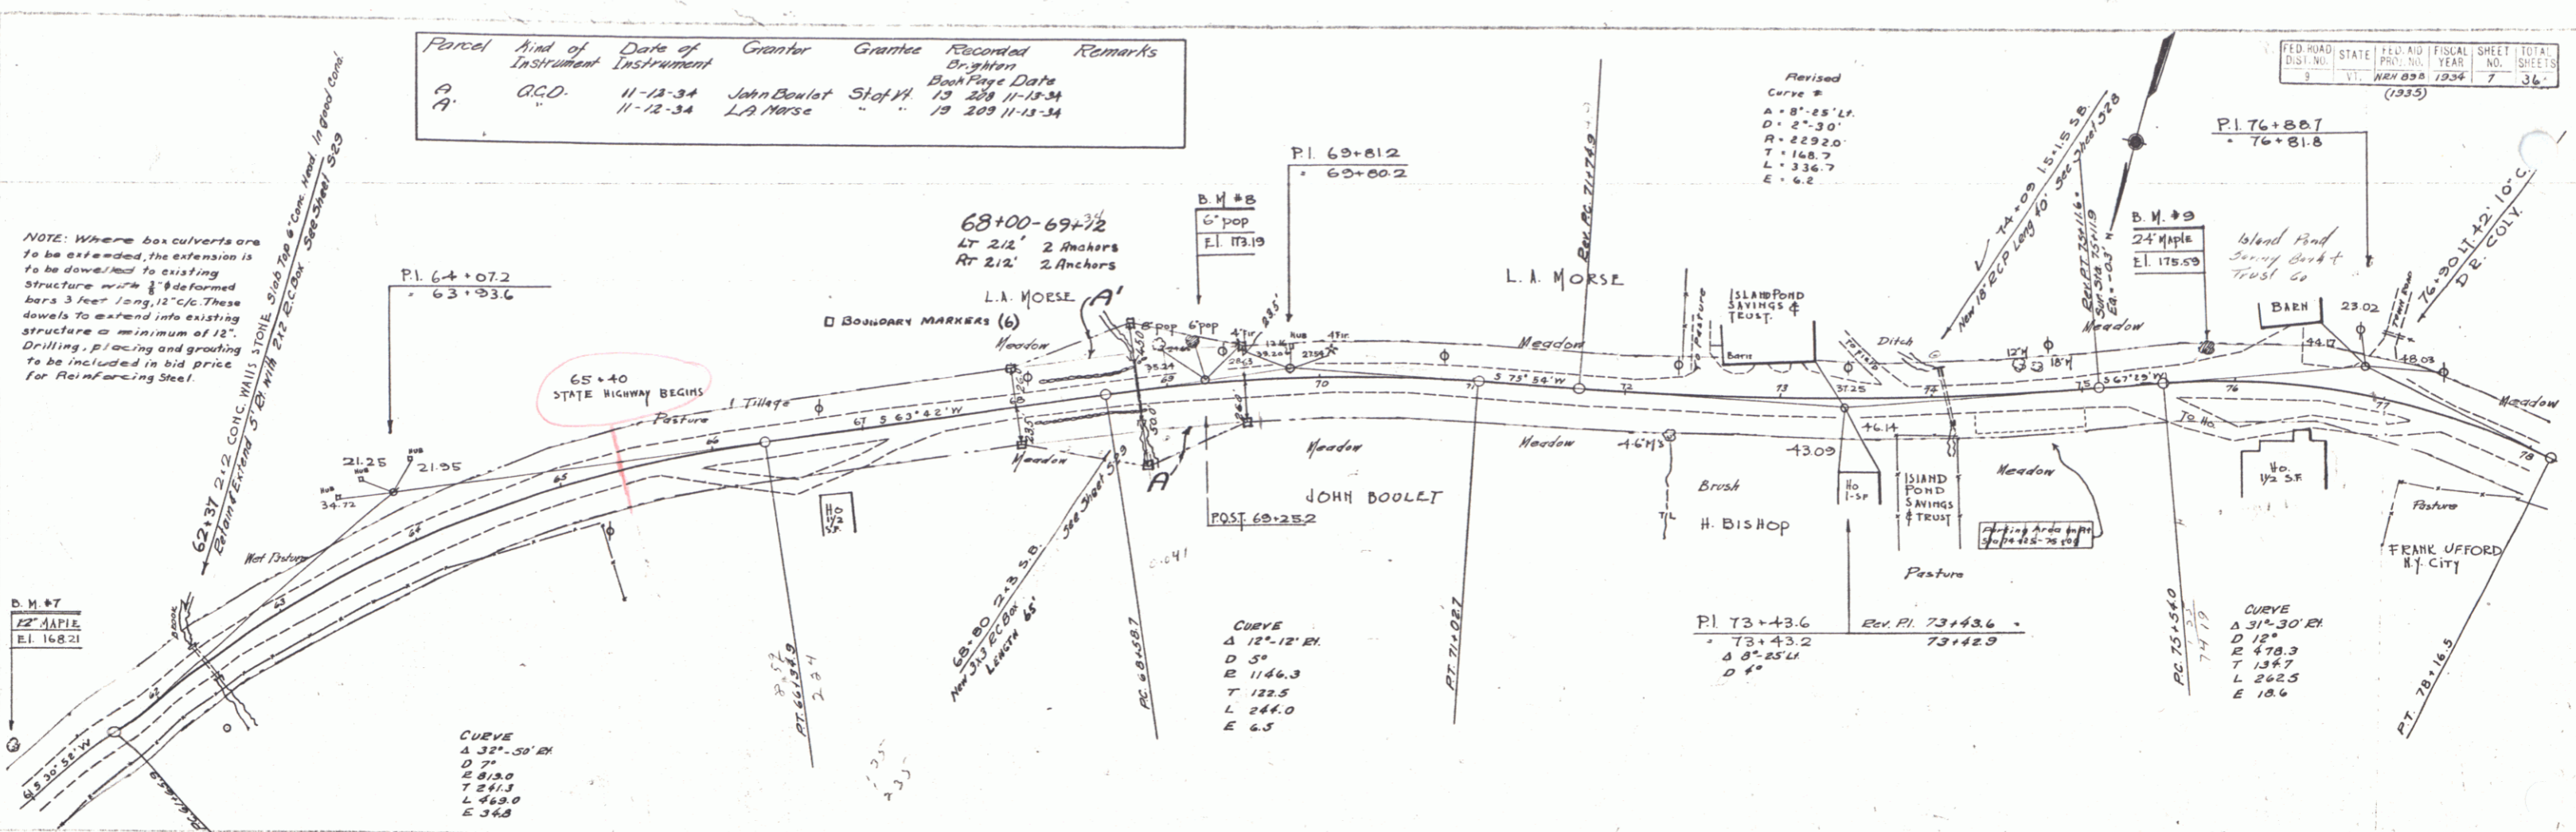

SERIES NEH No. 89B (1035)
SHEET 7 OF 36