
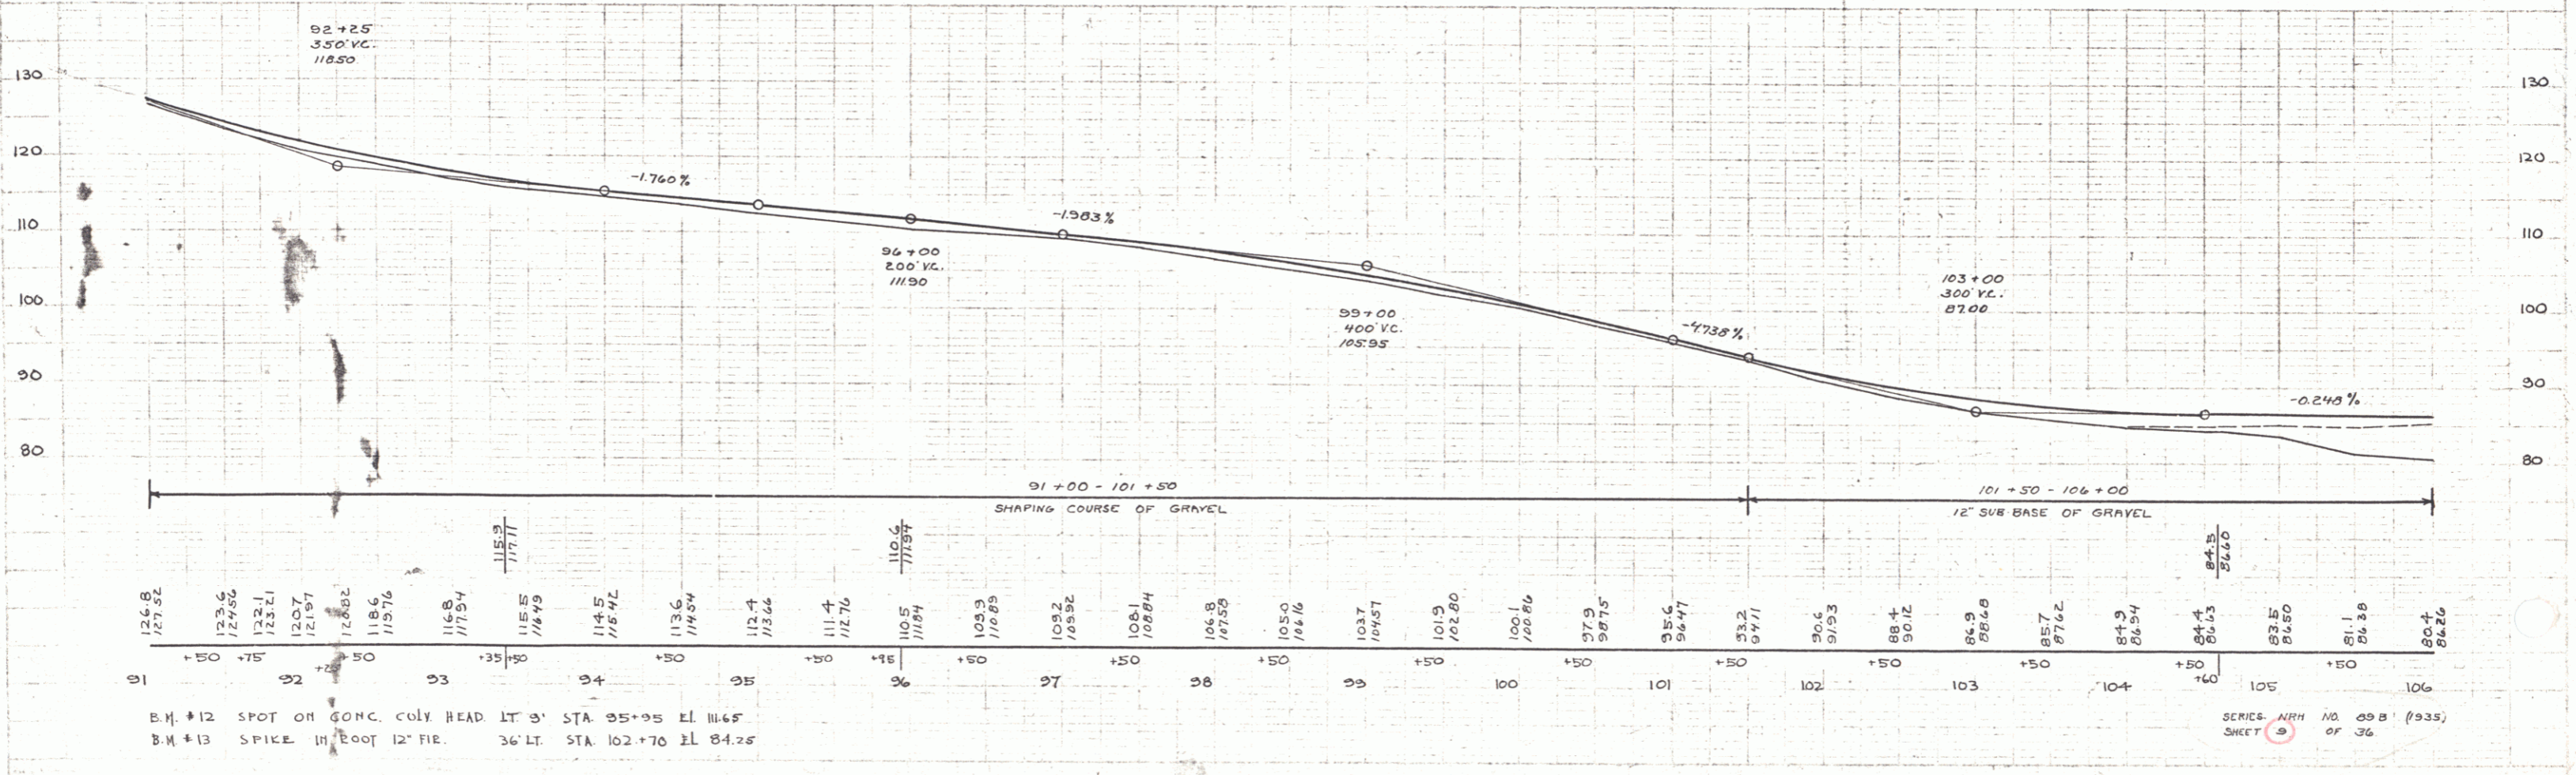


Parcel	Kind of Instrument	Date of Grant	Grantor	Grantee	Recorded	Remarks
068	CCD	11-27-34	F. Ufford	Shof H	19 3173	12-11-34

NEW YORK STATE PLD AND FISCAL SHEET
 PLD NO. 10374 9 36
 (1935)

POTNAM
 D. MACCHI 7/34
 TRACED

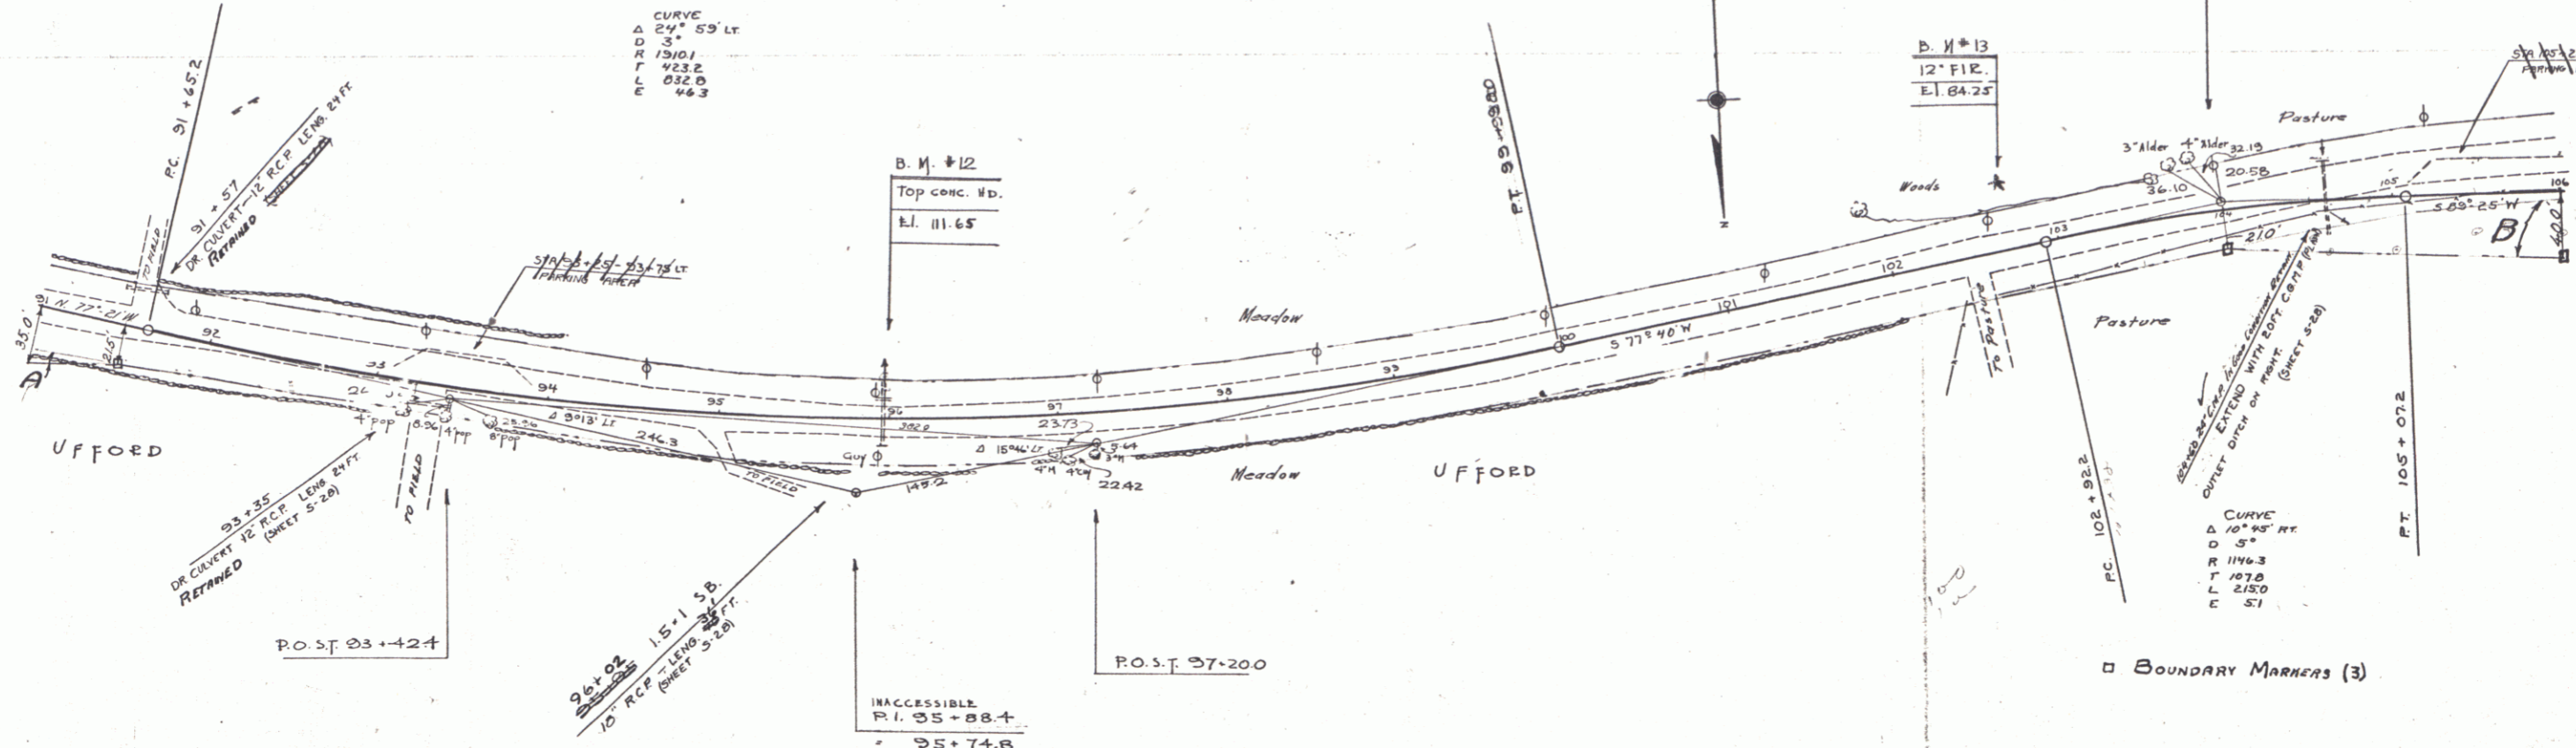

B.M. #12 SPOT ON CONC. CULY HEAD LT 3' STA 95+95 E.L. 111.65
 B.M. #13 SPIKE IN BOOT 12" FIR. 36" LT. STA 102+70 E.L. 84.25

SERIES WITH NO. 00 B (1935)
 SHEET 9 OF 36