
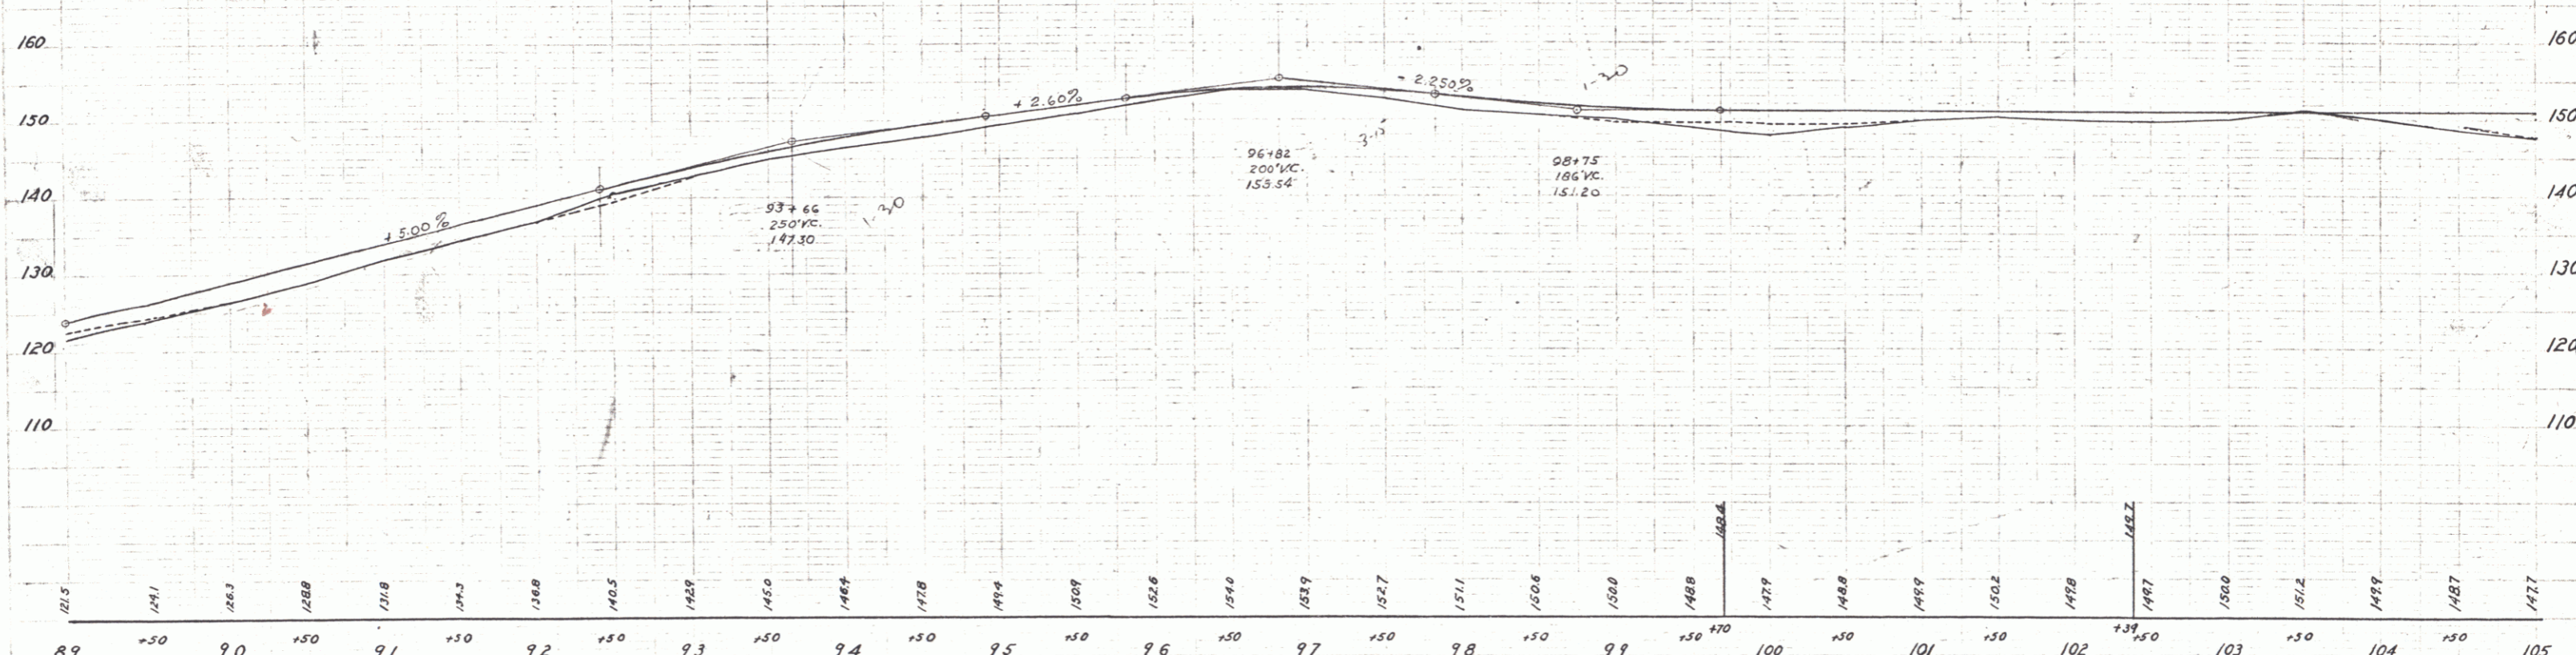


Parcel	Kind of Instrument	Date of Instrument	Grantor	Grantee	Recorded Book Page Date	Remarks
B, C, etc. #1	M.D.	11-25-33	B.E. Corliss	St of W.	19 867 12-2-33	Culr Sta 32+50
A	O.C.D.	11-23-33	Myron G. Waterman		19 845 12-2-33	

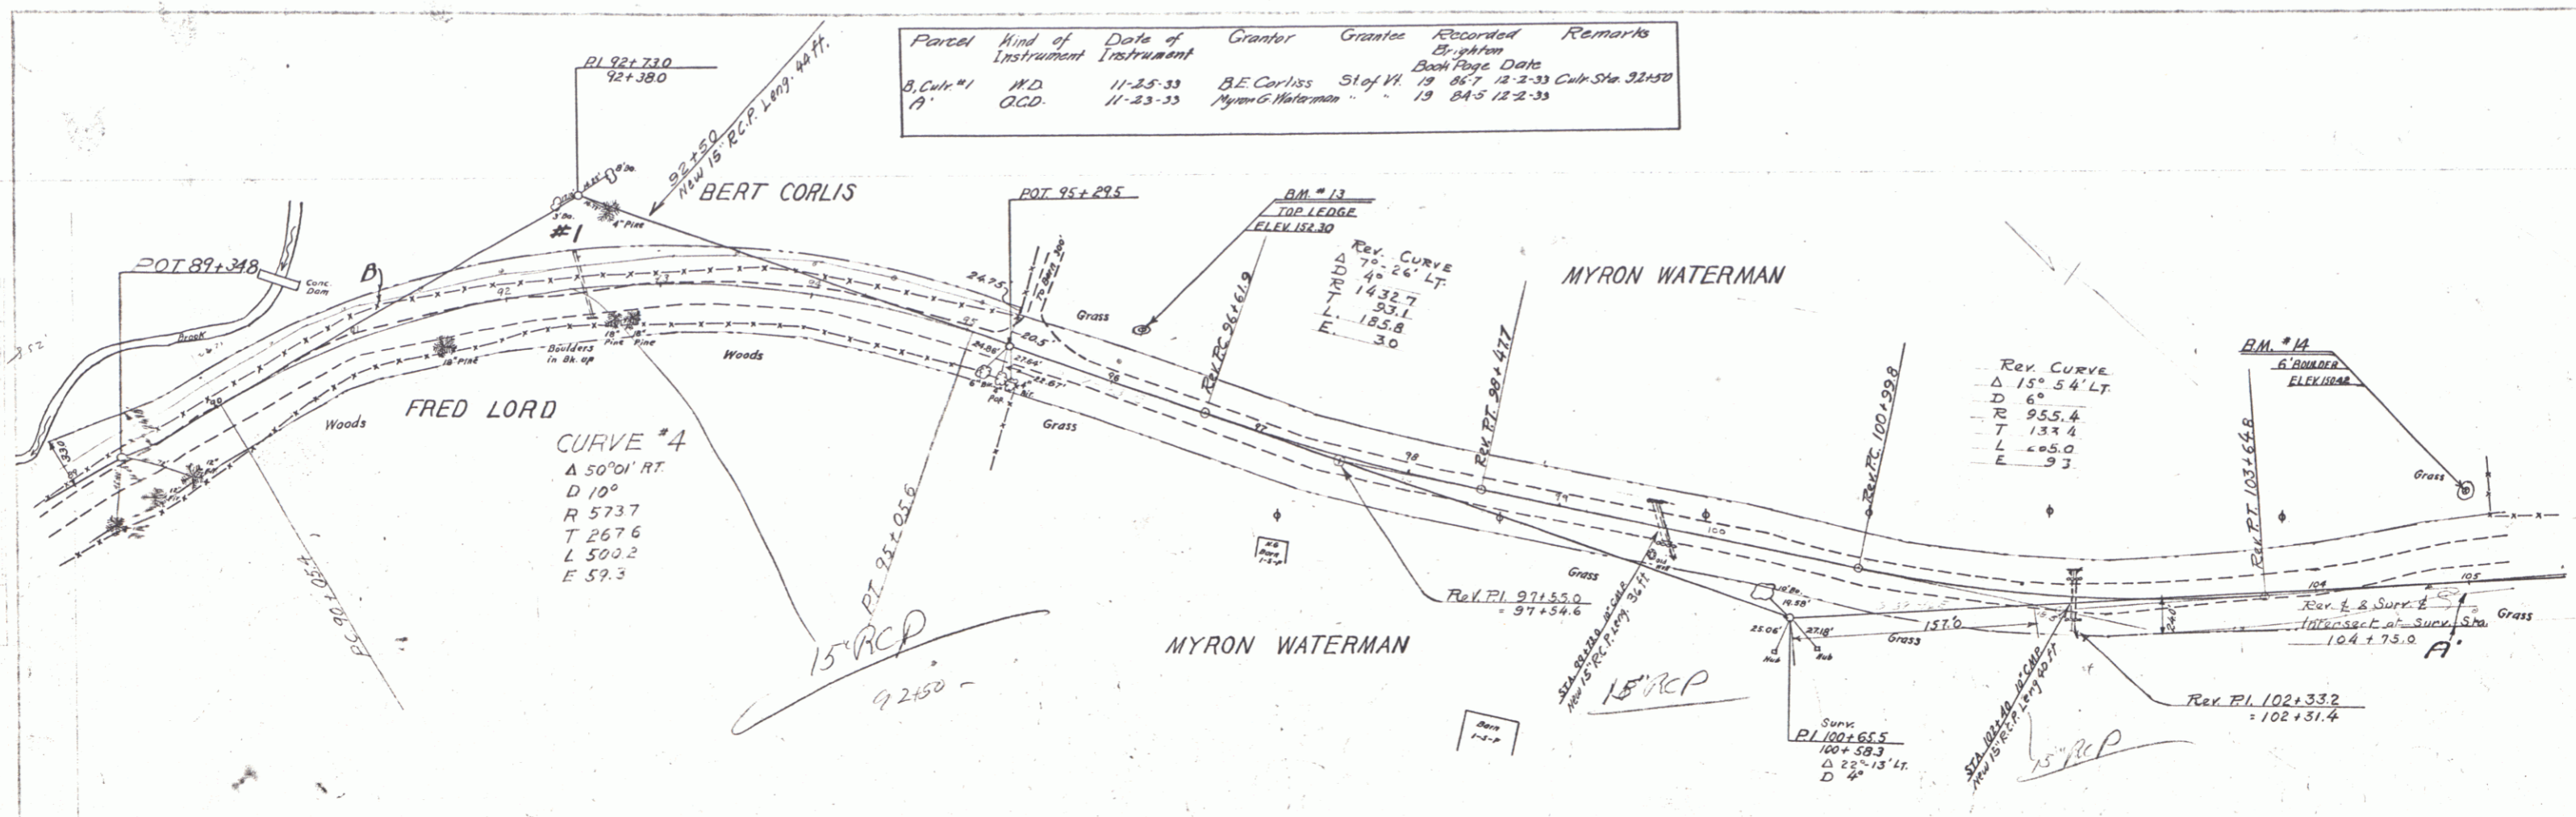

B.M. #13 SPOT ON LEDGE 38' LT OF STA. 96+06 ELEV. 152.30  
 B.M. #14 SPOT ON LEDGE 59' LT OF STA. 105+00 ELEV. 150.42