
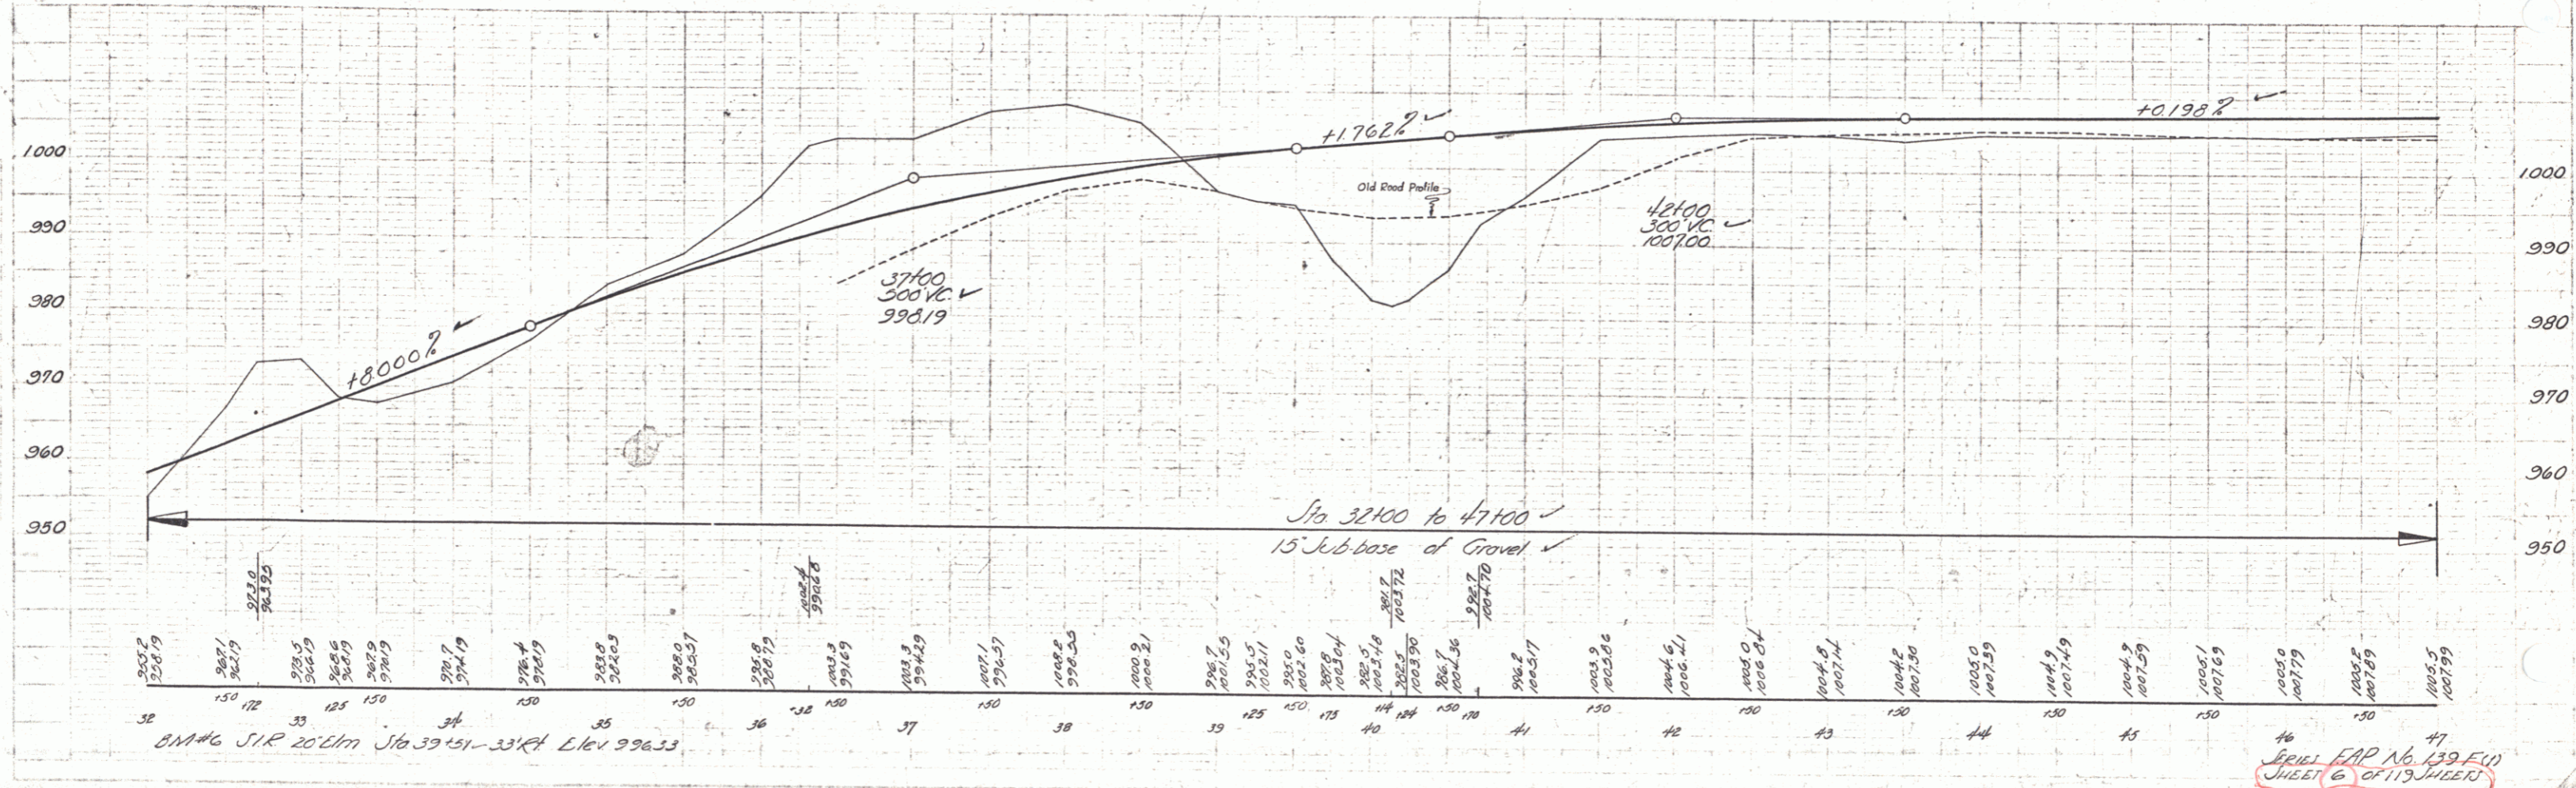


PARCEL	INSTRUMENT	DATE	GRANTOR	GRANTEE	RECORDED	REMARKS
B-C	W.DOE	8-1-40	VICTORIA GENDRON	ST OF VT	13	240-61-62 8-8-40
A	W.DOE	8-1-40	GEORGE & COUTURE	ST OF VT	13	236-57 8-8-40

FEBRUARY 1941
 13970 1241 G 112

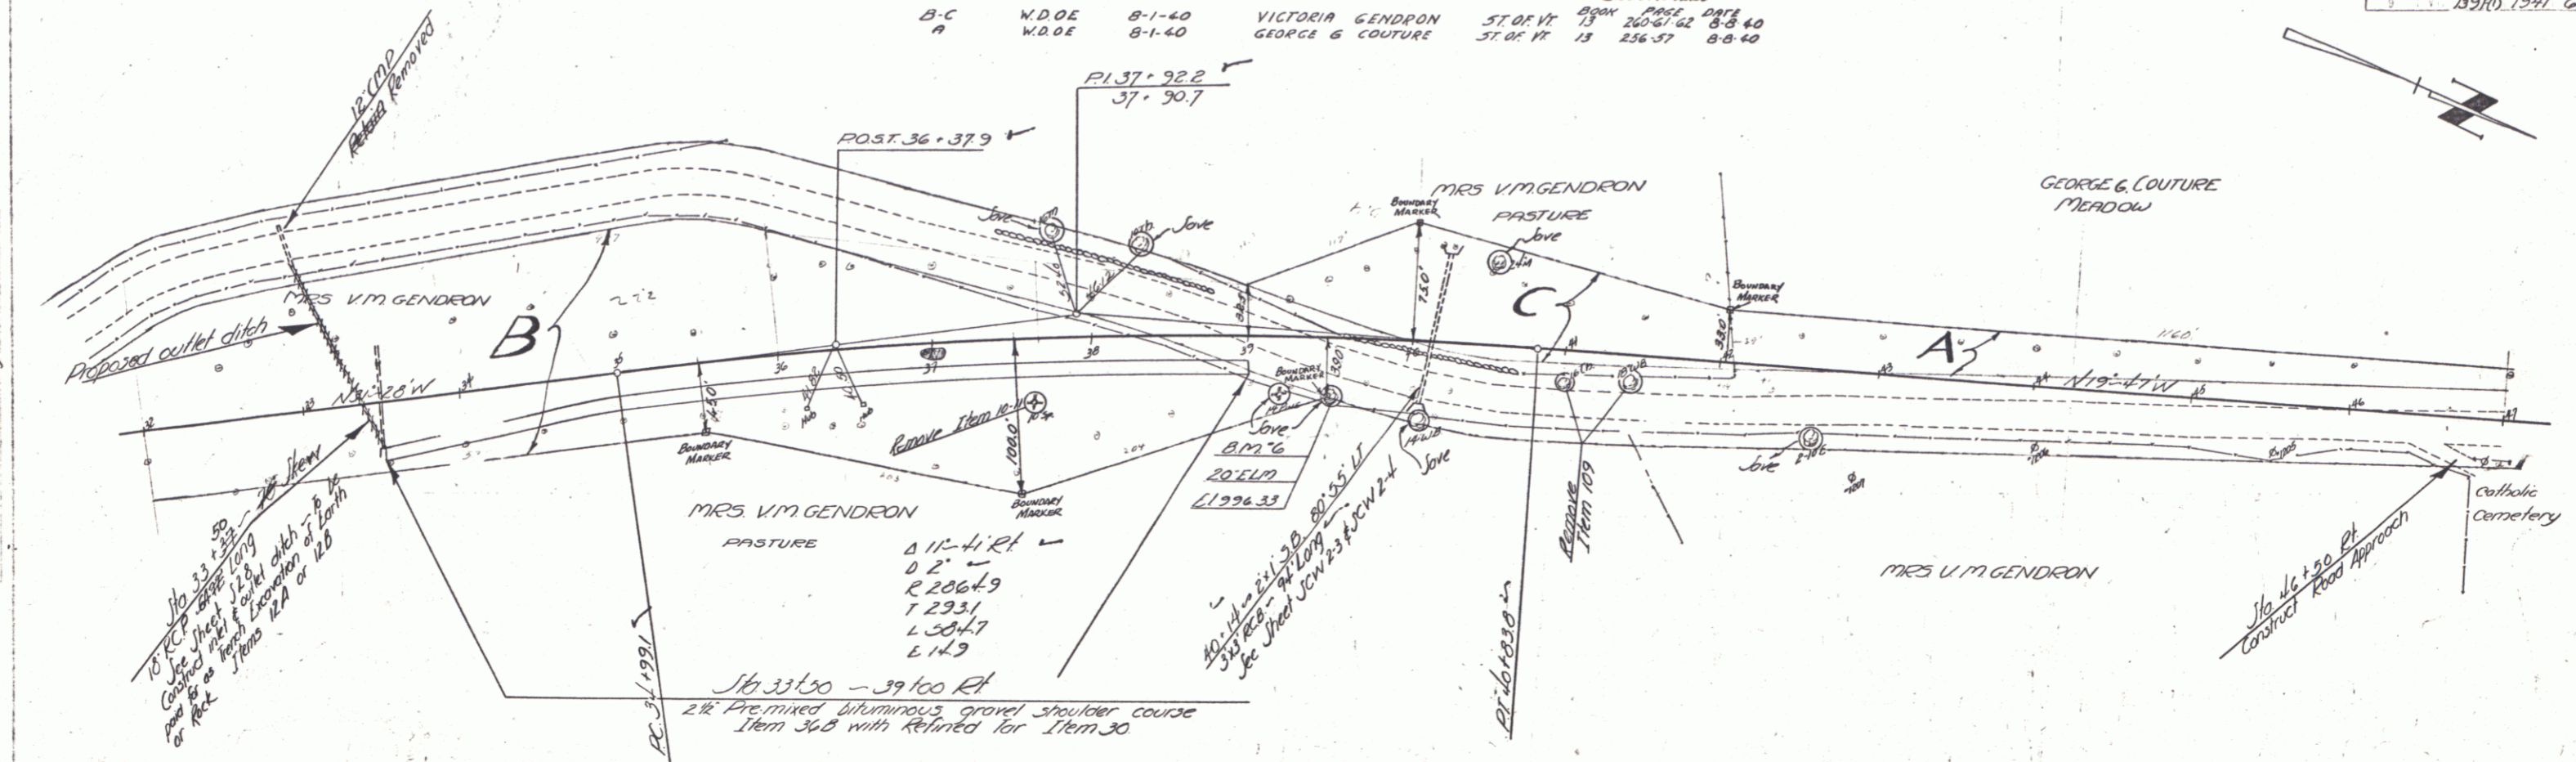

46 SERIAL MAP No. 139.F.111
 SHEET 6 OF 119 SHEETS