
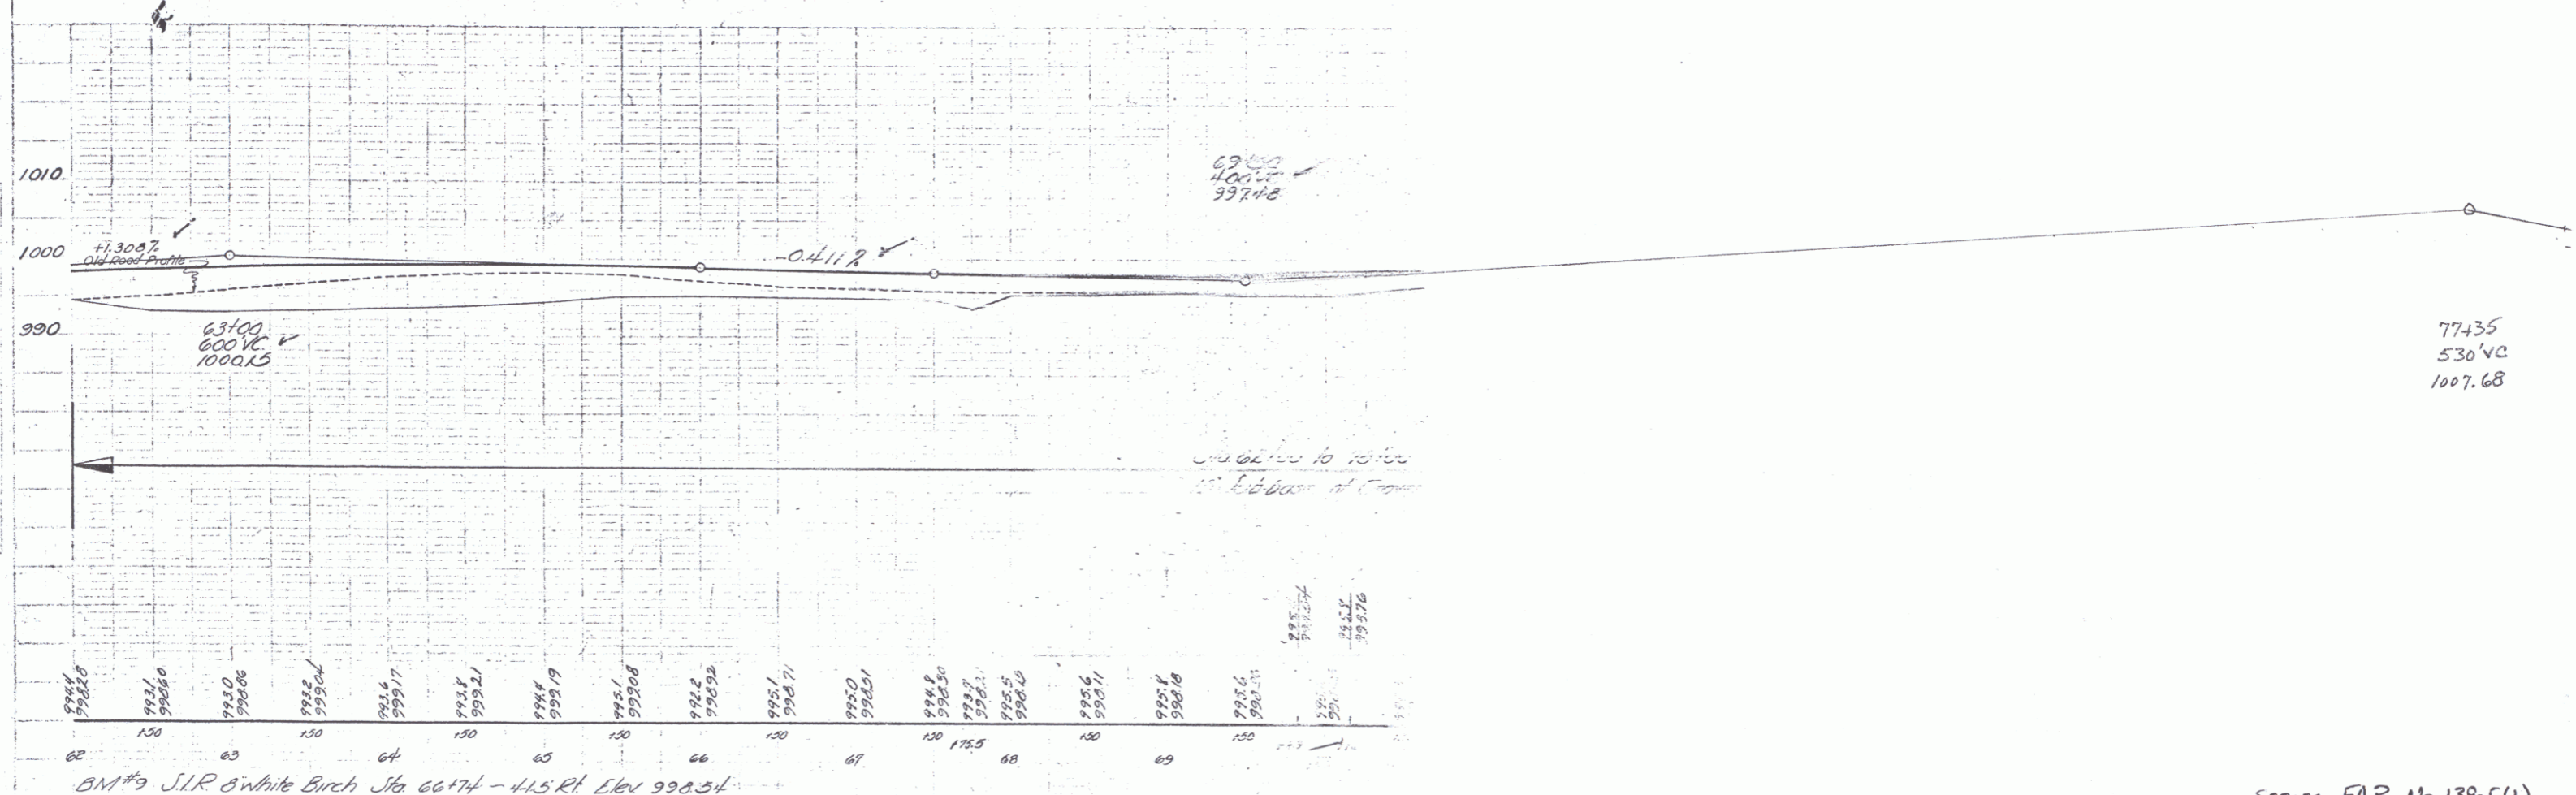


DATE	BY	CHECKED	BY
10/1/68	J. S. B.	J. S. B.	J. S. B.

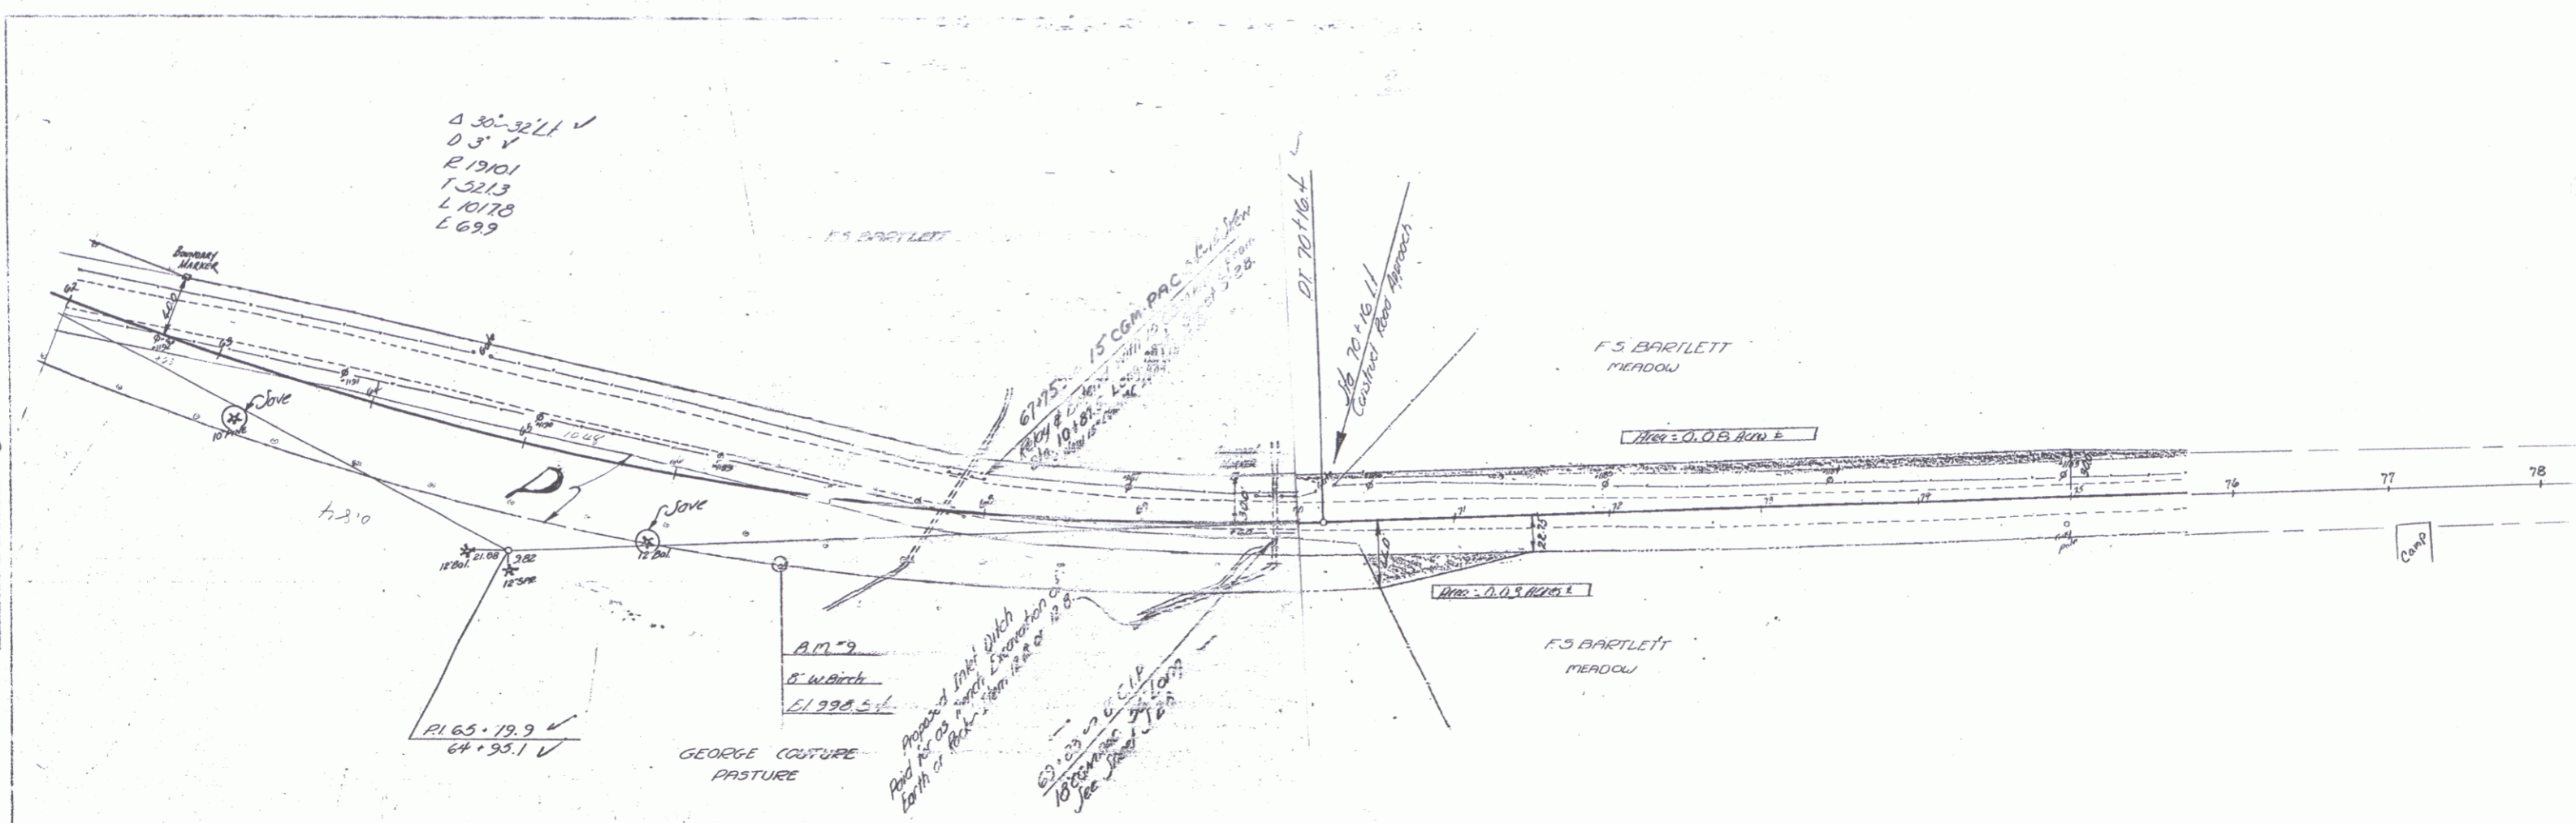

BM #9 S.I.R. @ White Birch Sta 66+74 - 41.5' RI Elev 998.54

SERIES FAP No 139-F(1)
SHEET 8 OF 119 SHEETS