
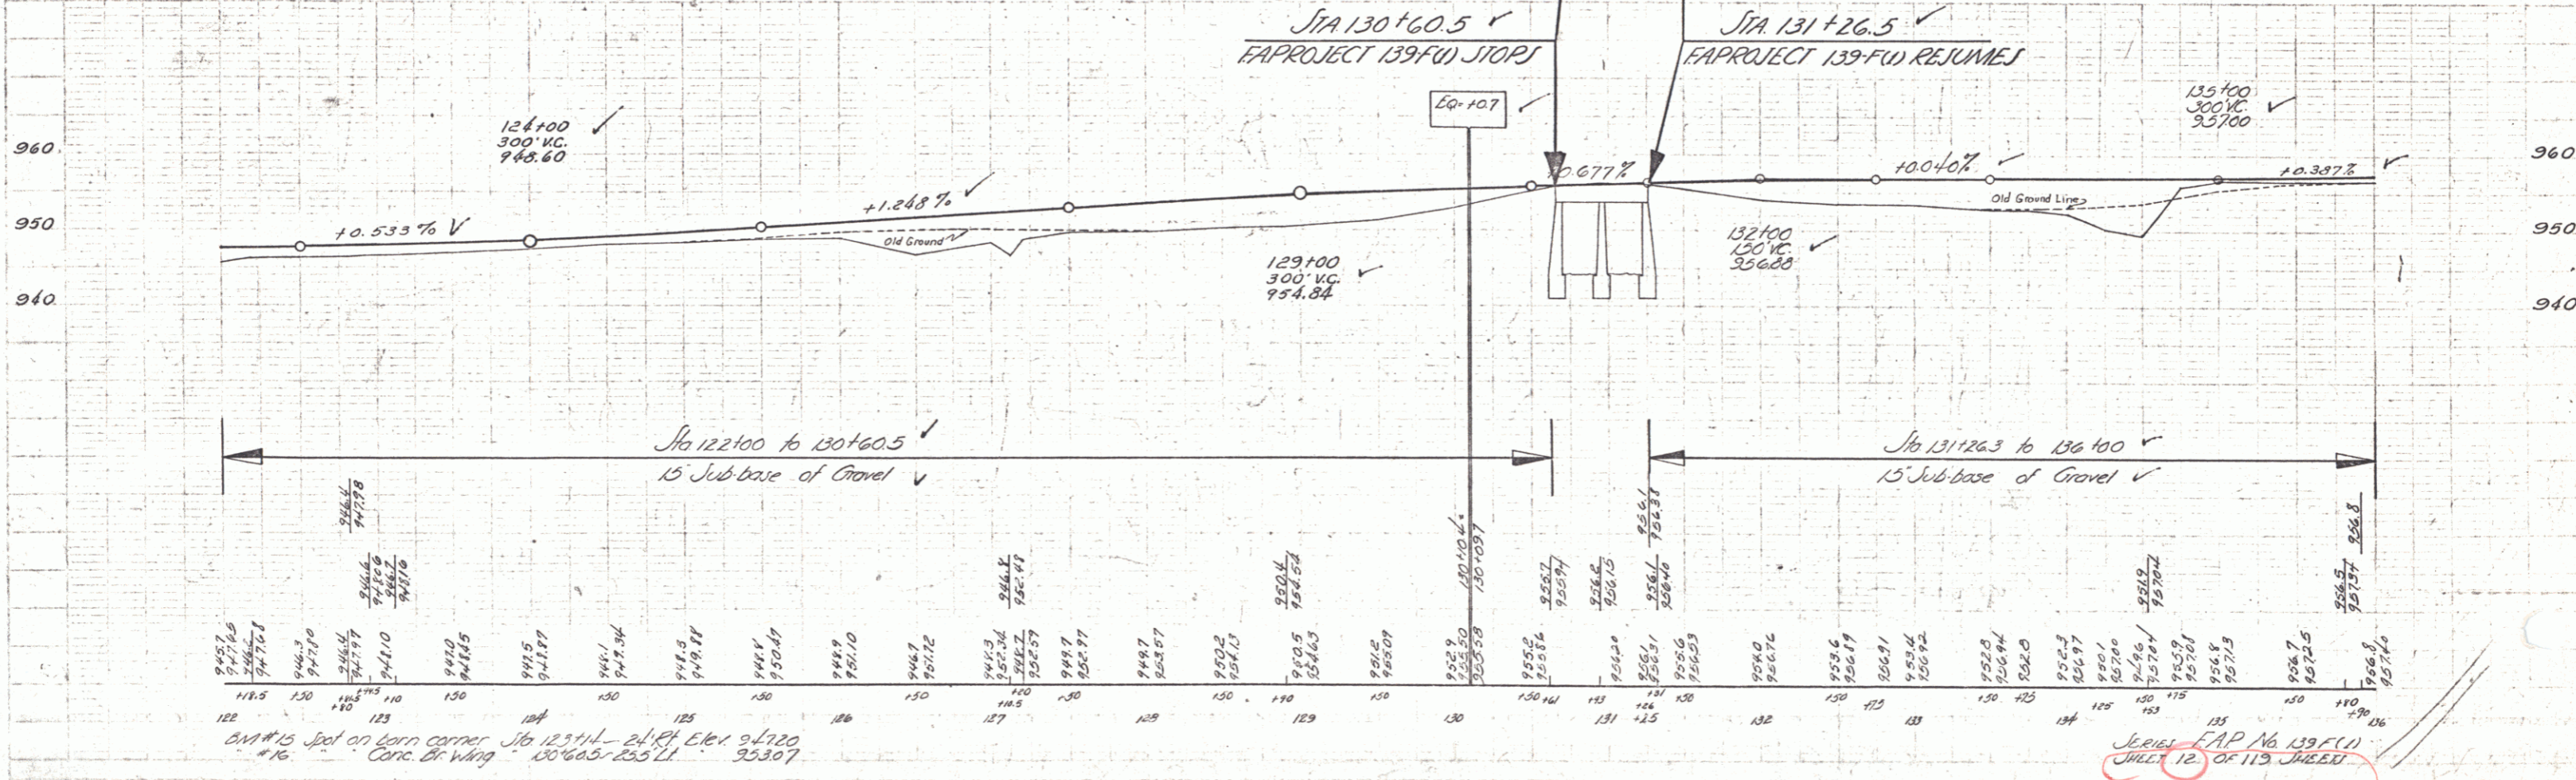


Parcel Ejectors  
152  
1740

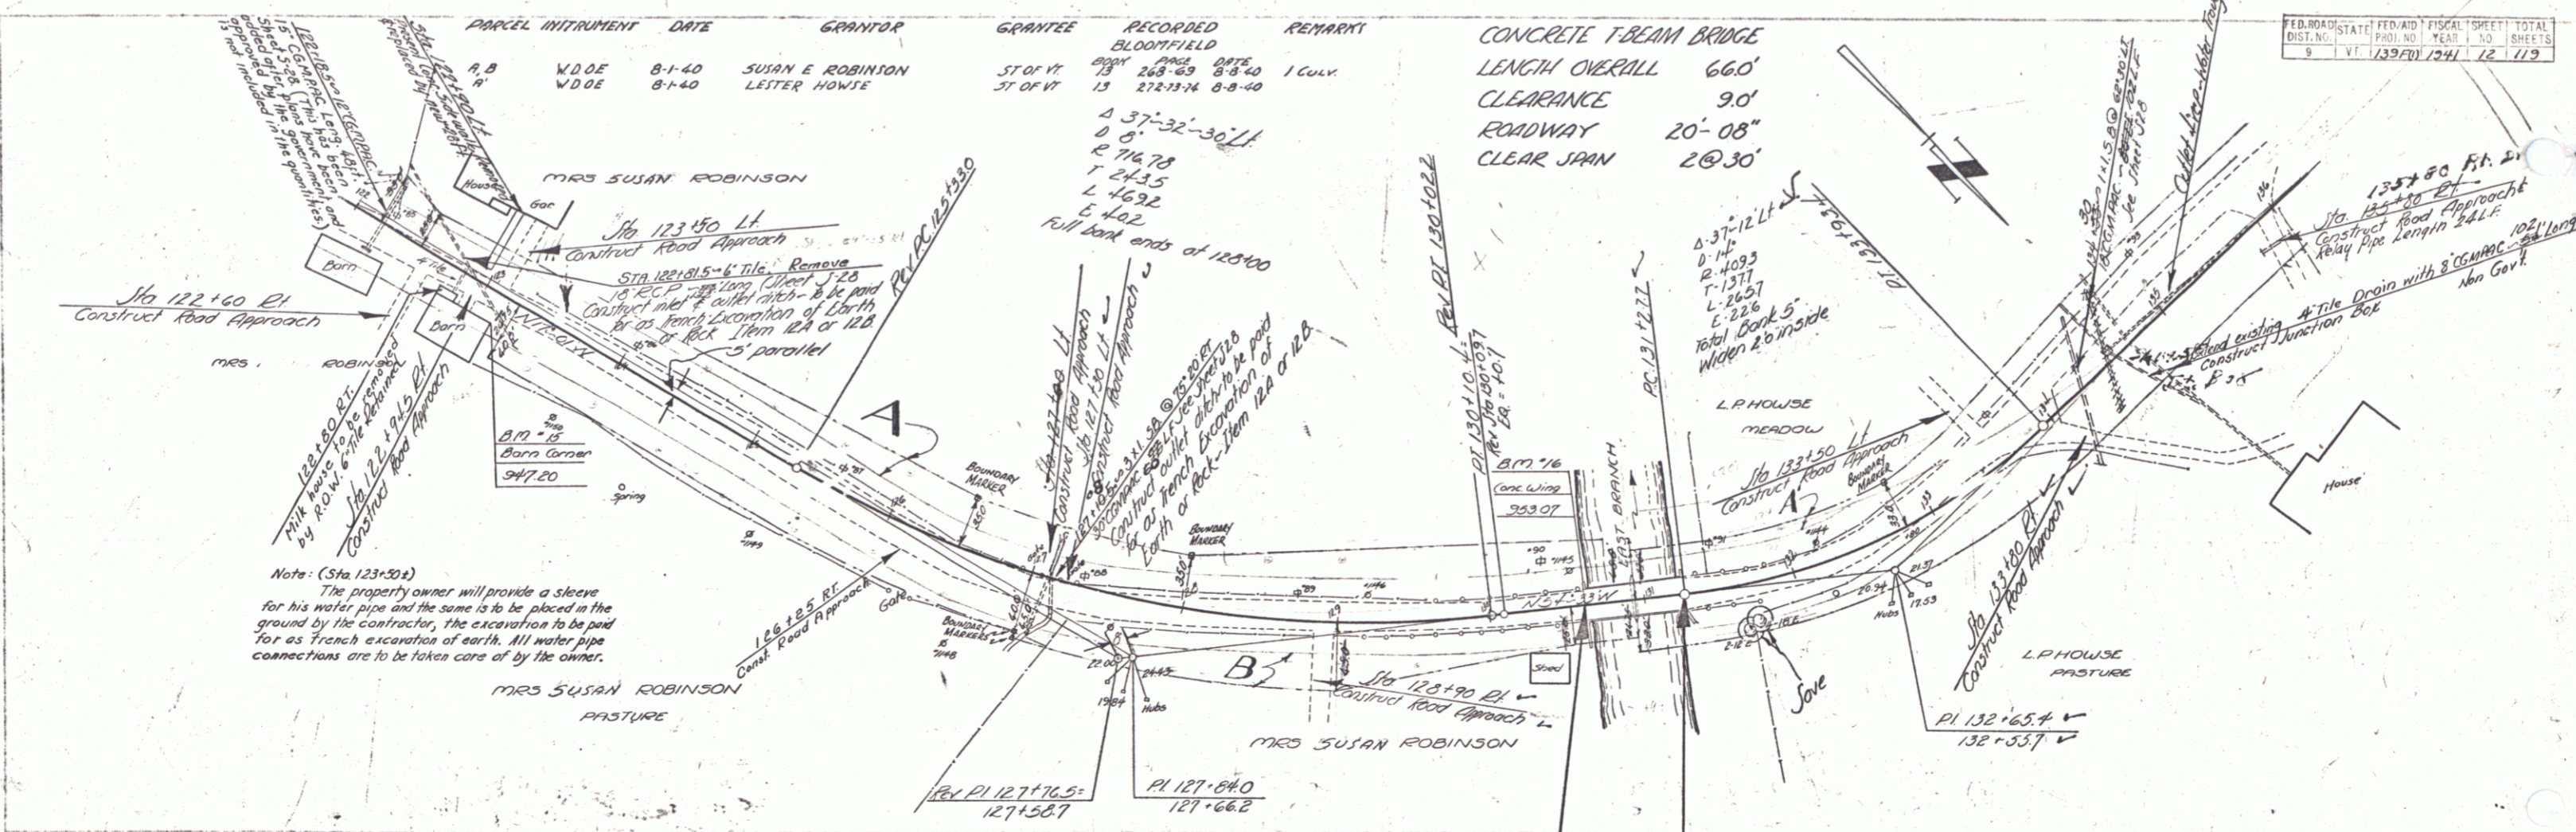

PARCEL INSTRUMENT	DATE	GRANTOR	GRANTEE	RECORDED	REMARKS
A.B.	8-1-40	SUSAN E. ROBINSON	ST OF VT	13	268-89 8-8-40 1 CULV
9	8-1-40	LETTER HOWE	ST OF VT	13	272-13-14 8-8-40

CONCRETE T-BEAM BRIDGE  
LENGTH OVERALL 660'  
CLEARANCE 9.0'  
ROADWAY 20'-08"  
CLEAR SPAN 20@30'

FED. ROAD DIST. NO.	STATE	FED. AID	FISCAL YEAR	SHEET NO.	TOTAL SHEETS
9	VT	139(FU)	1941	12	119

Note: (Sta 123+30±)  
The property owner will provide a sleeve for his water pipe and the same is to be placed in the ground by the contractor, the excavation to be paid for as trench excavation of earth. All water pipe connections are to be taken care of by the owner.

Q.M. to spot on barn corner Sta 123+11 - elev. 94720  
#16. Conc. Br. Wing Sta 130+60.5 - Elev. 95307

SERIES EAP No 139(FU)  
SHEET 12 OF 113 SHEETS