
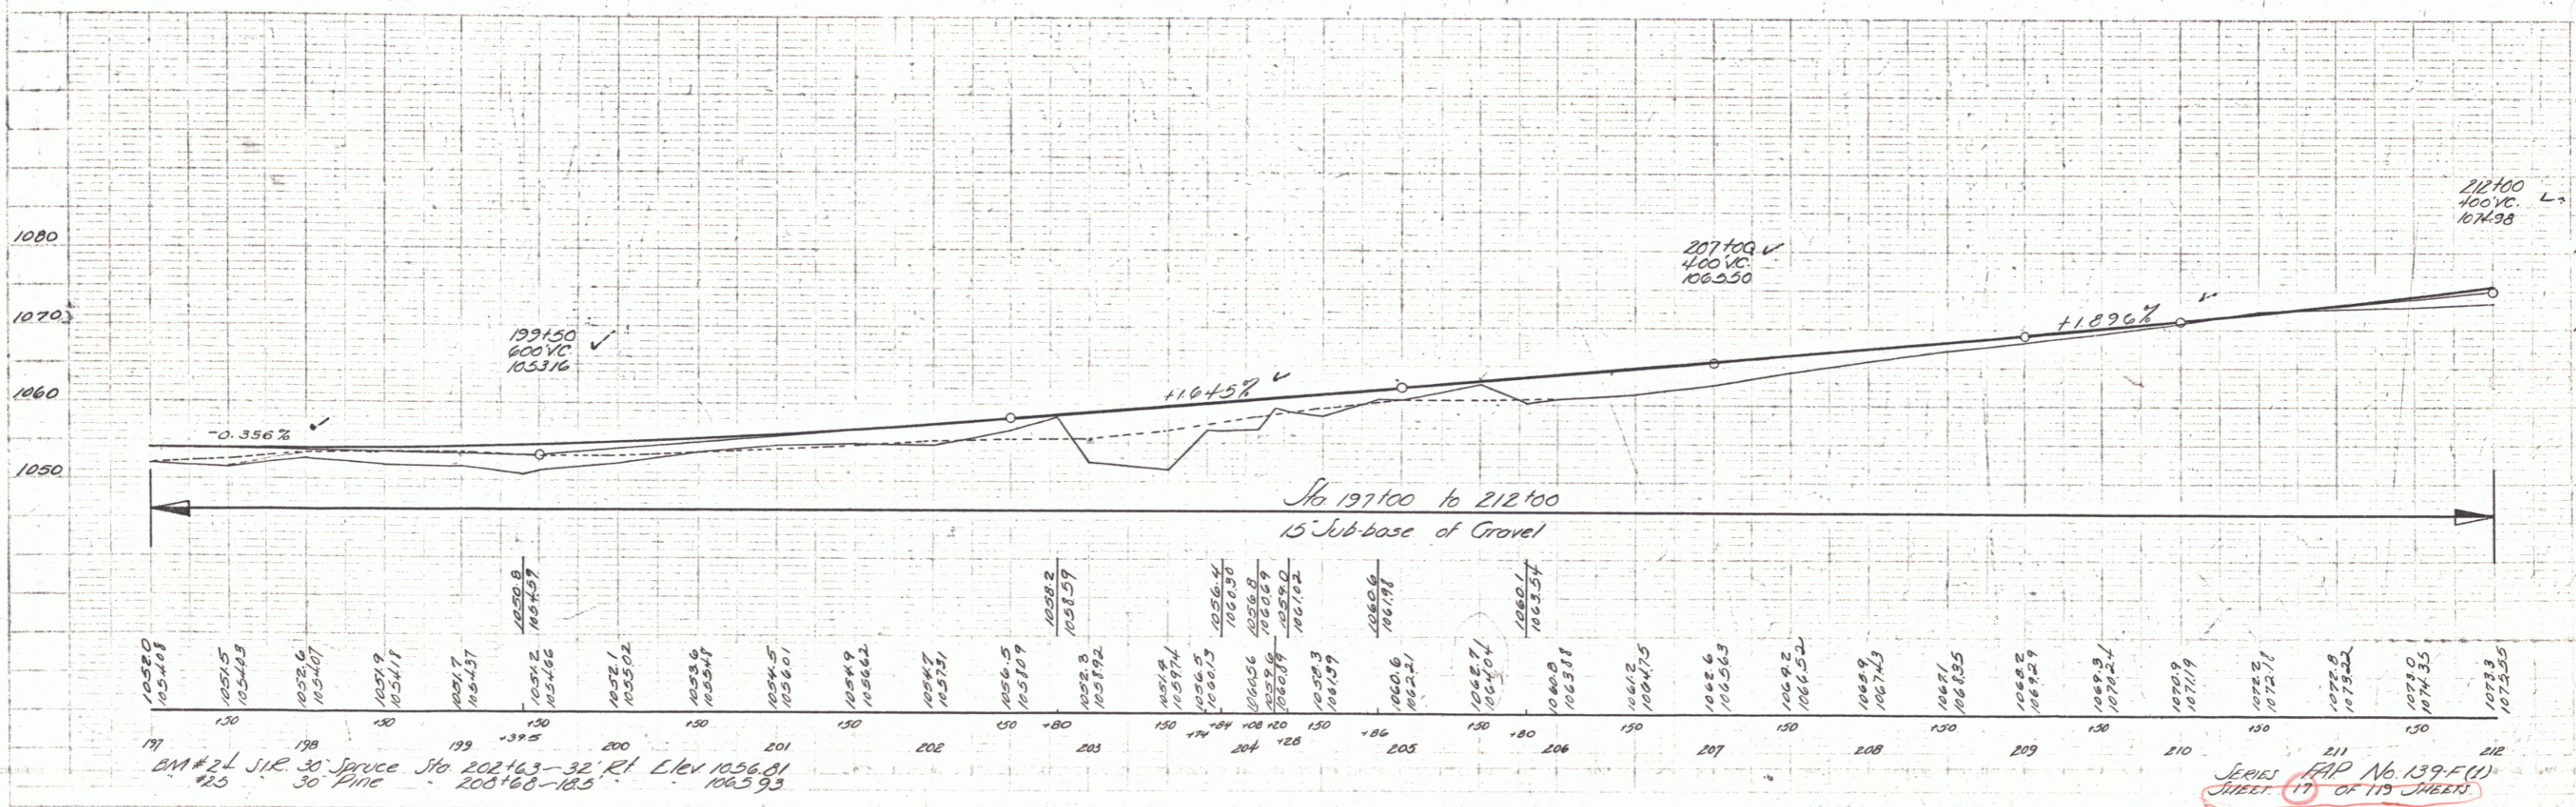


PARCEL INSTRUMENT DATE GRANTOR GRANTEE RECORDED BLOOMFIELD  
 D.E. A.C.D. 8-2-40 N.H. VT LUMBER CO STORVY 13 281-284 8-24-40

Note: Sta 200+00 to 212+00  
 Clearing and Grubbing Item 13  
 Payment line to be determined by  
 engineer in field

STATE OF VERMONT  
 1941 17 112

Sheet  
 1 of 11  
 1/27  
 1/44  
 1/44  
 1/44

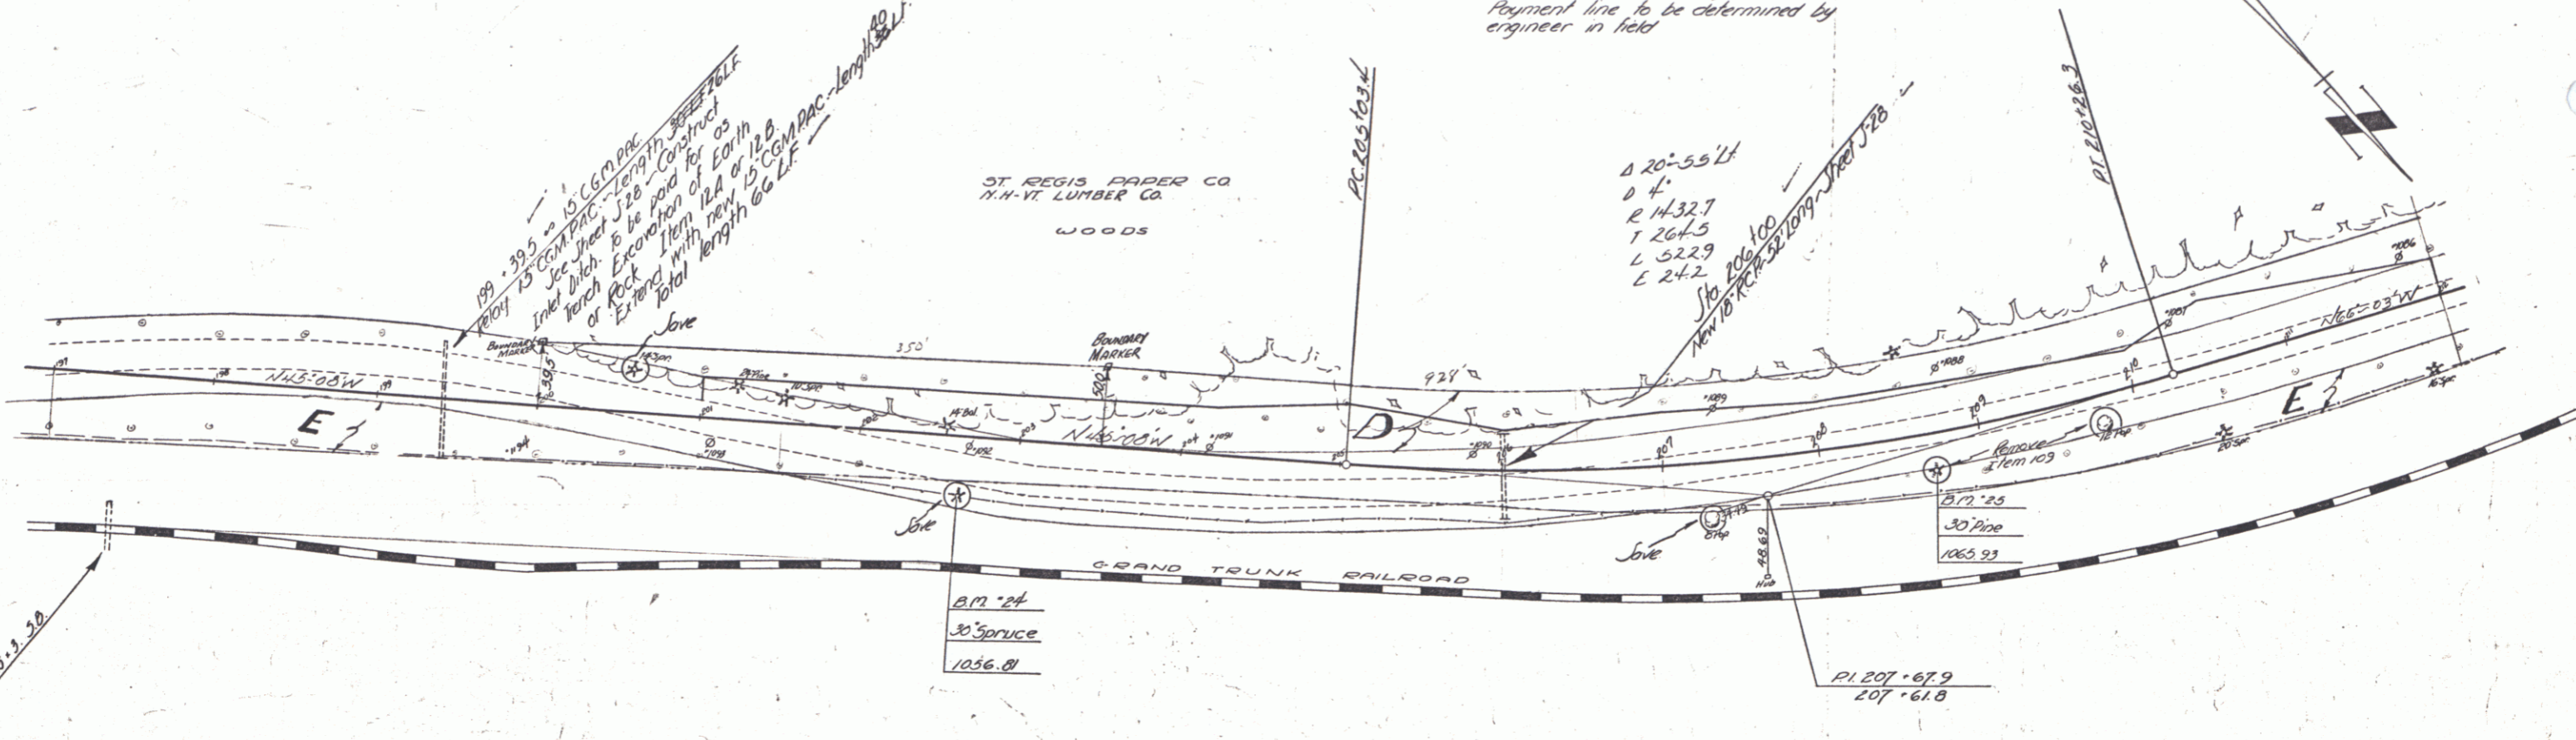

Series FAP No. 139-F(1)  
 Sheet 17 of 115 Sheets