

INDEX OF SHEETS


1	TITLE PAGE
2	DRAINAGE & ITEM QUANTITY SHEET
3	EARTHWORK & SUMMARY SHEET
4-5	R.O.W. DETAIL SHEETS
6	PLAN, PROFILE, & TYPICAL SECTION
7	A-61 SOLID ROCK EXCAVATION 8/7/67 (R)
8	B-1 BANKING TABLES 7/17/67 (R)
9	B-5 TYPICAL SLOPE GRADING 3/10/65
10	B-6 MUCK EXCAVATION 3/10/65
11	B-10 EMBANKMENT ON A SLOPE 3/10/65
12	B-11 METHODS OF STABILIZATION 3/10/65
13	D-2 CEMENT RUBBLE MASONRY 7/25/67 (R)
14	E-33 BRIDGE CONSTRUCTION APPROACH SIGNS 1/6/67
15	E-36 ROAD CONSTRUCTION SIGNS BETTERMENT PROJECTS 1/24/68
16	G-1 HEAVY DUTY STEEL BEAM GUARD RAIL WITH STEEL POSTS (WITH HEAVY TYPE POSTS)
17	G-4 WOOD B STEEL MARKER POSTS 12/30/65 (R)
18	BLANK
19	BLANK
20-29	BRIDGE DETAIL SHEETS
30	BLANK
31	BLANK
32	BLANK
33	BLANK
34	BLANK
35	SCB-D1-67
36	SCB-D2-67
37	SCB-D4-67
38	SCB-D7-67
39	SCB-D8-67
40	SCB-D9-67
41	BLANK
42-48	MAINLINE SECTIONS
49-53	CHANNEL SECTIONS

STATE OF VERMONT
DEPARTMENT OF HIGHWAYS

PROPOSED IMPROVEMENT

TOWN OF BLOOMFIELD
COUNTY OF ESSEX
VT. ROUTE 105
BLOOMFIELD-ISLAND POND ROAD

Pin# 00R189

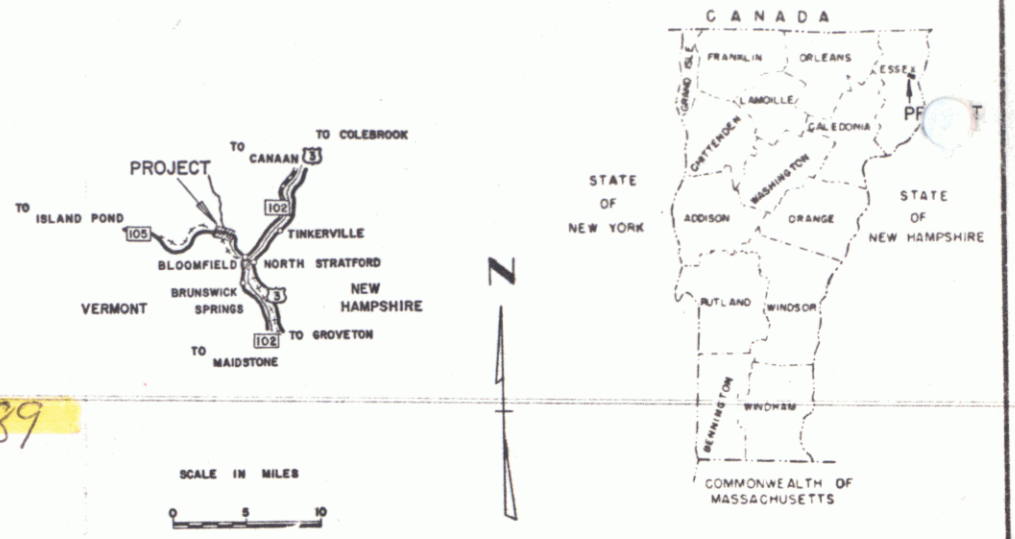


BEGINNING AT A POINT 2.376 MILES WESTERLY OF THE VERMONT - NEW HAMPSHIRE STATE LINE AND EXTENDING WESTERLY 0.256 MILE.

LENGTH OF ROADWAY 1265.96 FEET = 0.240 MILE.
LENGTH OF BRIDGE 84.04 FEET = 0.016 MILE.
LENGTH OF PROJECT 1350.00 FEET = 0.256 MILE.

ADT 1966	560
ADT 1968	598
ADT 1969	925
DHV 1969	125
D	32%
T	4%
V	50 MPH.

BLOOMFIELD
PROJECT
BB 034-3-6690
Composite - Wide Flange Beam Bridge
CONTRACTOR
Blow & Co., Inc.
YEAR 1968
Location Beginning at a point 2.376 mi. westerly of the Vermont-New Hampshire State Line
2.07 extending westerly 0.256 mi.

PROJECT NAME & NUMBER
BLOOMFIELD 034-3-6690
RECORD PLANS
A.A. Piché
MATERIALS
CONCRETE CL. 4448 LAMARCHE SANGRAN CO.
STRUCTURAL STEEL VERMONT STRUCTURAL STEEL CO.
REINFORCING STEEL Bethlehem Steel Co. (Long) N.Y.

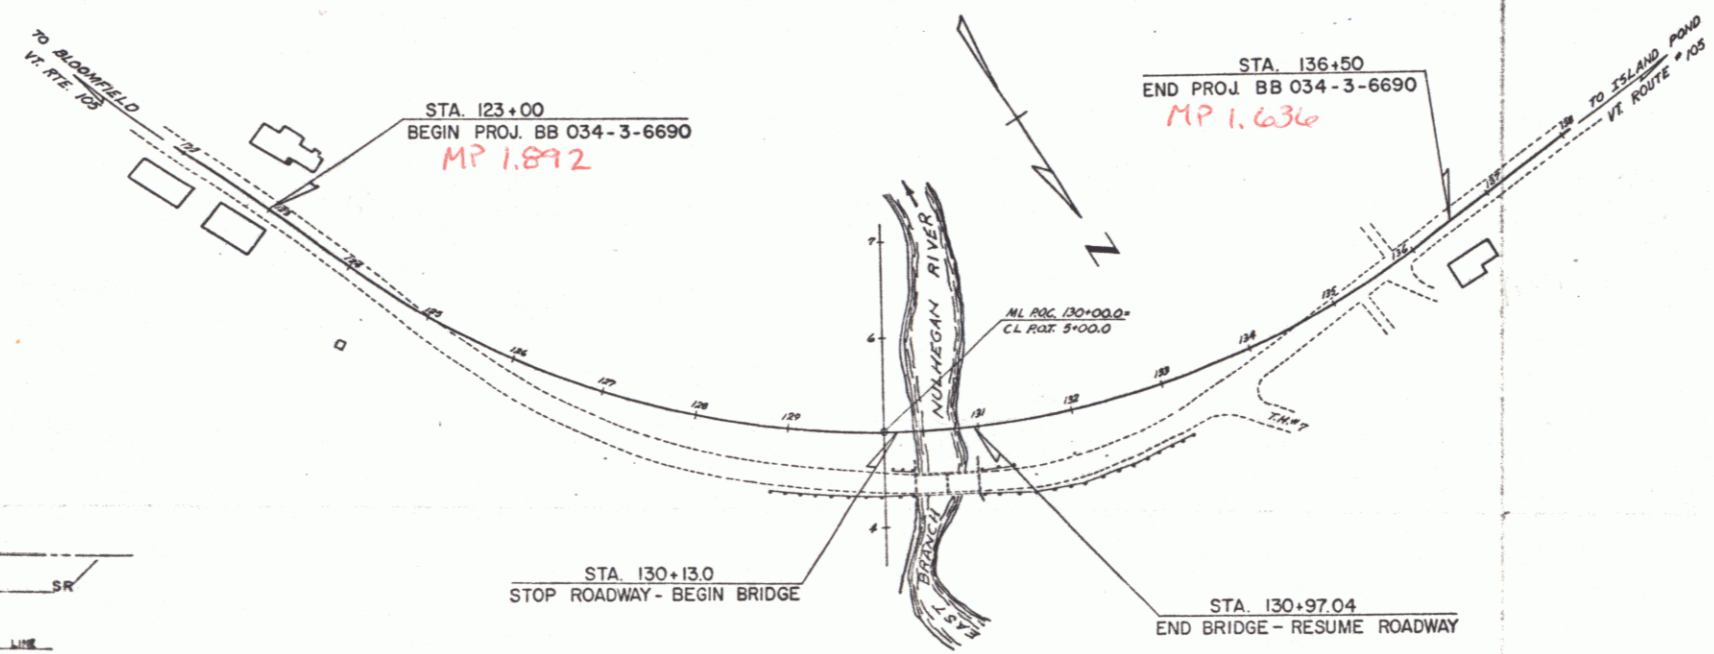

CONVENTIONAL SIGNS

POINT OF ACCESS	X
LIMITS OF ACCESS	---
COUNTY LINE	---
TOWN LINE	---
FENCE LINE	---
STONE WALL	---
UNFENCED PROPERTY	---
GUARD RAIL	---
TRAVELED WAY	---
RAILROAD	---
RETAINING WALL	---
CLIFFER LINE	---
SURVEY LINE	---
CULVERT	---
DRAIN PIPE	---
PROJECT POLE	---
POWER POLE	---
TELEPHONE POLE	---
TRAILS	---
WEDGE	---
F.A. CONSTRUCTION IDENTIFICATION SIGNS	A

SLOPE RIGHTS

SR


GROUND ELEVATION

GRADE ELEVATION

CURVE DATA

DEFLECTION OF ANGLE	Δ
DEGREE OF CURVE	D
RADIUS OF CURVE	R
TANGENT DISTANCE	T
LENGTH OF CURVE	L
EXTERNAL DISTANCE	E
POINT OF INTERSECTION	P.I.
POINT OF CURVE	P.C.
POINT OF TANGENT	P.T.
POINT ON TANGENT	P.O.T.
POINT ON SUB-TANGENT	P.O.S.T.
ROW LIMITS	---

FOR RIGHT OF WAY DETAILS, SEE RIGHT OF WAY PLANS FOR THIS PROJECT.

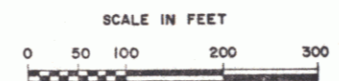

THESE PLANS ARE SUBJECT TO SUCH REVISIONS AS MAY BE REQUIRED BY THE BUREAU OF PUBLIC ROADS OR THE COMMISSIONER OF HIGHWAYS.

CONSTRUCTION IS TO BE CARRIED ON IN ACCORDANCE WITH THESE PLANS AND THE STANDARD SPECIFICATIONS FOR HIGHWAY AND BRIDGE CONSTRUCTION DATED APRIL 1964, AS APPROVED BY THE BUREAU OF PUBLIC ROADS ON OCTOBER 12, 1964, INCLUDING ALL SUBSEQUENT APPROVED REVISIONS AND SUCH REVISED SPECIFICATIONS AND SPECIAL PROVISIONS AS ARE INCORPORATED IN THESE PLANS.

APPROVED ROW DIRECTOR DATE 5-29-68	APPROVED DISTRICT ENGINEER DATE 28 May 1968	APPROVED CONSULTING ENG. DATE 27 May 1968	APPROVED SENIOR ENGINEER DATE 3/27/68	APPROVED DATE 6/3/68	APPROVED DATE 6/3/68	APPROVED DATE 6/3/68
--	---	---	---	-------------------------	-------------------------	-------------------------

DEPARTMENT OF COMMERCE
BUREAU OF PUBLIC ROADS

APPROVED

DIVISION ENGINEER DATE

PROJECT BB NO. 034-3-6690

SHEET 1 OF 53 SHEETS