


POOR ORIGINAL COPY

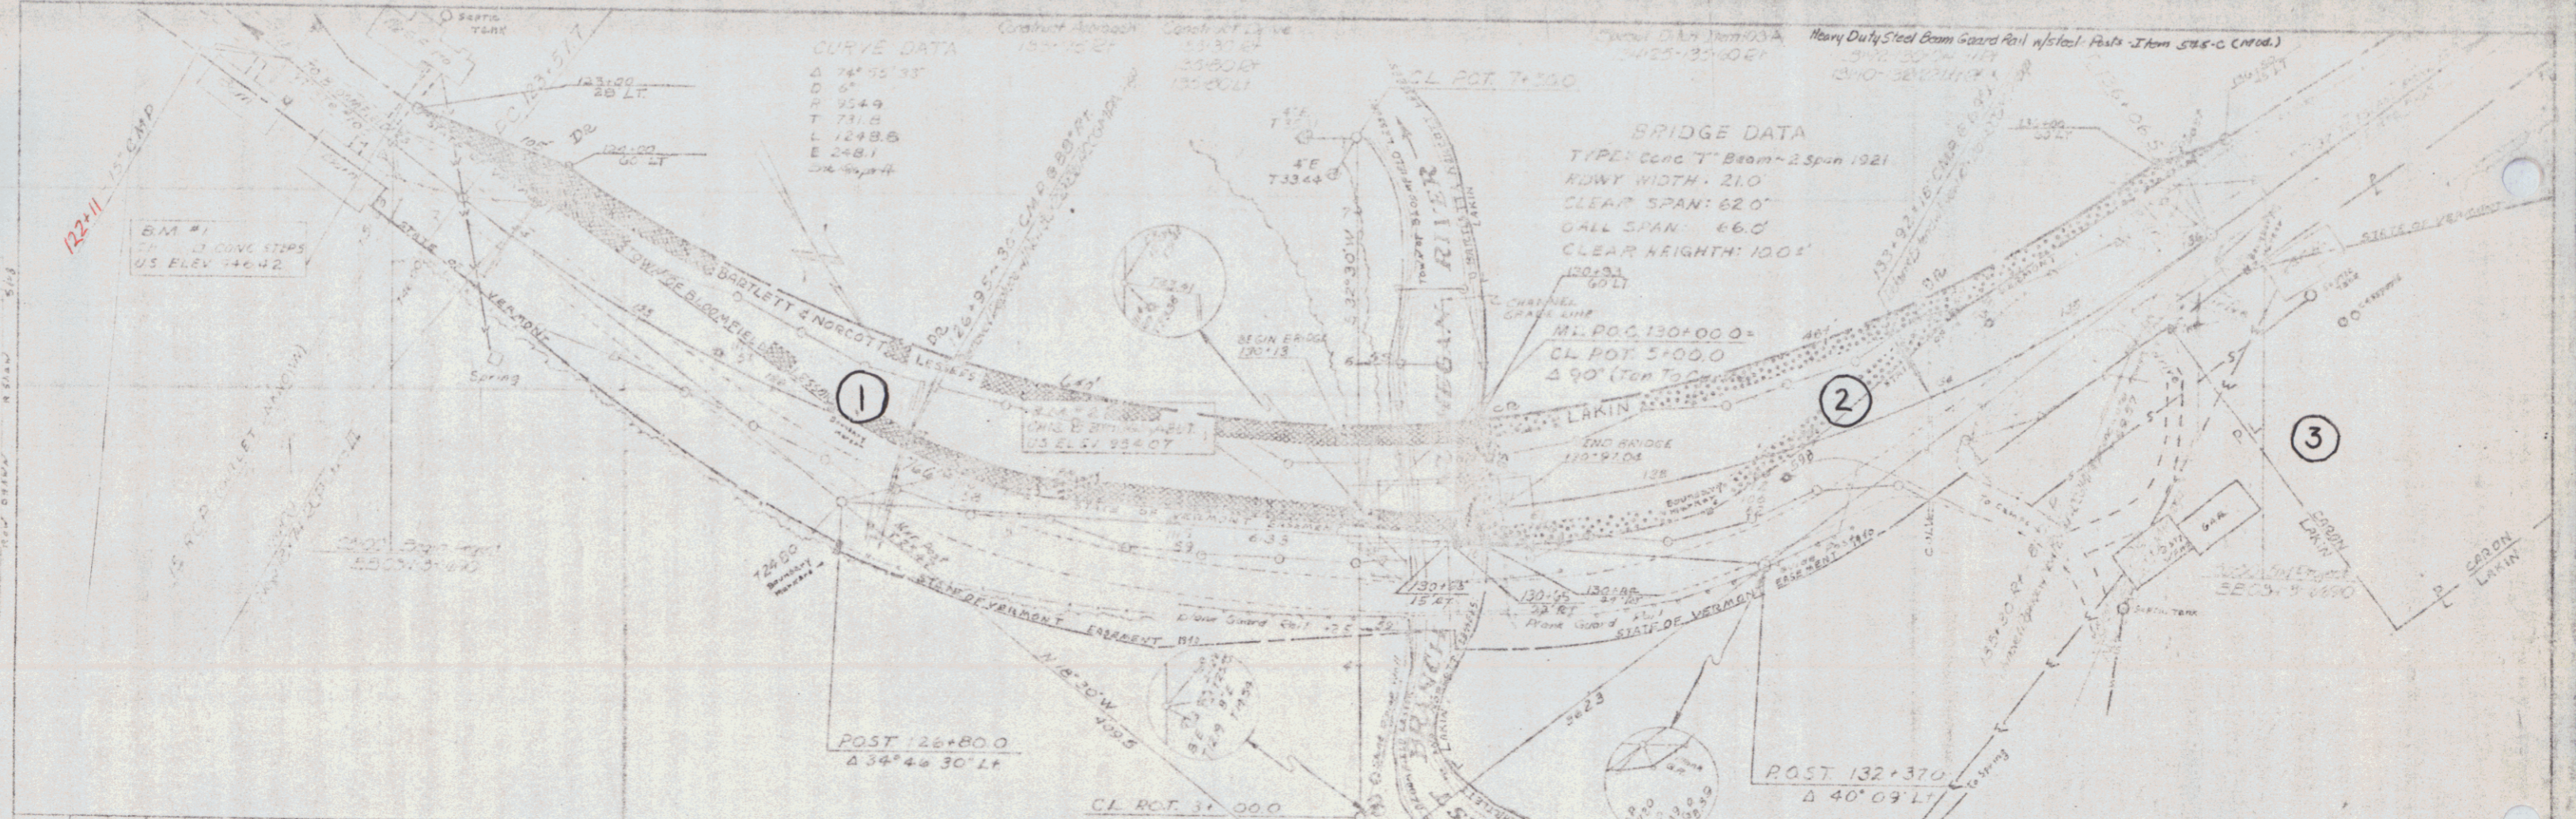

POOR ORIGINAL COPY

Sheet 6 of 53

4